
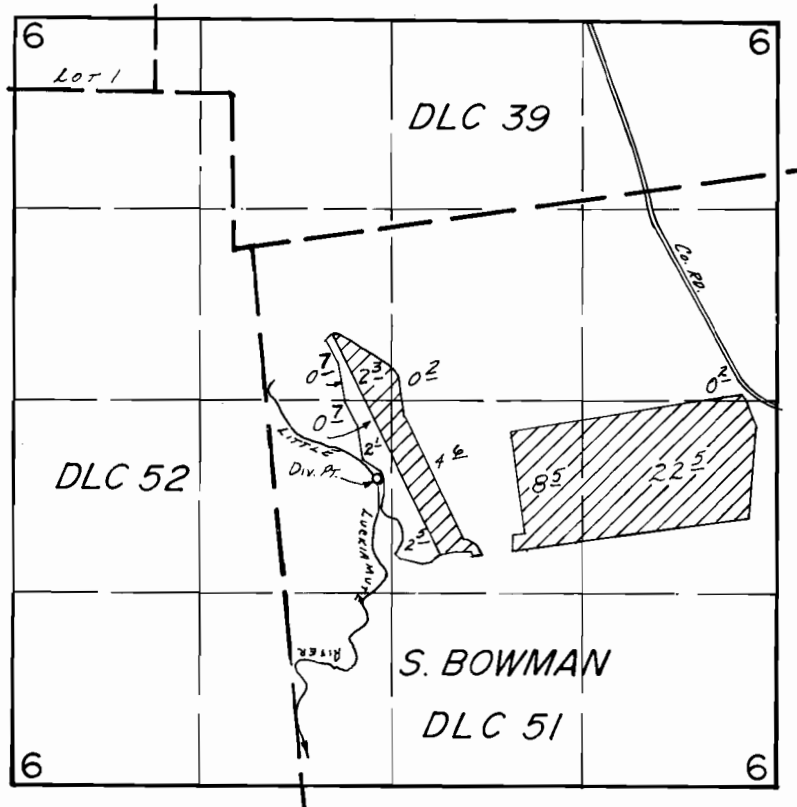


T. 9S., R. 5W., W.M.

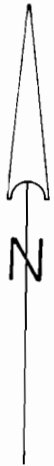

Div. Pt. Loc.: 1560'S. & 870'E. FROM NW COR. S. BOWMAN DLC 51.

SCALE: 1"=1320'

FINAL PROOF SURVEY UNDER

Application No. 60250.. Permit No. 45569.....
IN NAME OF

JERALD L. BUSH

Surveyed Aug. 8 & 10 1983, by L.M. TOLL.....