


T.4S.,R.8W.,W.M.

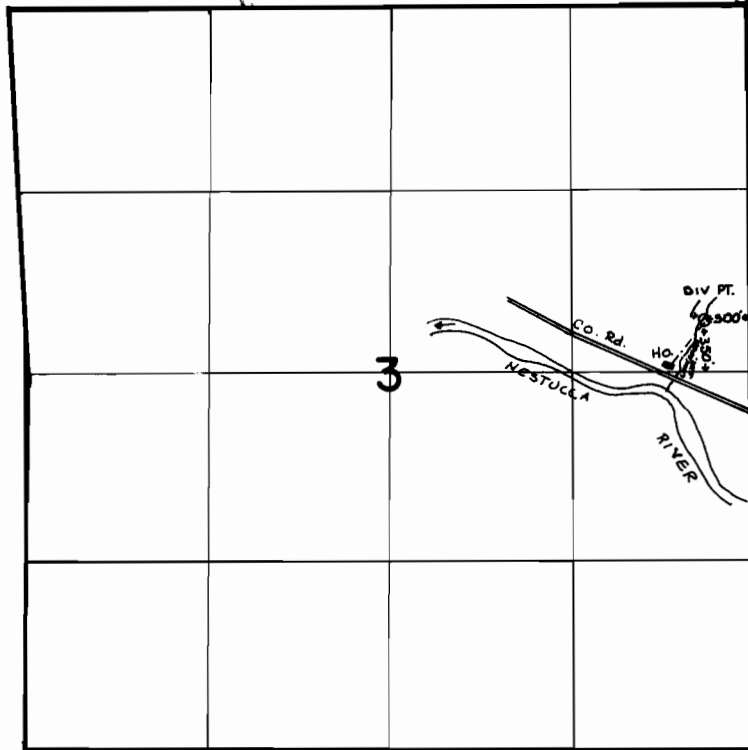

SCALE : 1" = 1320'

FINAL PROOF SURVEY
UNDER

Application No. ...61331... Permit No. ...45976.....

IN NAME OF

.....**JAMES M. LARREW**.....

Surveyed ..SEPT. 11.. 1984., by ..L. OLSON.....