T. 26 S., R. 4 W., W.M.

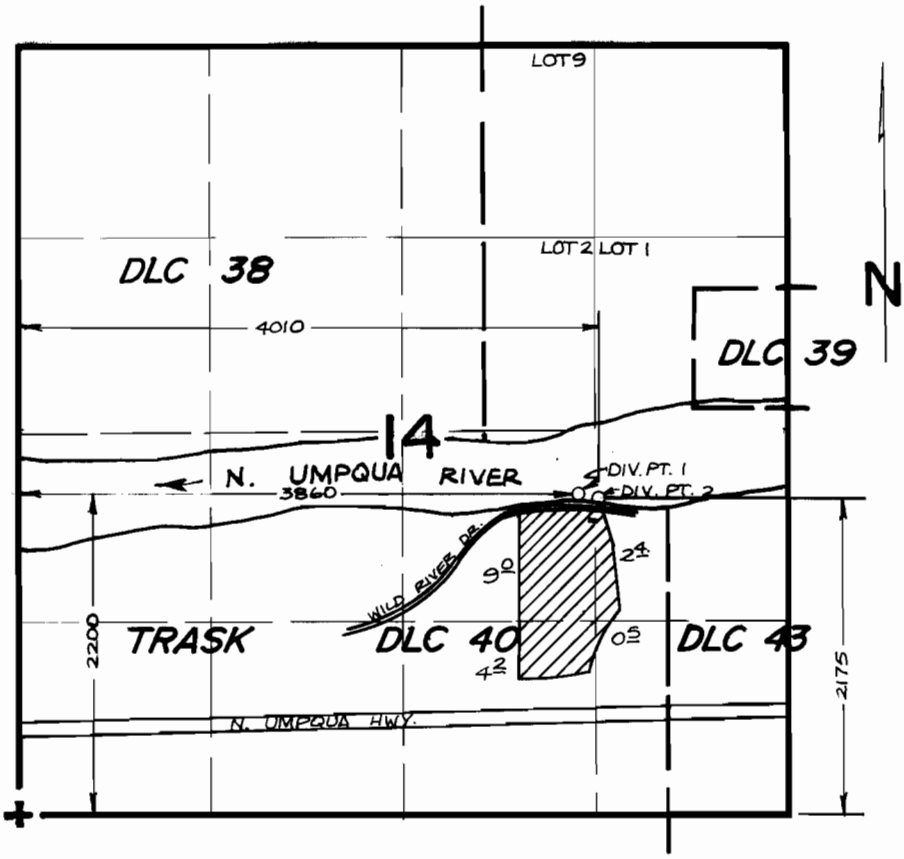

SCALE: 4" = 1 MILE

FINAL PROOF SURVEY
UNDER

Application No. 62175 Permit No. 46384
IN NAME OF

SUSAN CONNIE MITCHELL

Surveyed AUG. 24, 1984 SEPT. 10, 1986, by L.E. CASHION J.M. SCHMORDE

BTR - 5HH - 54 JMS