


T. 38 S., R. 14 W., W. M.

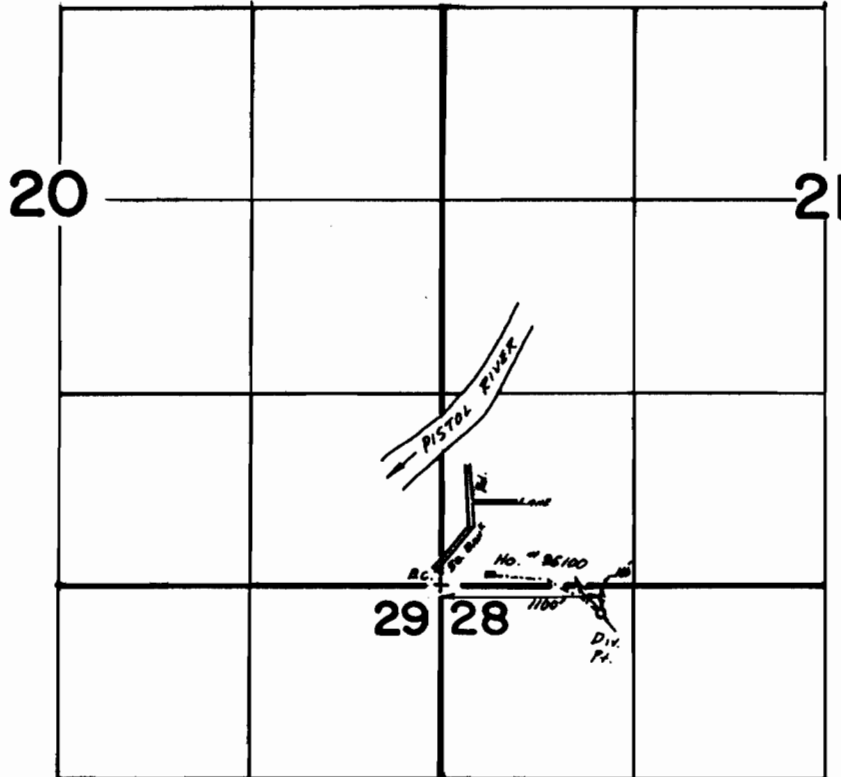

Scale 1" = 1320'



FINAL PROOF SURVEY
UNDER

Application No. 62180... Permit No. 46386...
IN NAME OF

.....LESLIE.....E.....STANSELL.....

Surveyed July 26, 1988, by B.S. JAMES.....