


T.3S.R.10W.W.M.

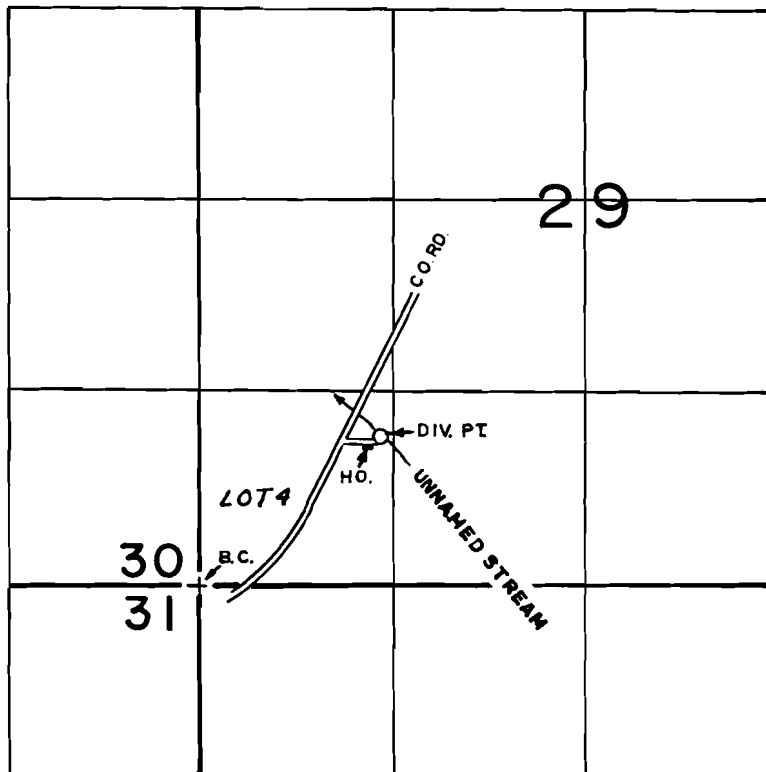

DIV. PT. LOC. 1020' N. & 1250' E. FROM S.W. COR. SEC. 29

FINAL PROOF SURVEY
UNDER

Application No. 54521... Permit No. 40890.....
IN NAME OF

JAMES NICK & TERESA H. DUSIC.....

Surveyed JAN. 25, 1980., by R.G. MUCKEN.....