T.1N., R.10E.,W.M.

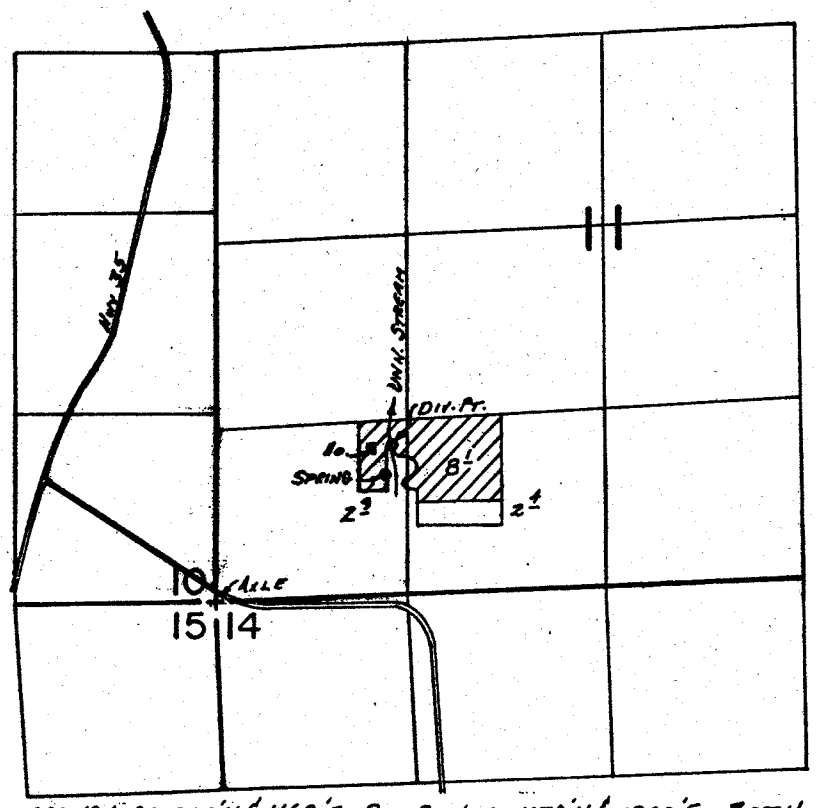

SPRING LOC.: 860'N.& 1160'E, DIV. PT. LOC.: 1070'N.& 1200'E, BOTH FROM SW COR. SEC. 11.

SCALE: 1"=1320'

FINAL PROOF SURVEY
UNDER

Application No. 60518... Permit No. 46732....
IN NAME OF

LAVERN & CARMELITA MILLER

Surveyed July 19.... 1984, by L.M.TOLL.....

27-85 NE¼ BLB