


T. 13 S., R. 9 E., W. M.
SECTION 15

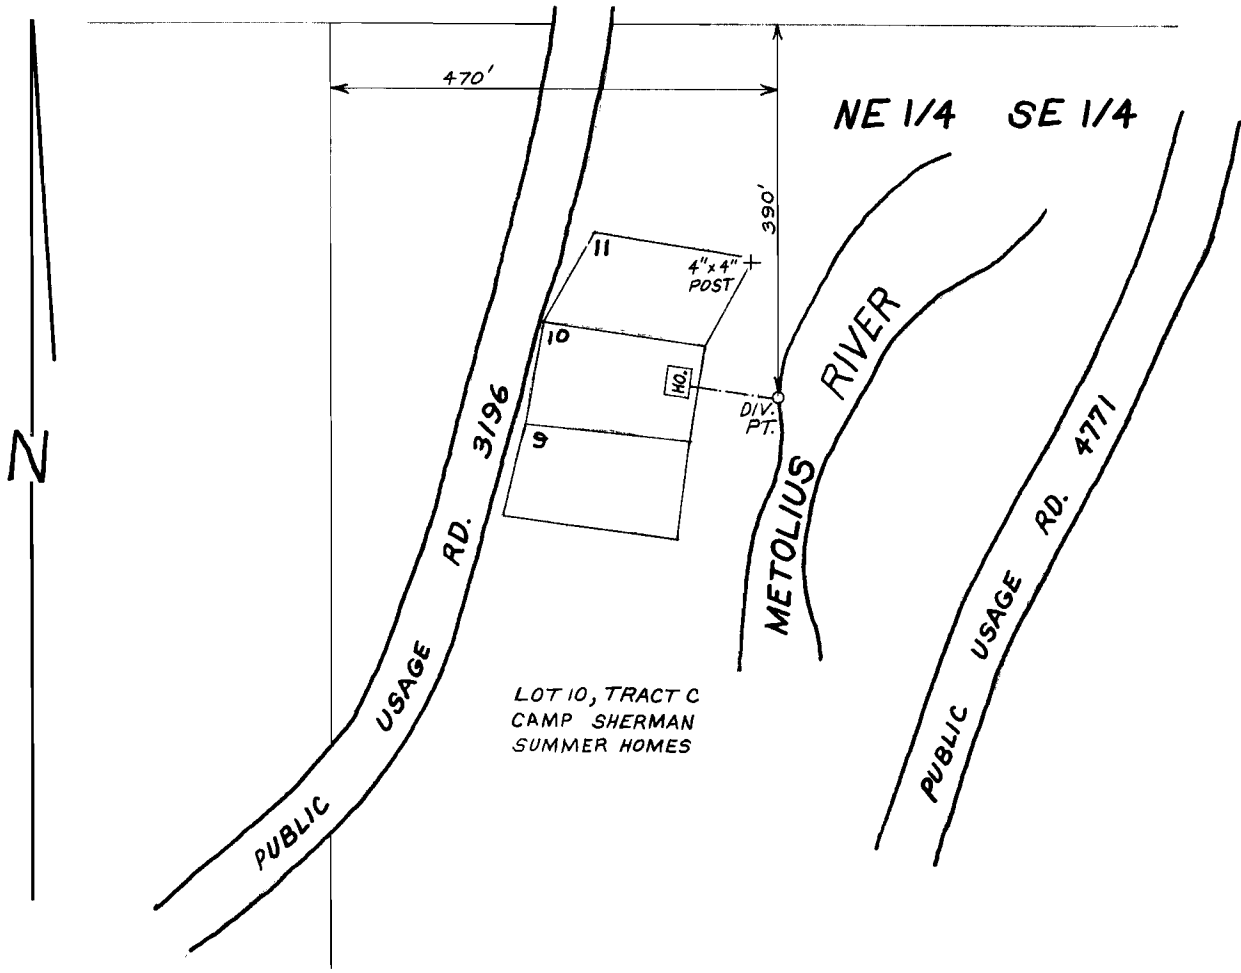

SCALE: 1" = 200'

FINAL PROOF SURVEY
UNDER

Application No. 65387. Permit No. 47703

IN NAME OF

SANFORD S. COX

Surveyed APRIL 3, 19 85, by LESLIE OLSON