


T. 13 S., R. 9 E., W.M.  
SECTION 15

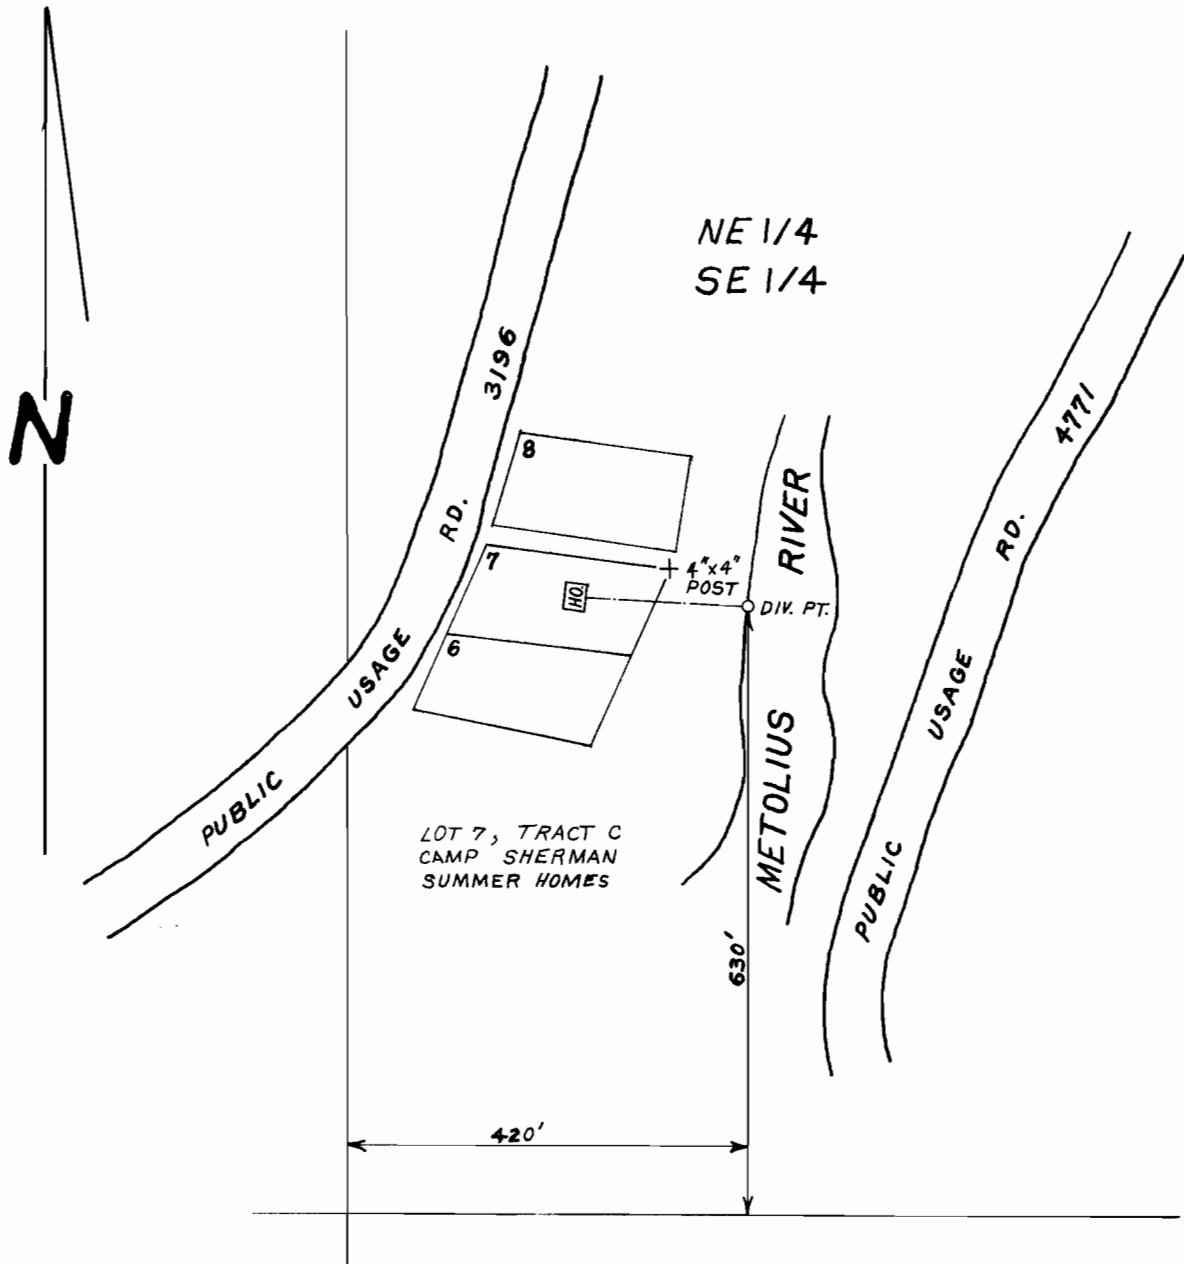

SCALE: 1" = 200'

**FINAL PROOF SURVEY**

UNDER

Application No. 65519 Permit No. 47775

IN NAME OF

THOMAS E. & MARJORIE A. MCGINNIS

Surveyed APRIL 3 19 85, by LESLIE OLSON

CHAIN & COMPASS SURVEY *lvb*