


T.13 S., R.31 E., W.M.
AMENDED APPLICATION MAP FOR
JOHN D. LAURANCE
SEC. 35
NW1/4 SE1/4

RECEIVED
JUL 22 1983
WATER RESOURCES DEPT.
SALEM, OREGON

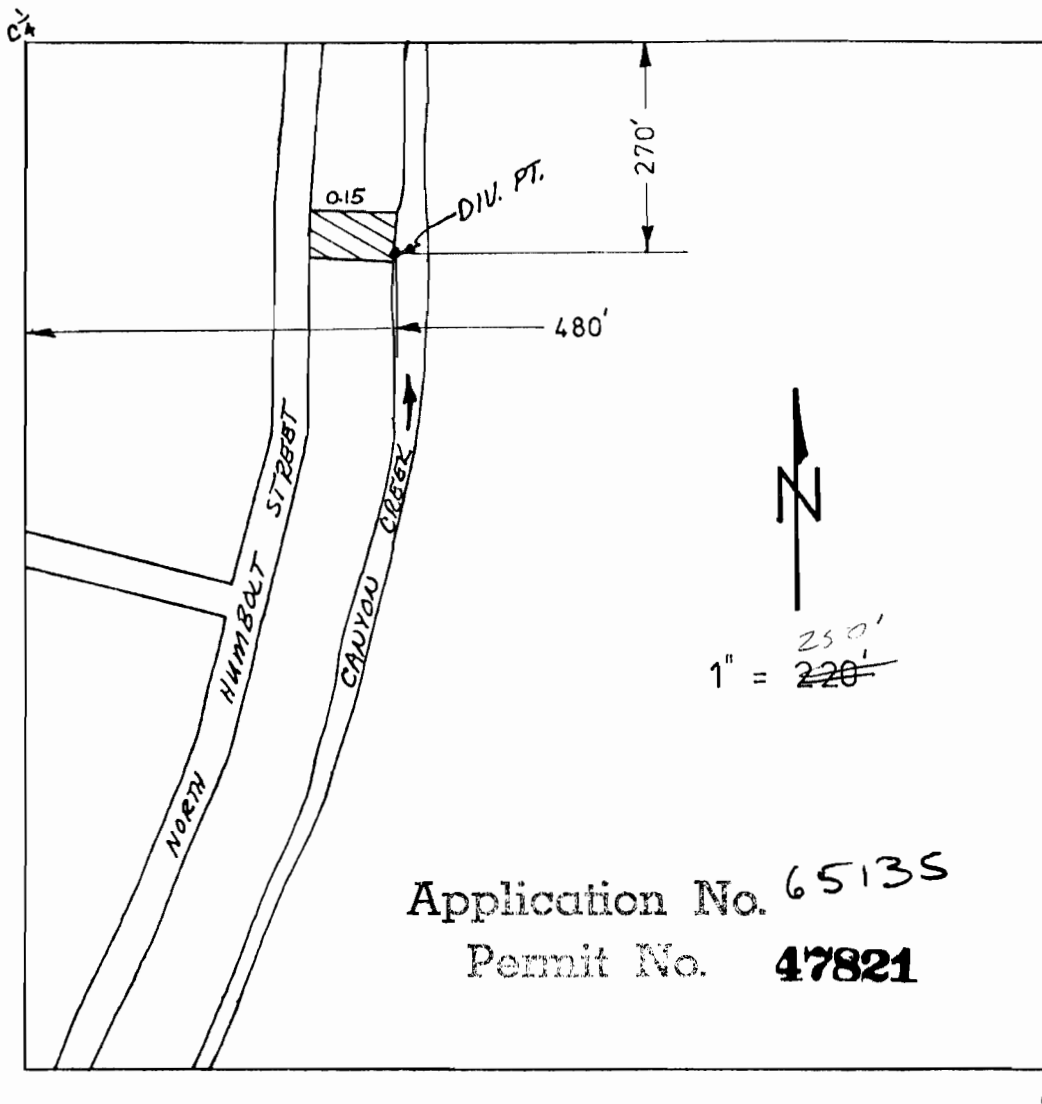

APPROVED

John D. Laurance