
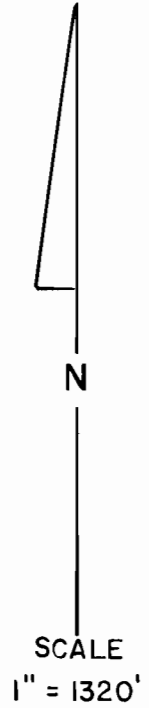


T. 16 S., R. 9 W., W. M.

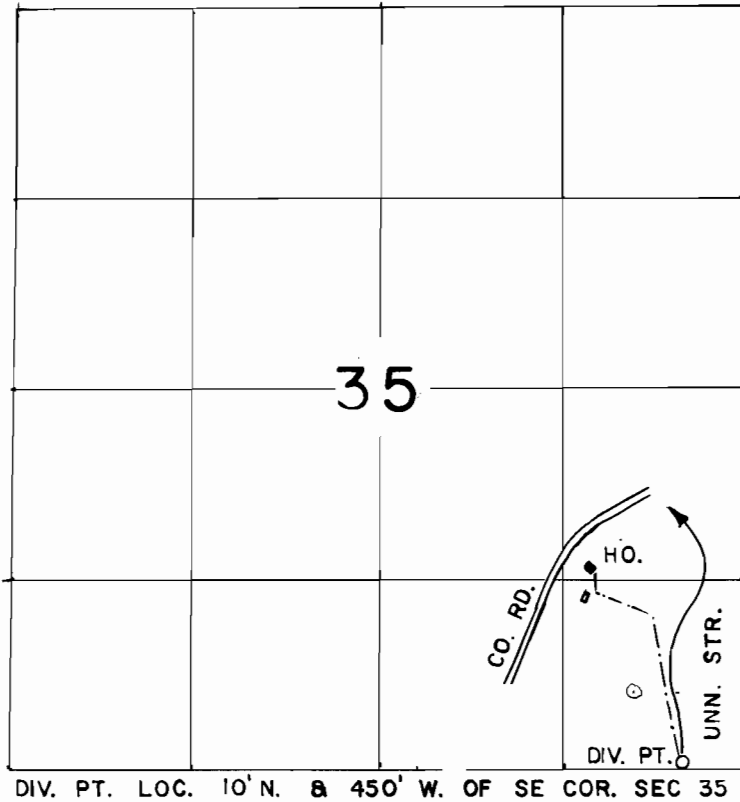

**FINAL PROOF SURVEY**  
UNDER

Application No. 65162... Permit No. 47826

IN NAME OF

ROBERT PAUL THEISS

Surveyed JUN 6 1984, by P. PAGTER