


T. 11 S., R. 11 W., W. M.

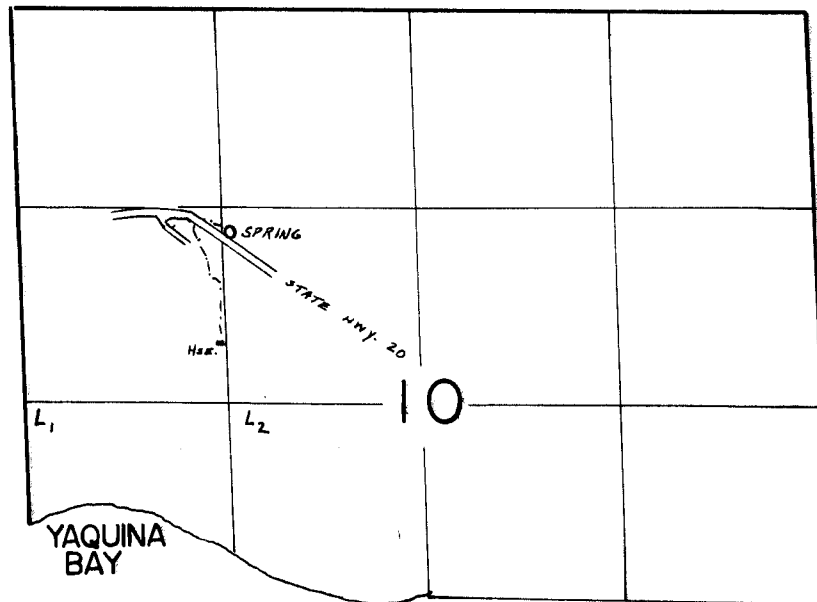

P.O.D. Loc.: 170' S. & 60' E. from NW Cor. SE 1/4 NW 1/4
Sec. 10.

Scale: 1" = 1320'

FINAL PROOF SURVEY UNDER

Application No. 65505 Permit No. 47979
IN NAME OF

DAVID NEIL BRADSHAW

Surveyed May 23, 1988, by T. Warren