


T. 13 S., R. 9 E., W.M.

SECTION 15

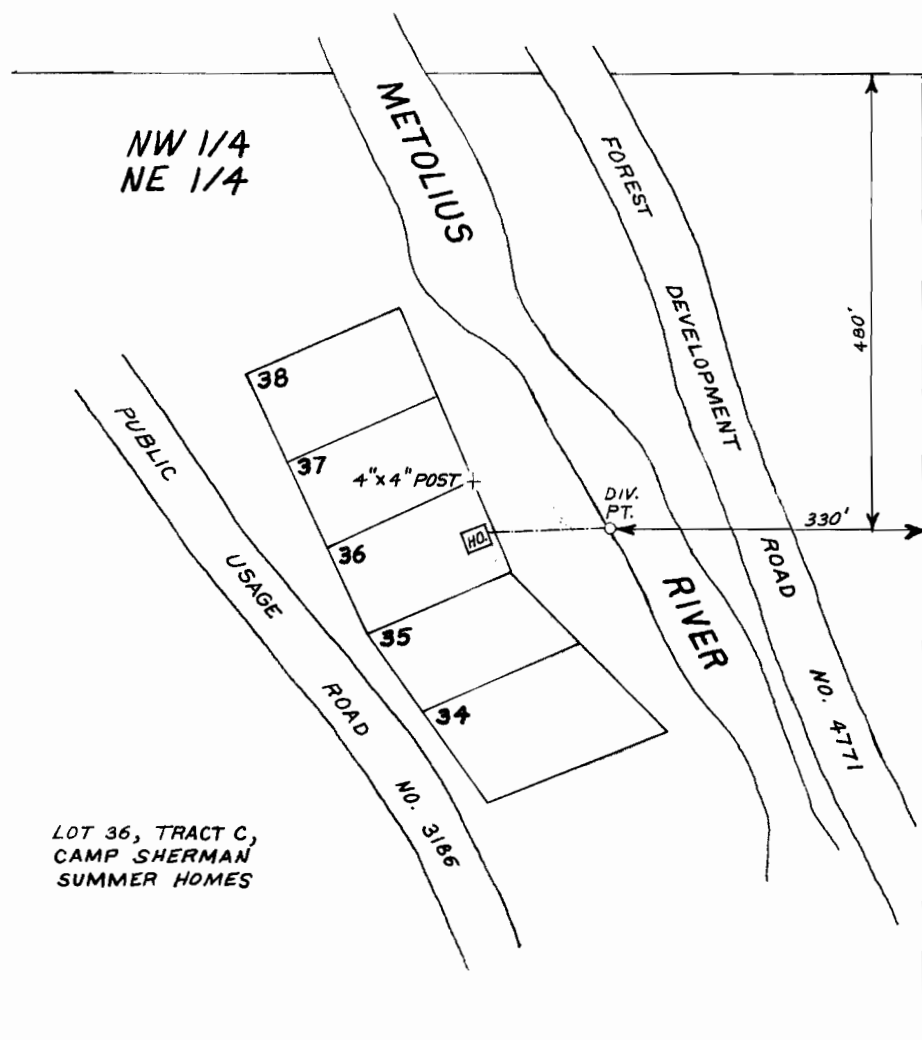

LOT 36, TRACT C,  
CAMP SHERMAN  
SUMMER HOMES

SCALE: 1" = 200'

FINAL PROOF SURVEY

UNDER

Application No. 65508 Permit No. 48172

IN NAME OF

TOM E. & PAULA A. GRIGSBY

Surveyed FEB. 28 1985, by LESLIE OLSON

CHAIN & COMPASS *Tab*