


T. 26 S., R. 3 W., W.M.

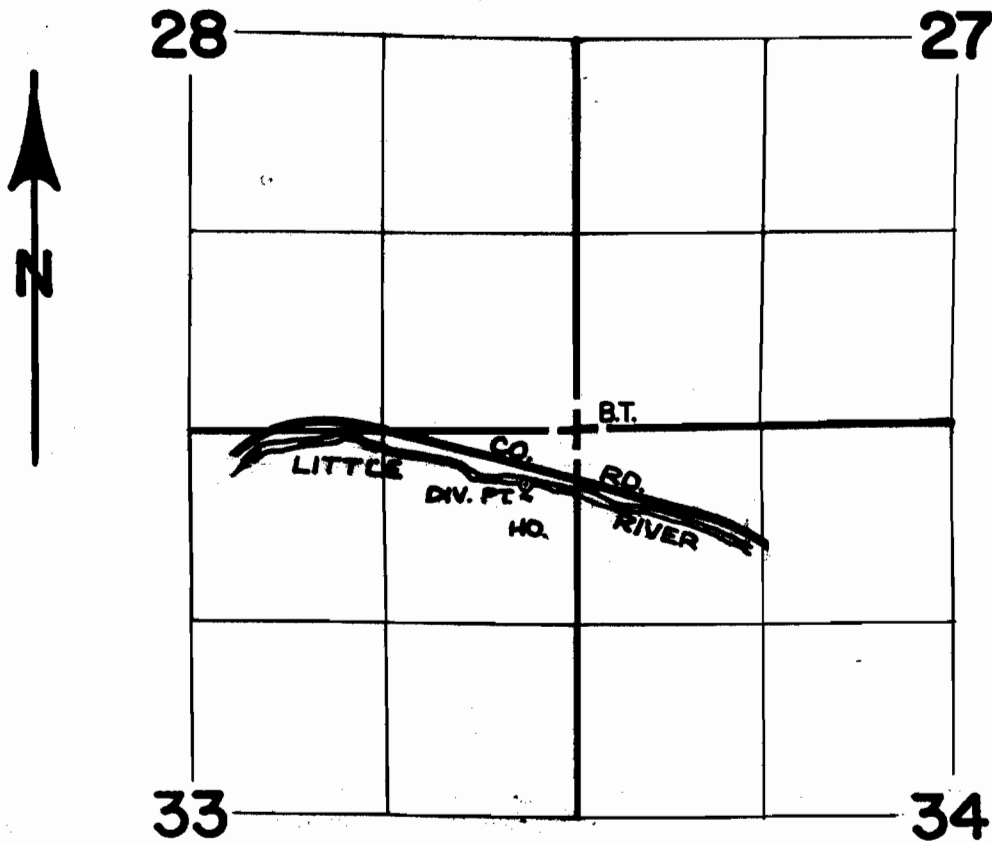

DIV. PT. IS LOCATED 370' S. & 350' W. OF NE CORNER SEC. 33

SCALE: 4" = 1 MILE

FINAL PROOF SURVEY
UNDER

Application No. ..67316.. Permit No. ...48183.....
IN NAME OF

ROBERT M. & ROBERTA D. JONES

Surveyed JULY 18, 1984, byD.K. CLARK....