


T. 30 S., R. 6 W., W.M.
SECTION 11

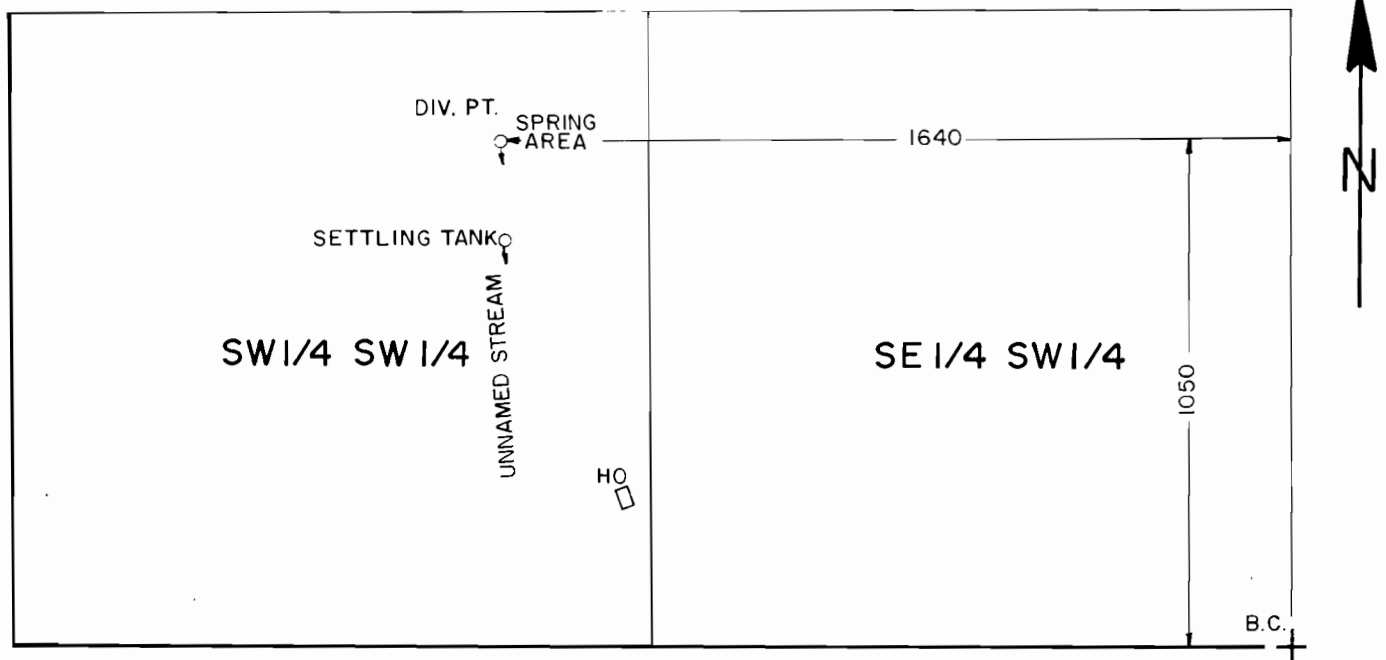

SCALE 1" = 400'

FINAL PROOF SURVEY
UNDER

Application No. 67969 Permit No. 48327
IN NAME OF

LYLE L. LIGHT

Surveyed JULY 5 1984, by L. E. CASHION