


T. 11 S., R. 8 W., W.M.

N

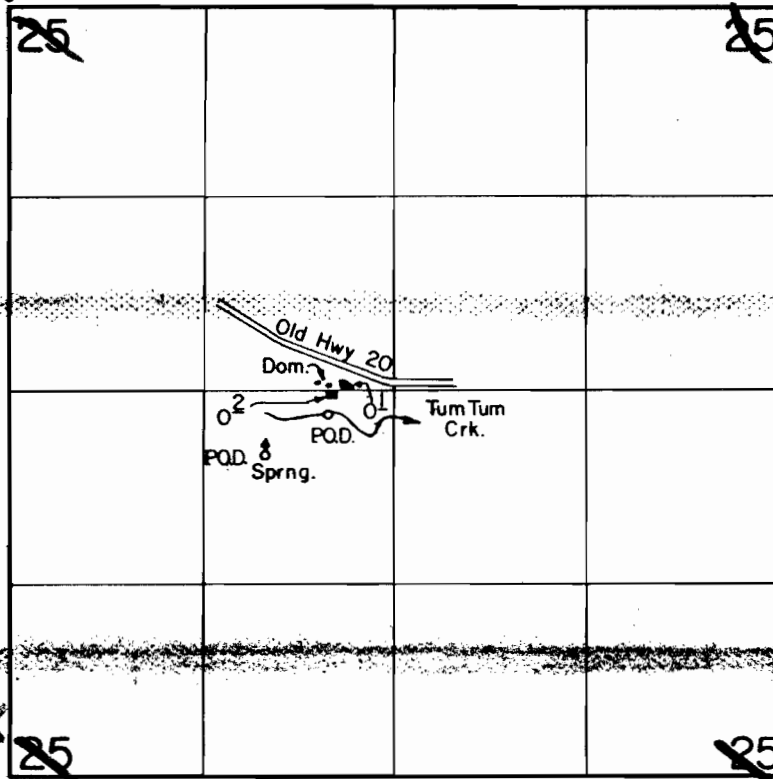

Crk. P.O.D. Loc. : 160' S. & 450' W.
Sprng P.O.D. Loc. : 450' S. & 890' W., both from C. 1/4 Cor., Sec. 25.

Scale: 1" = 1320'

FINAL PROOF SURVEY UNDER

Application No. 68667 Permit No. 49631
68838 50001
IN NAME OF

ROBERT EARL REED

Surveyed May 26 1988, by T. Warren

41041-372-140

10/12/88 TAW