

AUG 19 1981

FIELD MAP SHEET


WATER RESOURCES DEPT
SALEM, OREGON

T. 39S R. 15E Sec. Subdiv. FREMONT N.F.

Mapped by T. OLENICHAK Reviewed by Scale 2 inches = 1 Mile

- RESERVOIR
- DRAINAGE
- ROAD

Application No. R-62446 6/7, 1981
Permit No. R 8903

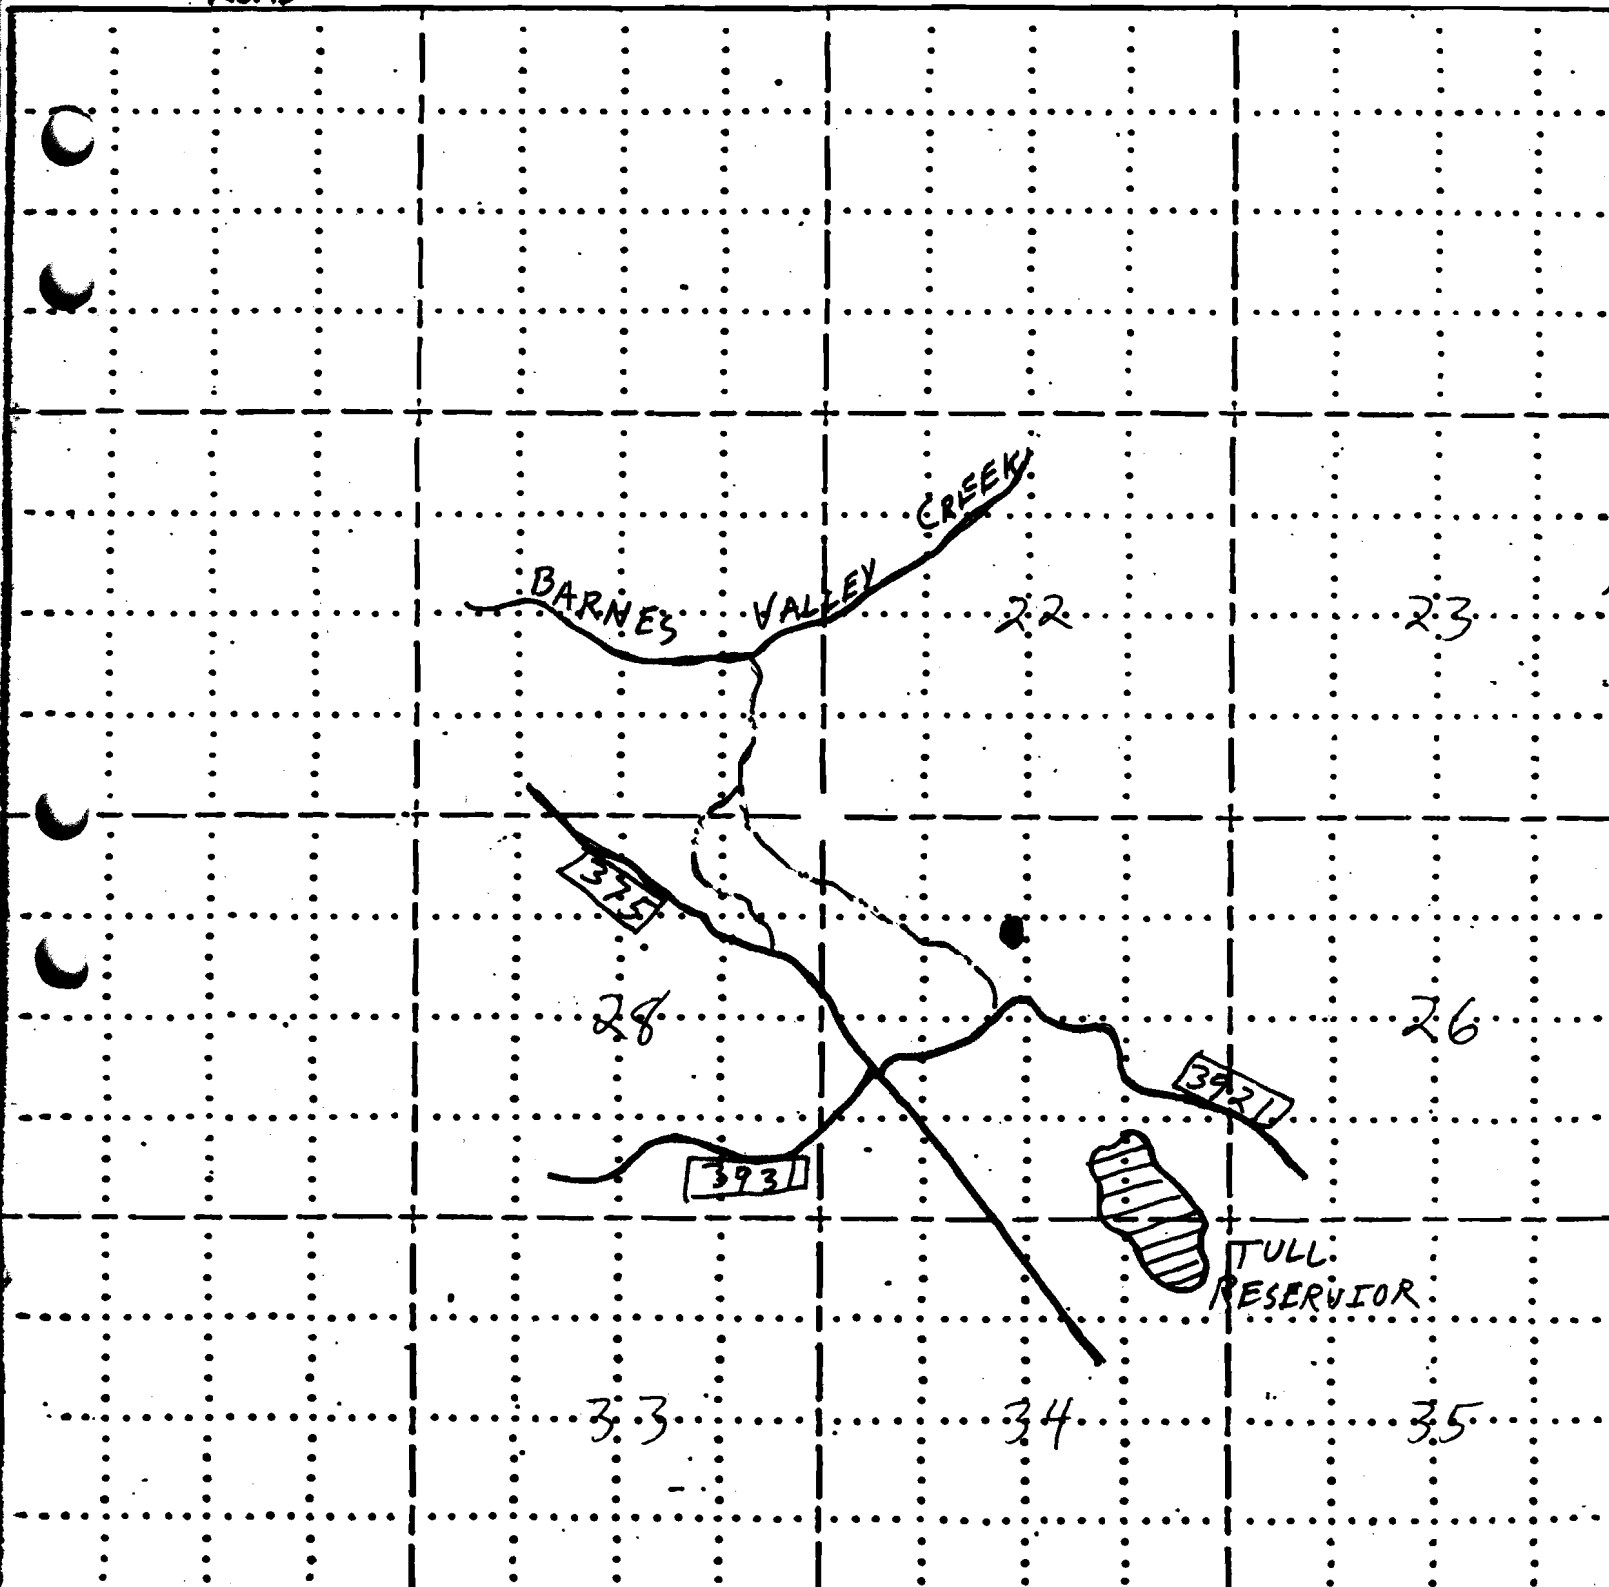

RECEIVED

AUG 19 1981

WATER RESOURCES DEPT.
SALEM, OREGON

Application No. R 62446
Permit No. R 8903

