

AUG 19 1981

FIELD MAP SHEET

WATER RESOURCES DEPT
SALEM, OREGON

T. 37S R. 14E Sec. Subdiv.


FREMONT N.E.

Mapped by Reviewed by Scale 2 inches = 1 Mile

- RESERVOIR
- DRAINAGE
- ROAD

Application No. R-62451 7/21 1981

Permit No. R 8907

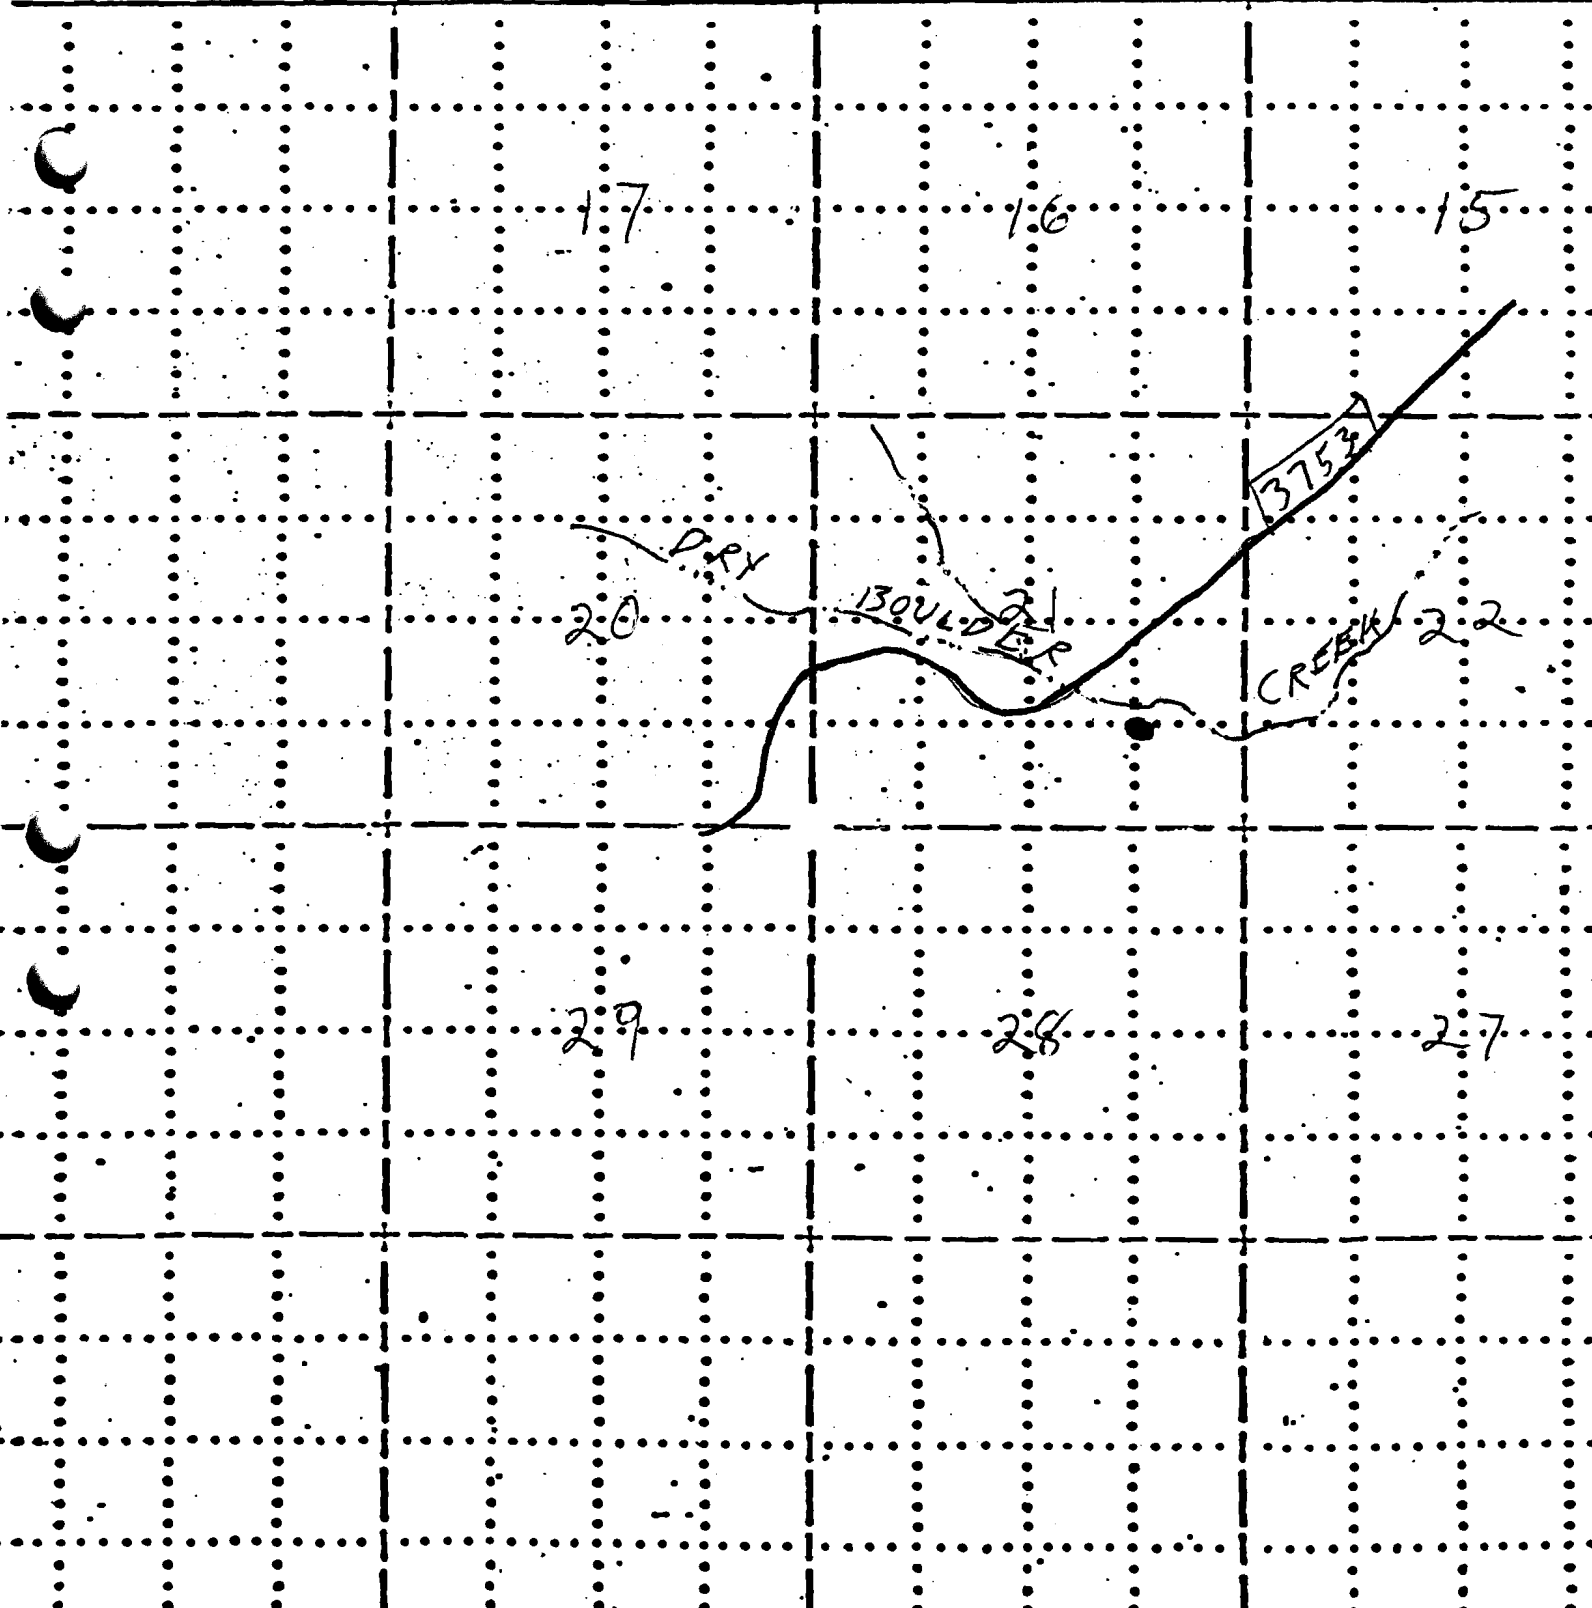


37 14 21
22

RECEIVED

AUG 19 1981

WATER RESOURCES DEPT
SALEM, OREGON

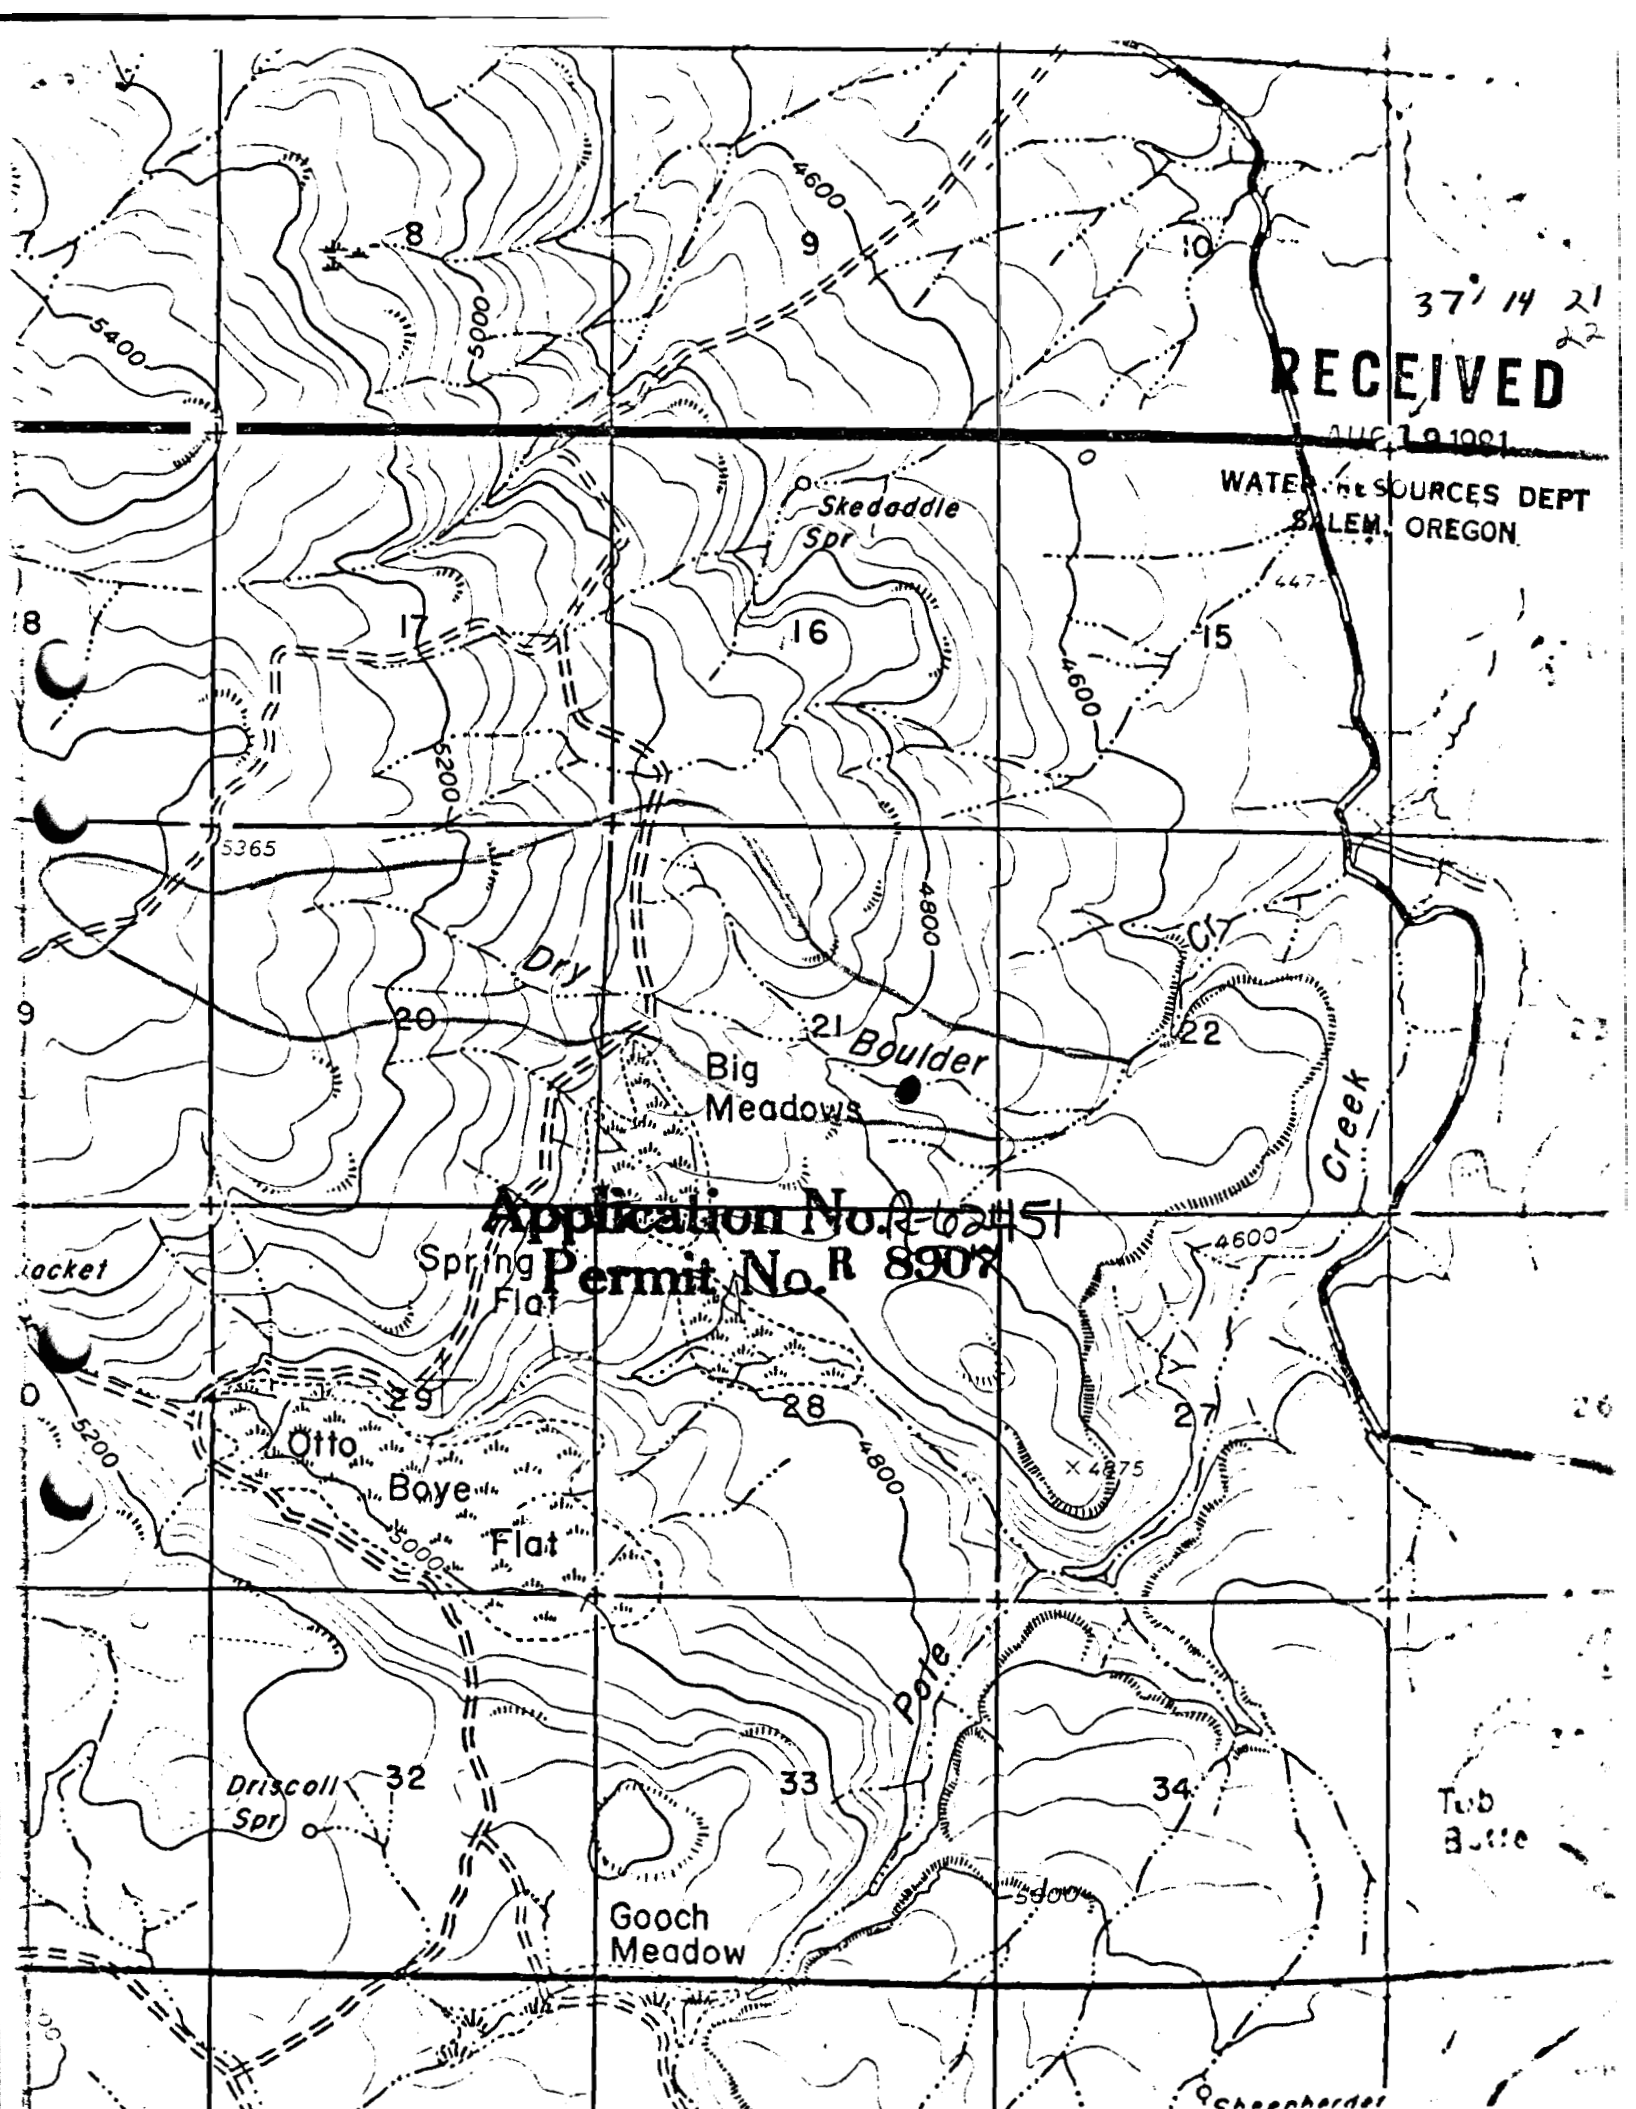

Application No. R-62451
Permit No. R 8907

Tab
Butte

Chepherd