

RECEIVED R-8908

AUG 19 1981

59159

FIELD MAP SHEET

WATER RESOURCES DEPT
SALEM, OREGON

T. 38S R. 12E Sec. _____ Subdiv. _____ FREMONT N.F.

Mapped by _____ Reviewed by _____ Scale 2 inches = 1 Mile

● RESERVOIR


— DRAINAGE

--- POWER LINES

Application No. R-62452

7/21, 1981

Permit No. R 8908

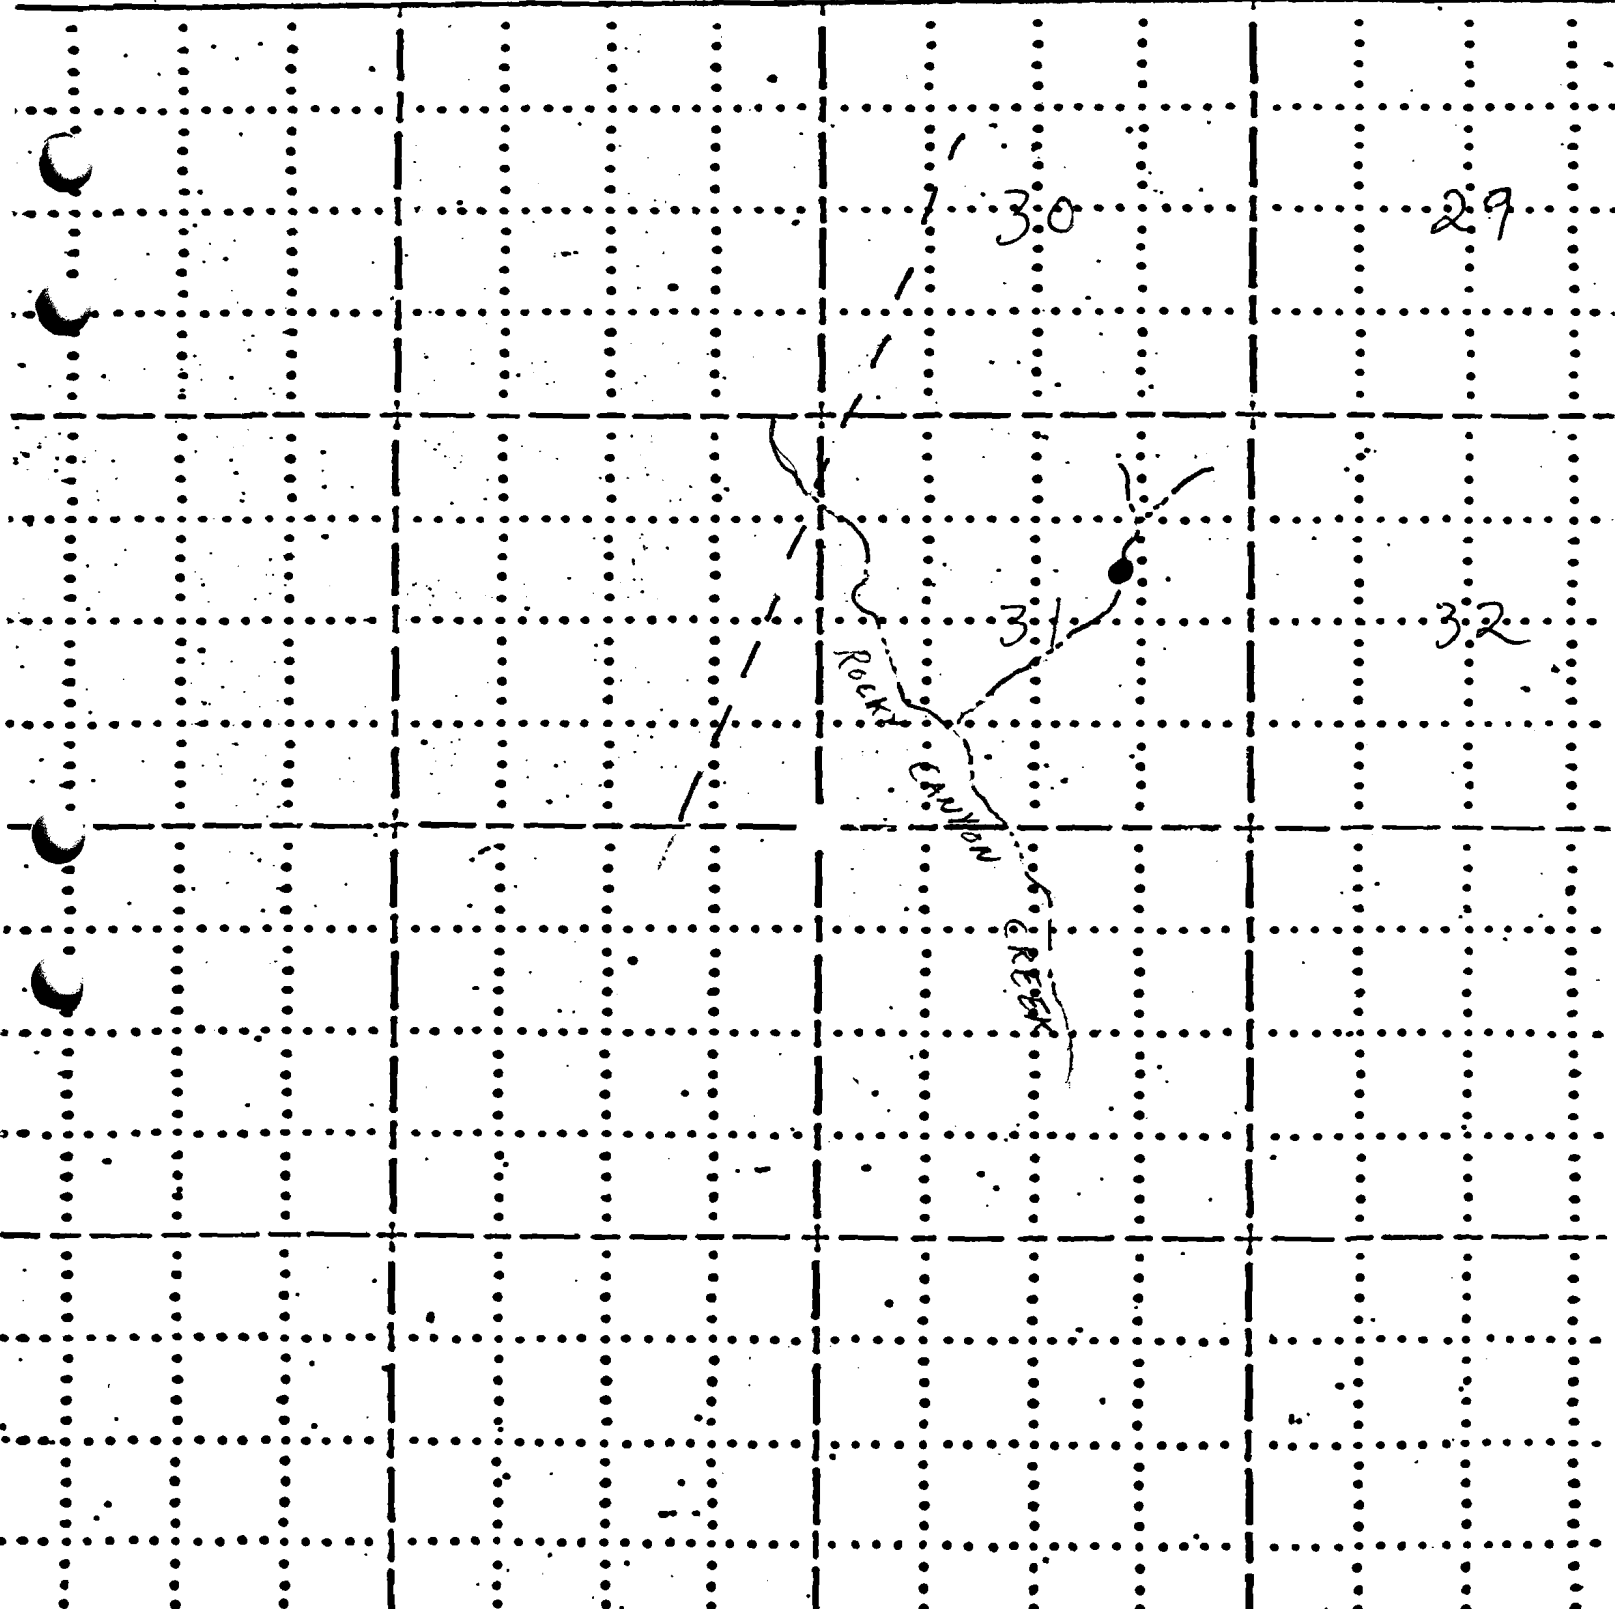

RECEIVED

AUG 19 1981

38 12 31

WATER RESOURCES DEPT
SALEM, OREGON

(440)

Application No. R-62452
Permit No. R 8908

(Beatty)

1 270 00-

20'

JCT. ORE 66
1 760 000

