

R-8910
37 12 24
59161


1997

(440)

Application No. R-62454
Permit No. R 8910

(Beatty)

T.37S.

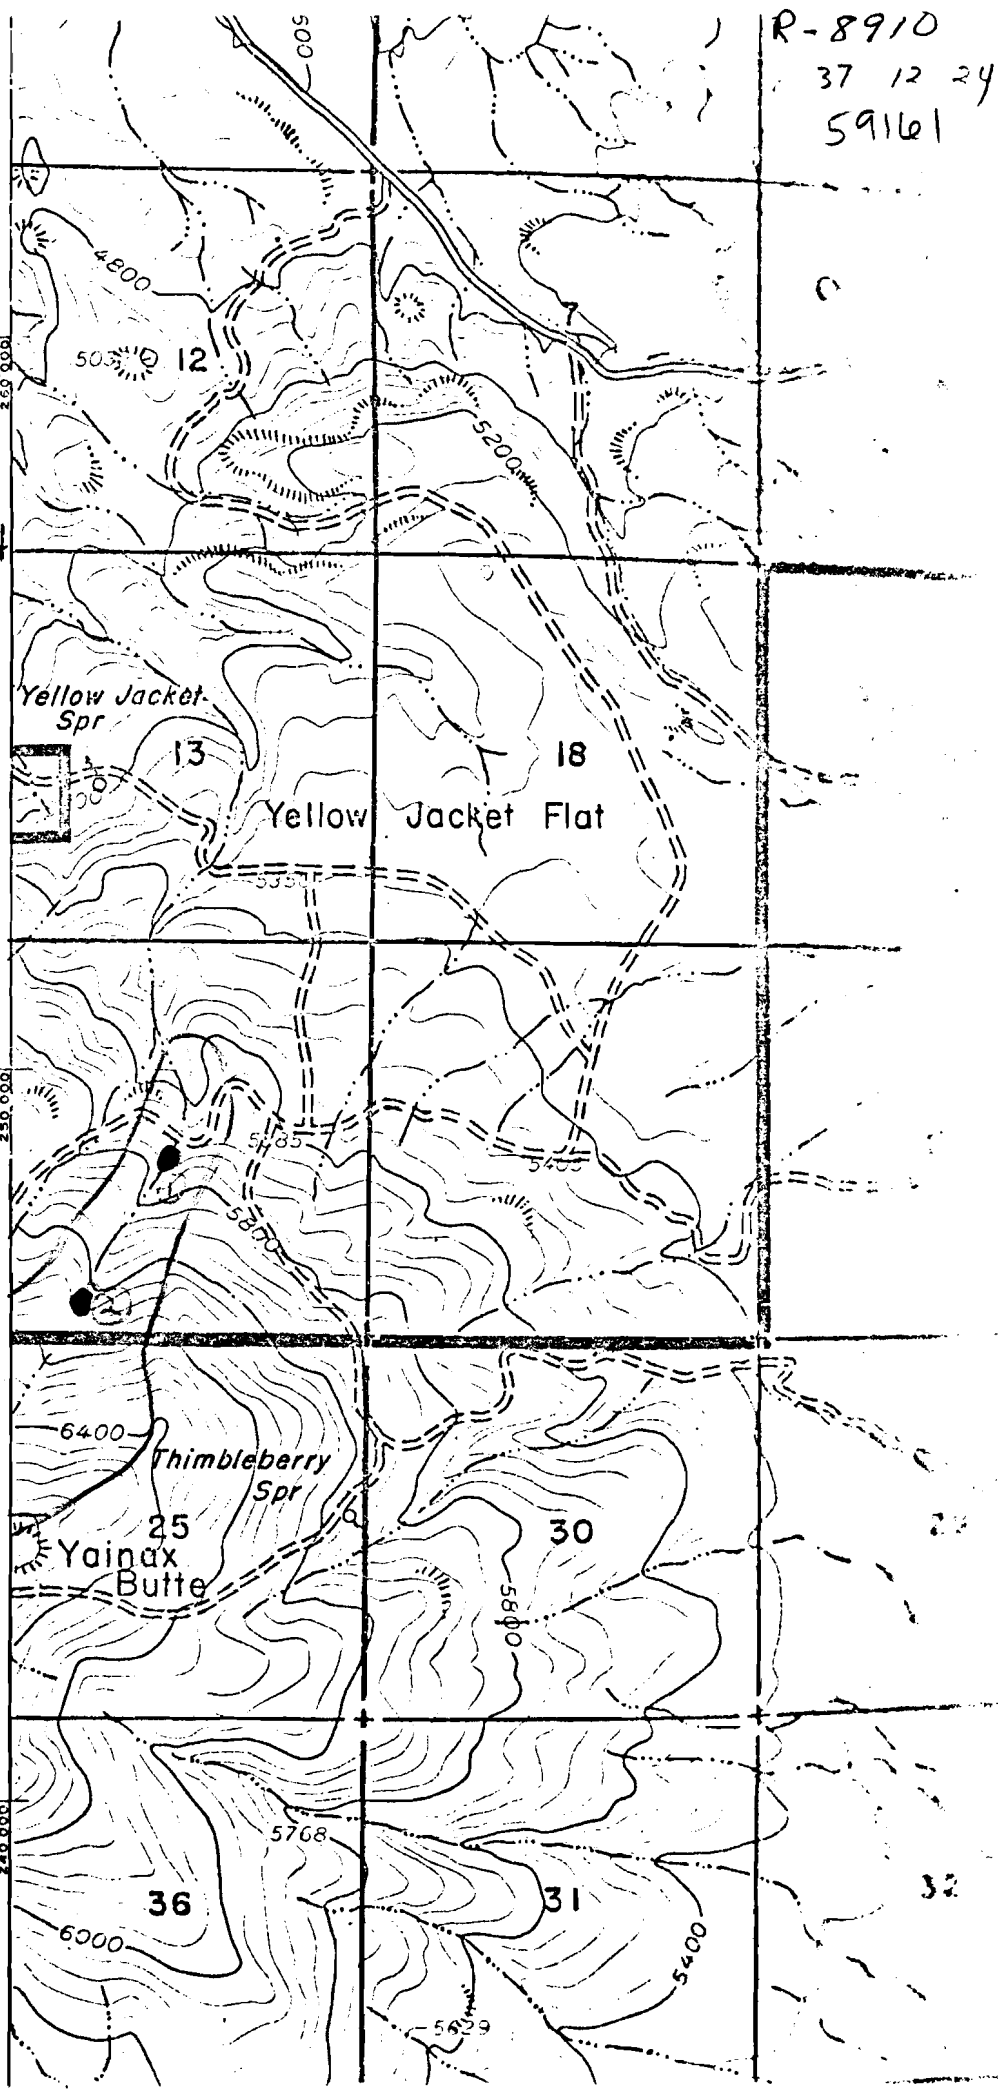

RECEIVED

AUG 19 1981

WATER RESOURCES DEPT
SALEM, OREGON

37 12 24

(439)


RECEIVED

AUG 19 1981

WATER RESOURCES DEPT
SALEM, OREGON

Application No. R-62454
Permit No. R 8910

T.37S.

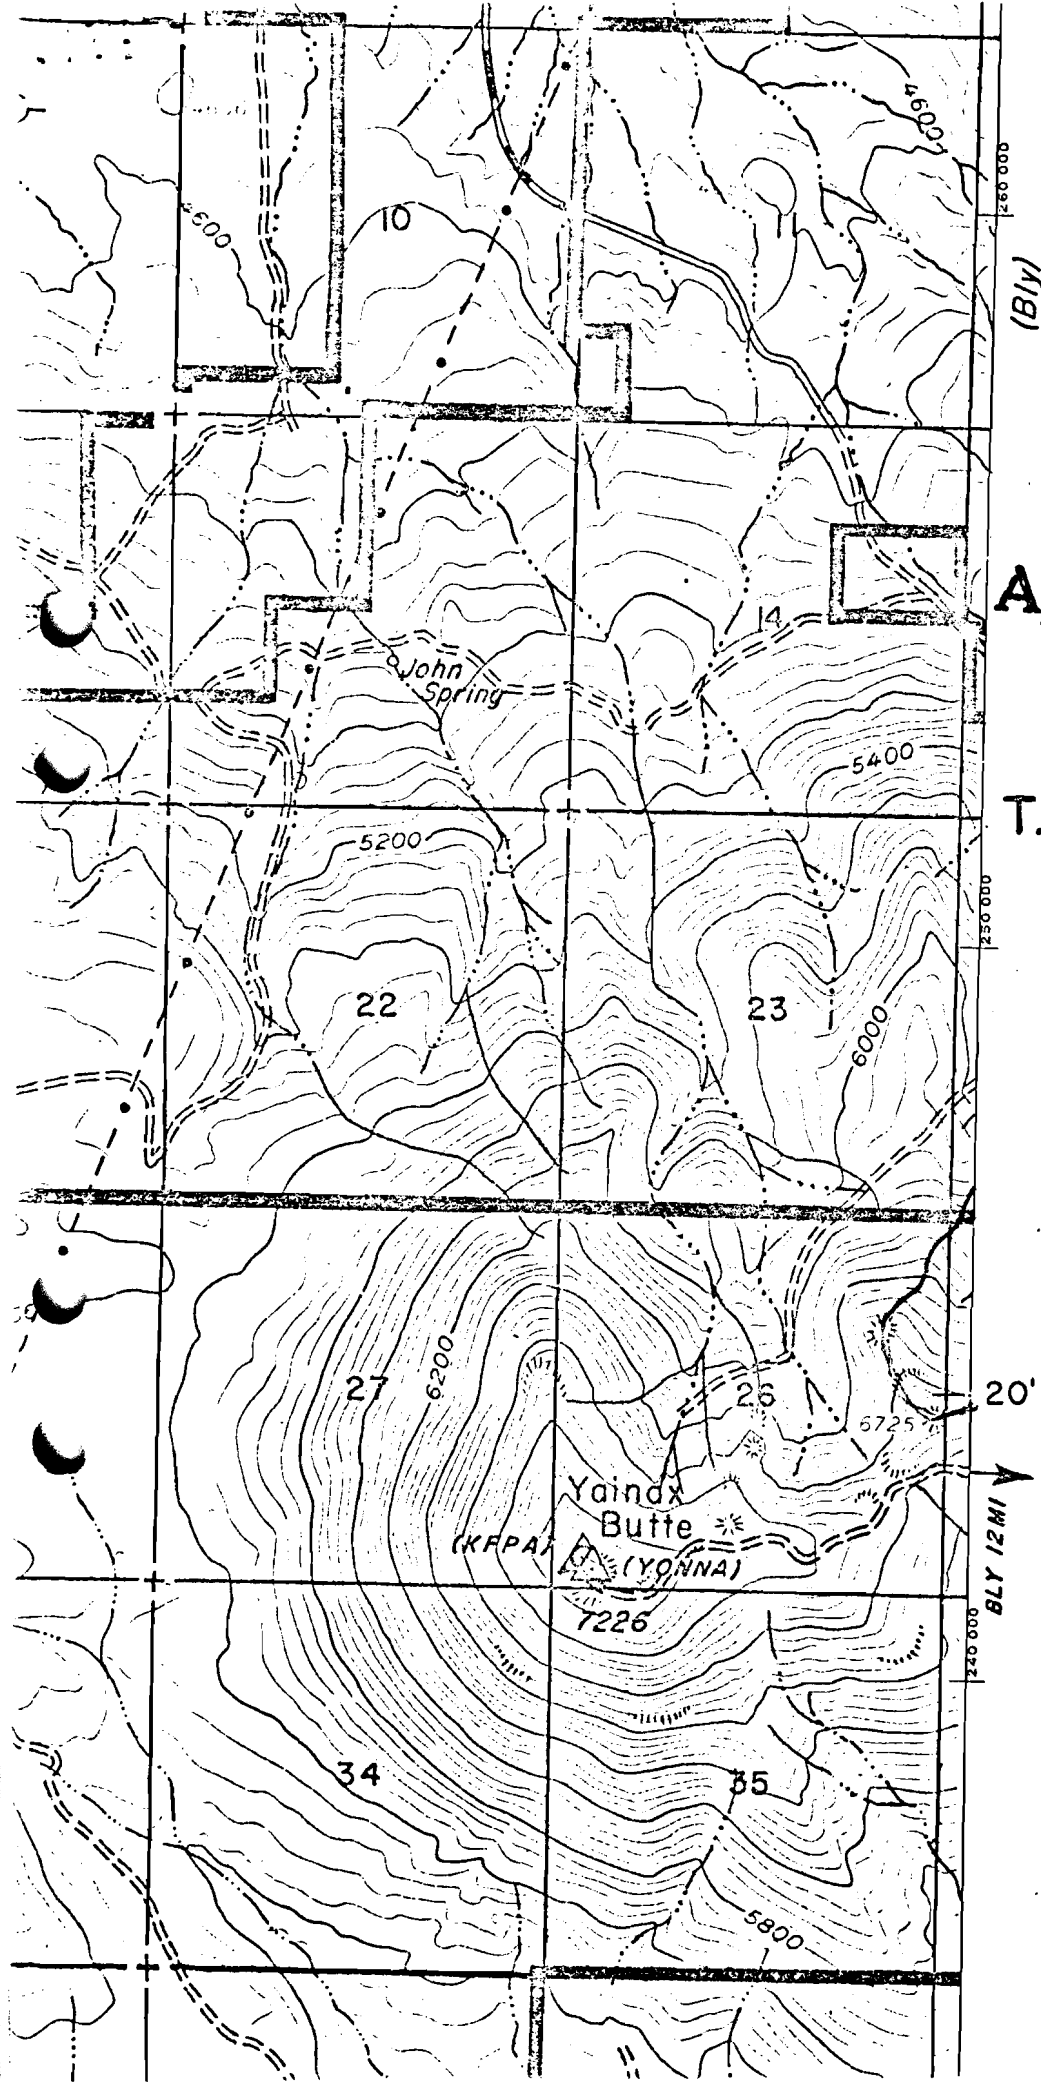

(Bly)

230 000

220 000

8 1/2 MI