


R-8915.18  
38  
59166

Flat  
**RECEIVED**

AUG 19 1981

WATER RESOURCES DEPT  
SALEM, OREGON

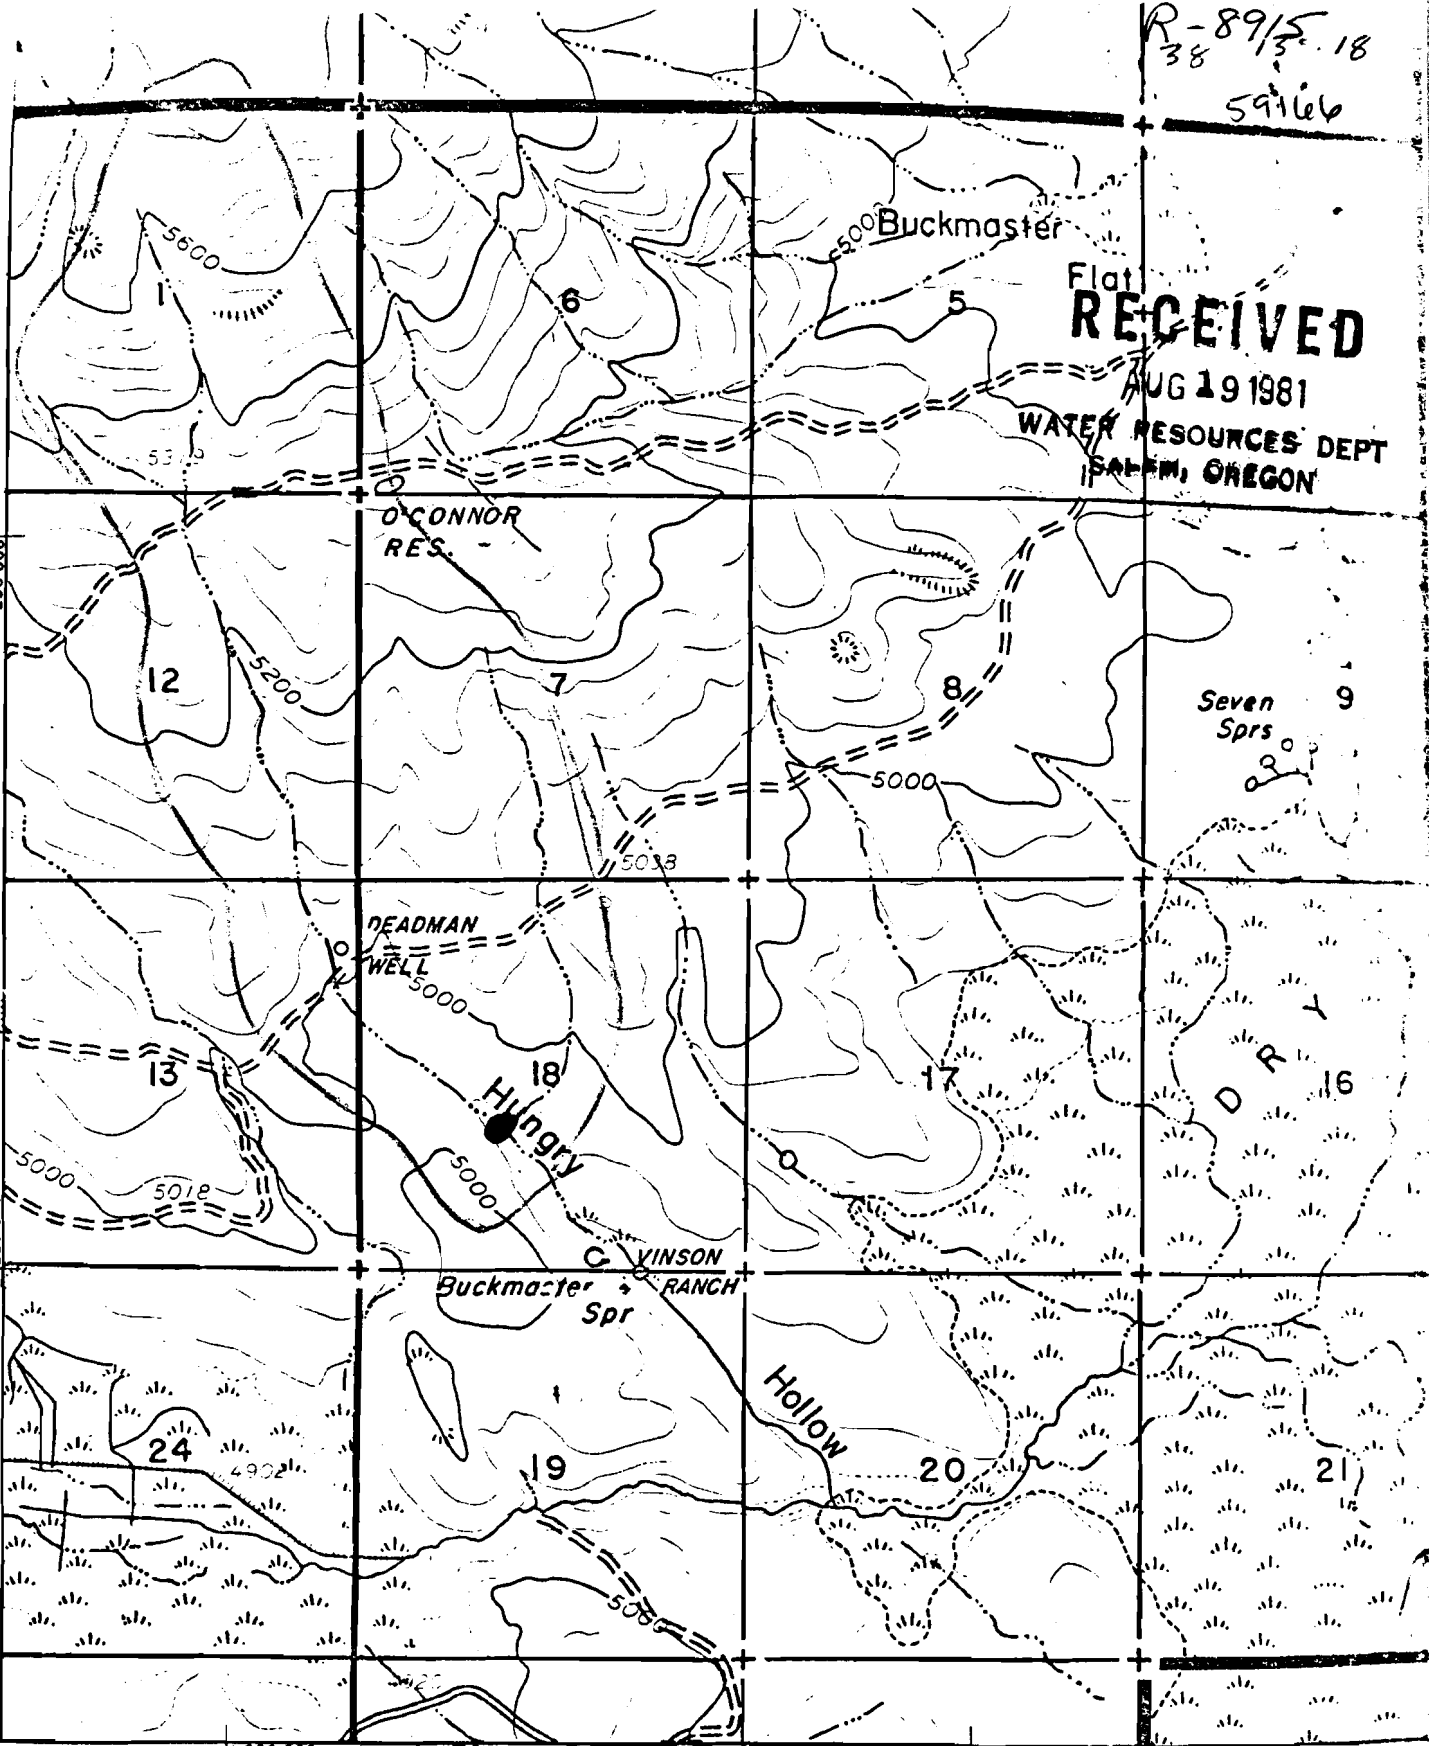

BONANZA 13 MI.

T. 38 S.

42° 15'

121° 15'

R. 12 E.

Application No. R-62460

Permit No. R 8915

Mapped by U. S. Forest Service, Portland, Oregon  
by Stereophotogrammetric methods. 1951

Control by U.S.C. & G.S., U.S.G.S. and Forest Service.

RECEIVED

AUG 19 1981

FIELD MAP SHEET

WATER RESOURCES DEPT

SALEM, OREGON

T. 385 R. 12E/13E Sec. \_\_\_\_\_ Subdiv. \_\_\_\_\_ FREMONT N.F.

Mapped by \_\_\_\_\_ Reviewed by \_\_\_\_\_ Scale 2 inches = 1 Mile

● RESERVOIR Application No. R-62460 7/20, 1981  
— DRAINAGE Permit No. R 8915  
— ROAD

