

R-8916  
**RECEIVED**


59167  
AUG 19 1981

WATER RESOURCES DEPT  
SALEM, OREGON

Application No. R-62461  
Permit No. R 8916

38 13 29

DEPARTMENT OF AGRICULTURE  
FOREST SERVICE  
FREMONT NATIONAL FOREST

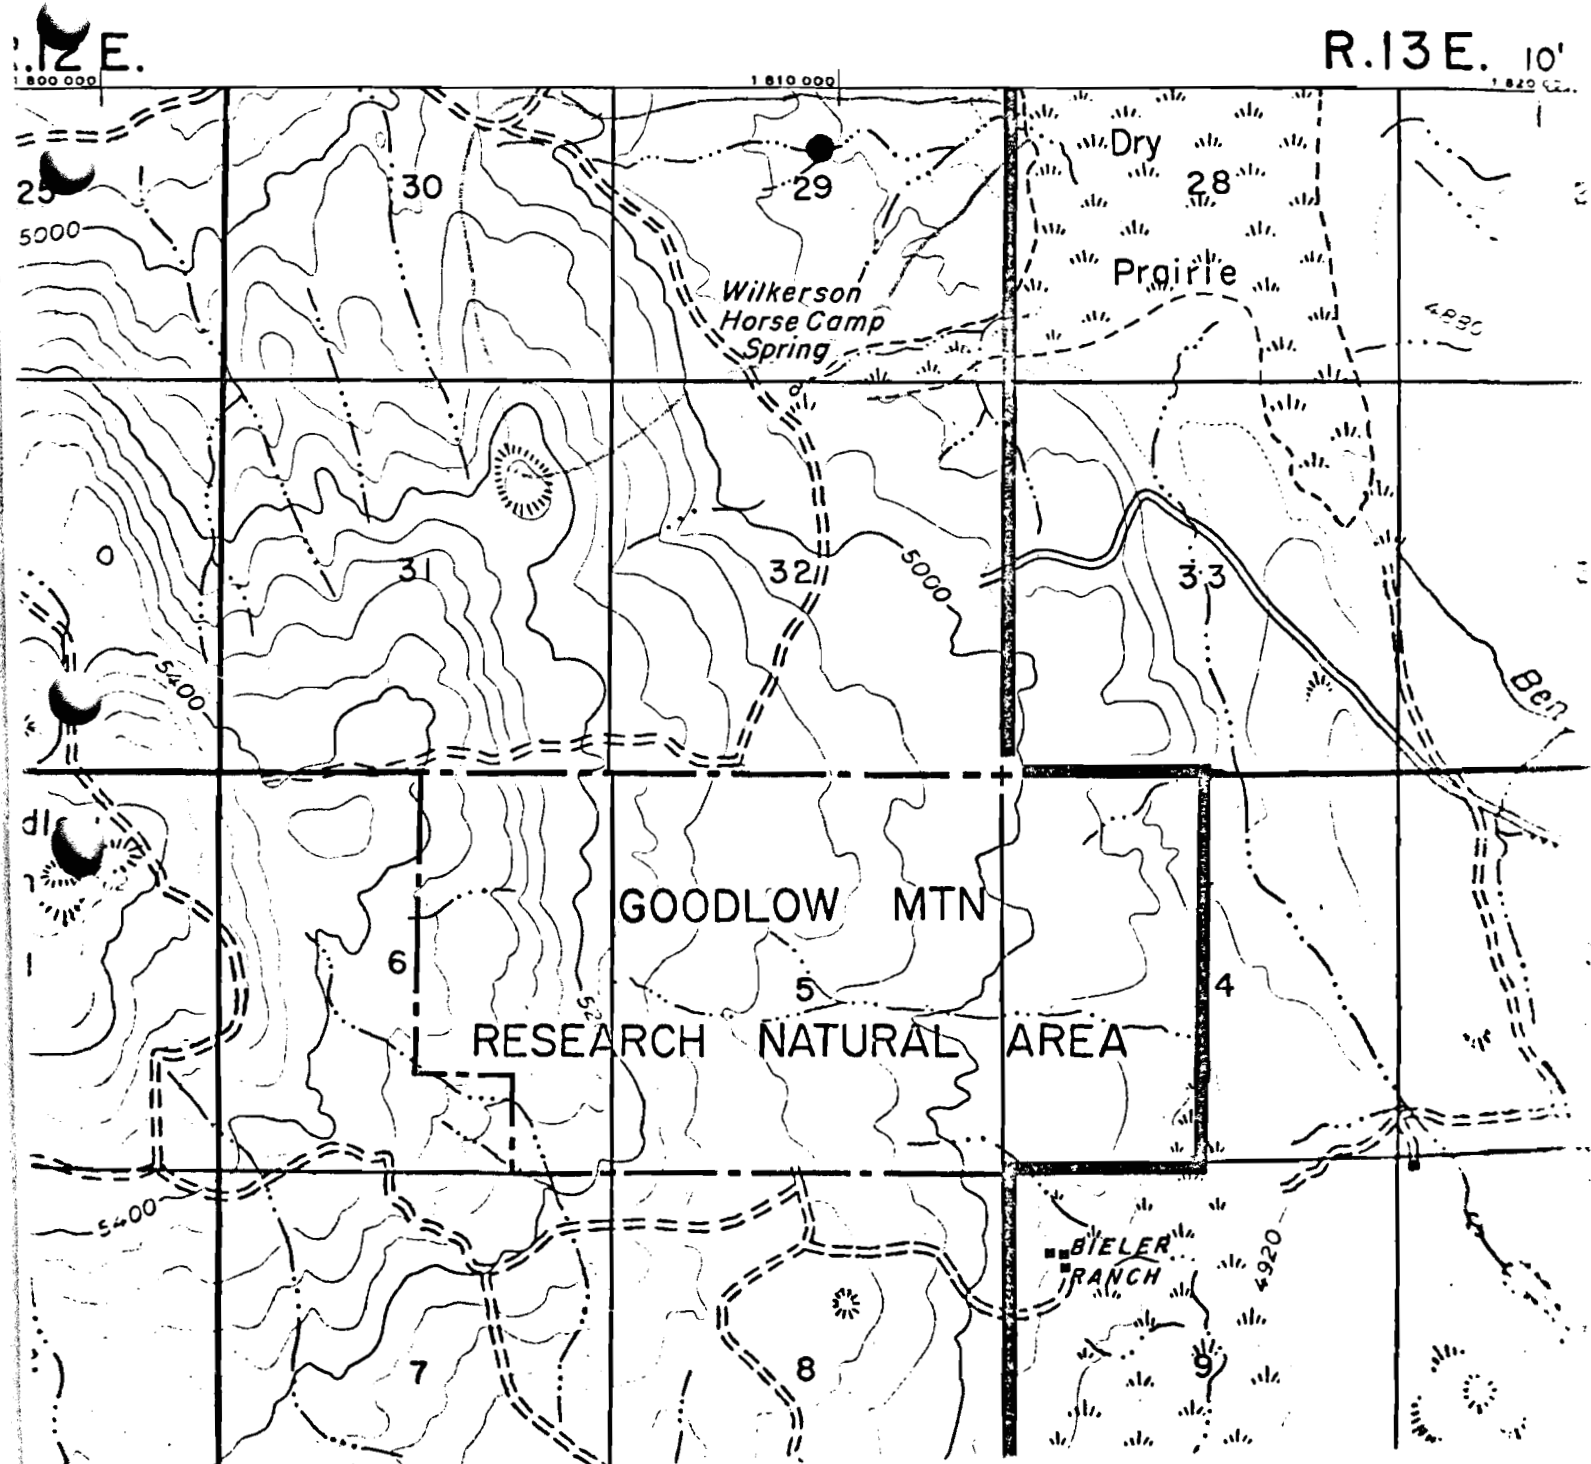

RECEIVED

AUG 19 1981

FIELD MAP SHEET

WATER RESOURCES DEPT.  
SALEM, OREGON  
FREMONT N.F.

T. 385 R. 13E Sec. \_\_\_\_\_ Subdiv. \_\_\_\_\_

Mapped by \_\_\_\_\_ Reviewed by \_\_\_\_\_ Scale 2 inches = 1 Mile

● RESERVOIR Application No. R-62461 7/20, 1981  
— DRAINAGE Permit No. R 8916  
— ROAD

