


R-8917
RECEIVED

AUG 19 1981
WATER RESOURCES DEPT
SALEM OREGON

38 14 1


Application No. R-62462
Permit No. R 8917

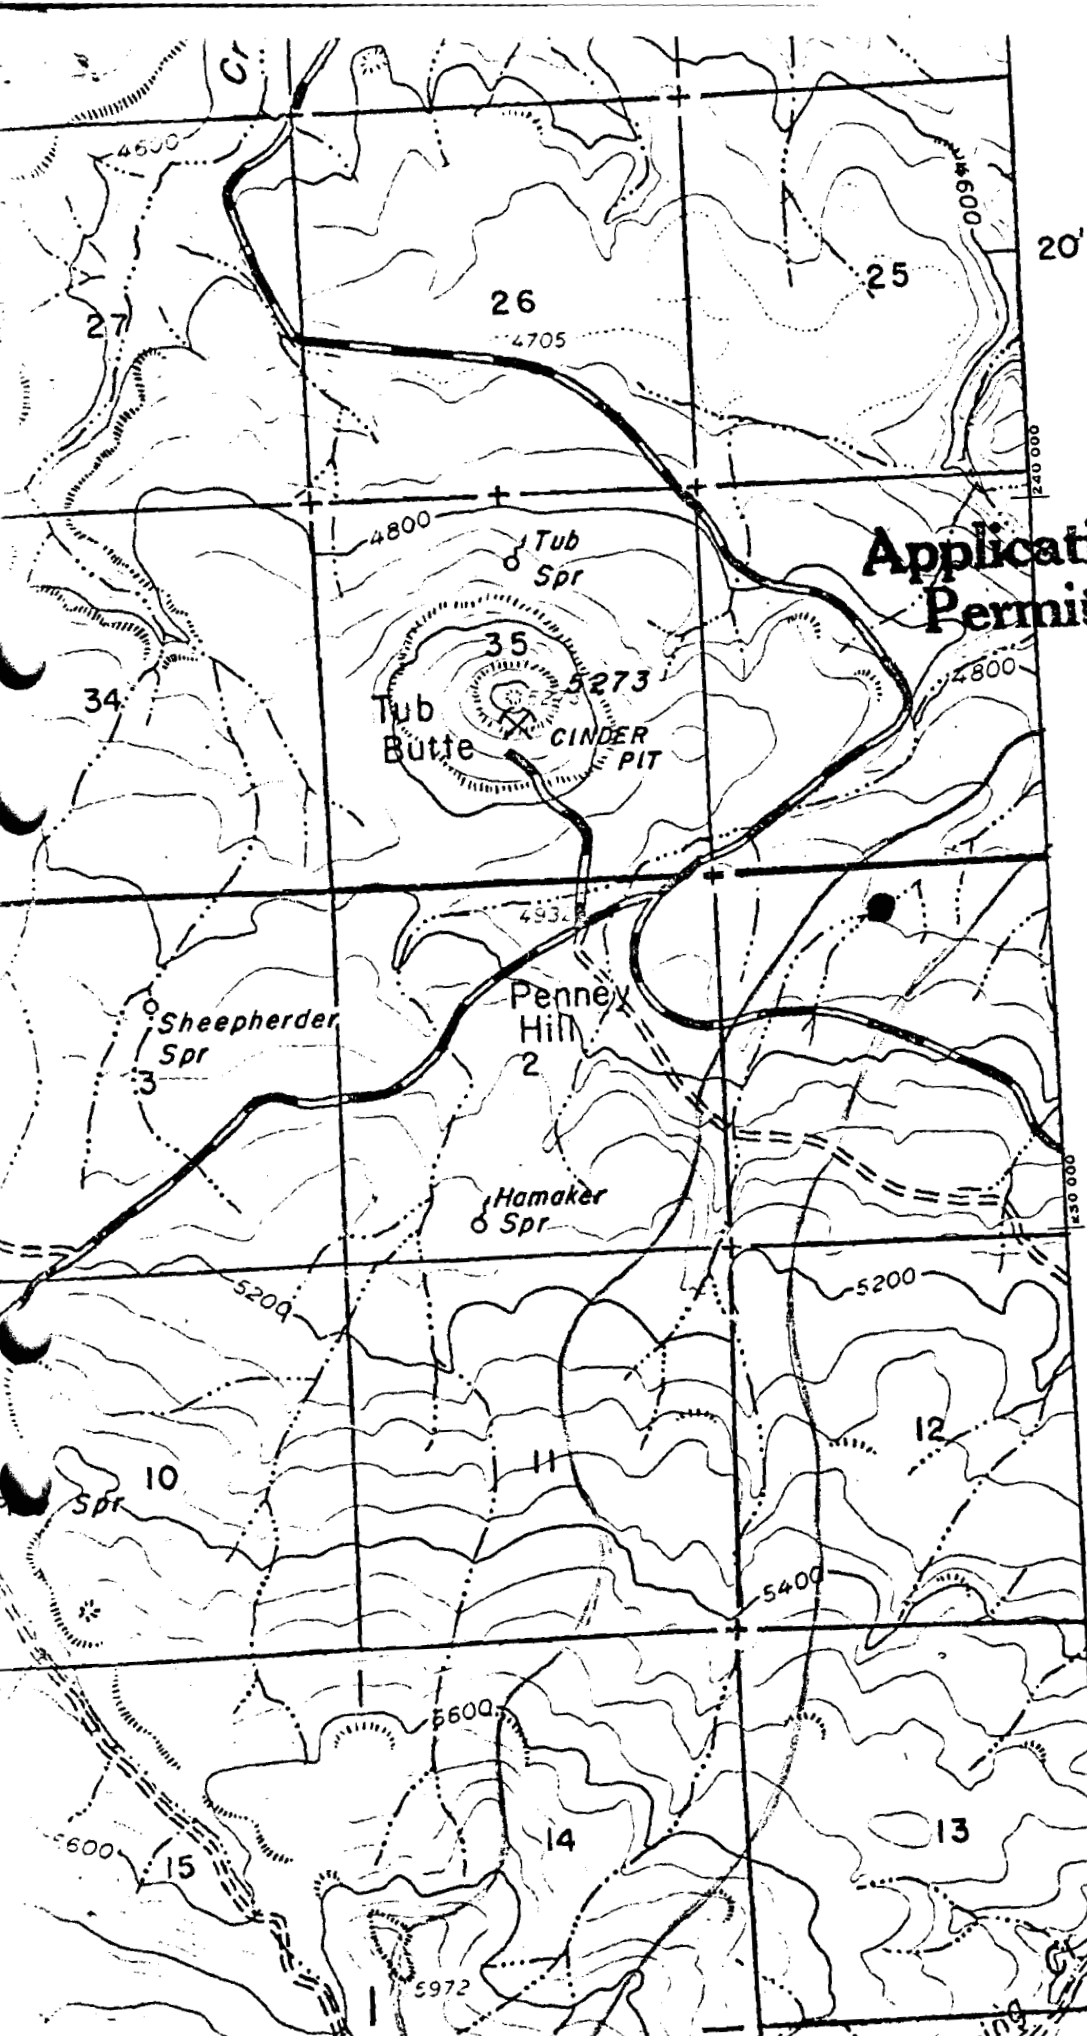

1 IN 13 MI
BLY 13 MI

T.38S.

Application No. R-62462
Permit No. R 8917

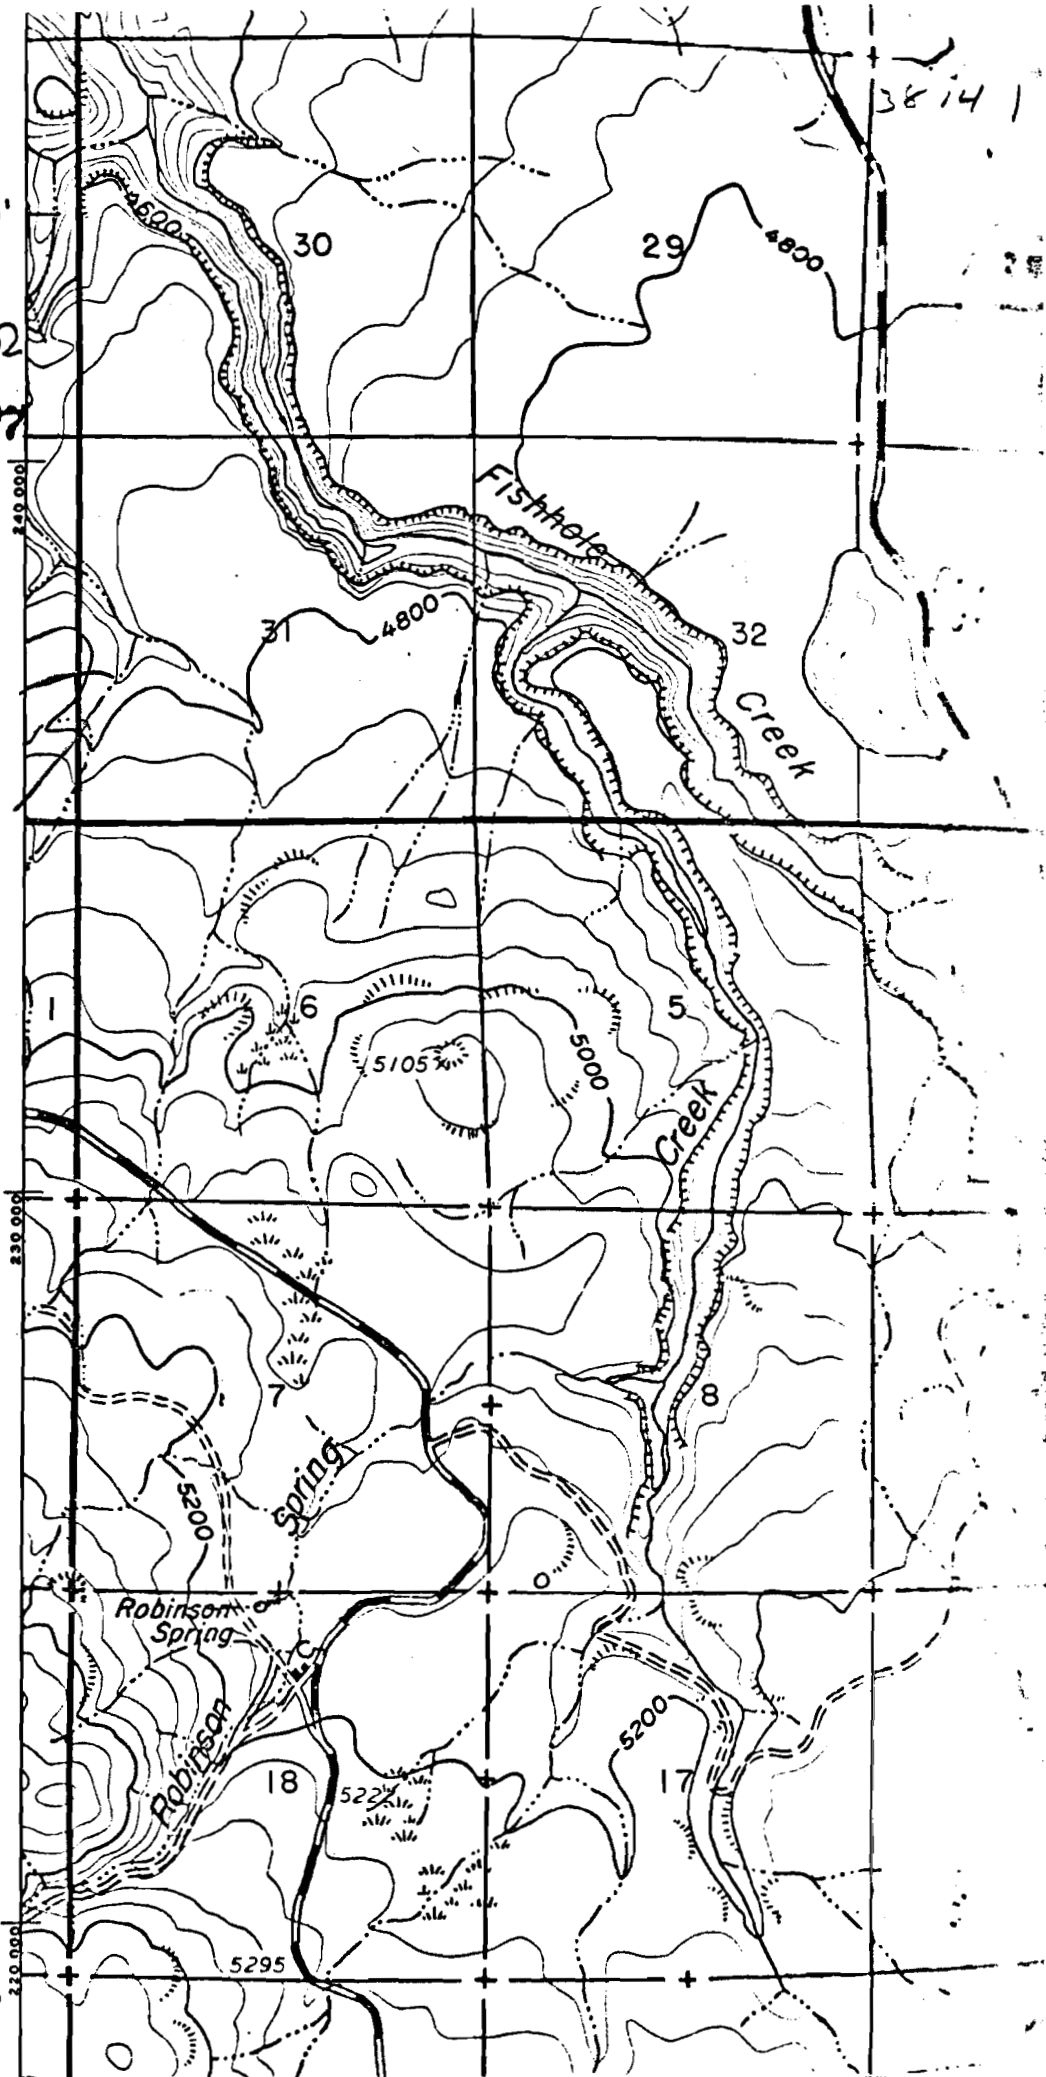

RECEIVED
AUG 19 1981
WATER RESOURCES DEPT
SALEM, OREGON

T.38 S.

RECEIVED

AUL 19 1981.

FIELD MAP SHEET

WATER RESOURCES DEPT
SALEM, OREGON
FREMONT N.F.

T. 38S R. 14E Sec. _____ Subdiv. _____

Mapped by _____ Reviewed by _____ Scale 2 inches = 1 Mile

● RESERVOIR Application No. R-62462 7/20, 19 81

— DRAINAGE Permit No. R 8917
— ROAD

