

R-8919  
**RECEIVED**

AUG 19 1981 59170

WATER RESOURCES DEPT  
SALEM, OREGON

Application No. R-62467  
Permit No. R 8919


38 14 27

# GERBER RESERVOIR QUADRANGLE OREGON

R. 14 E.  
1 850 000

6LY 11 MI.  
1 850 000

121°

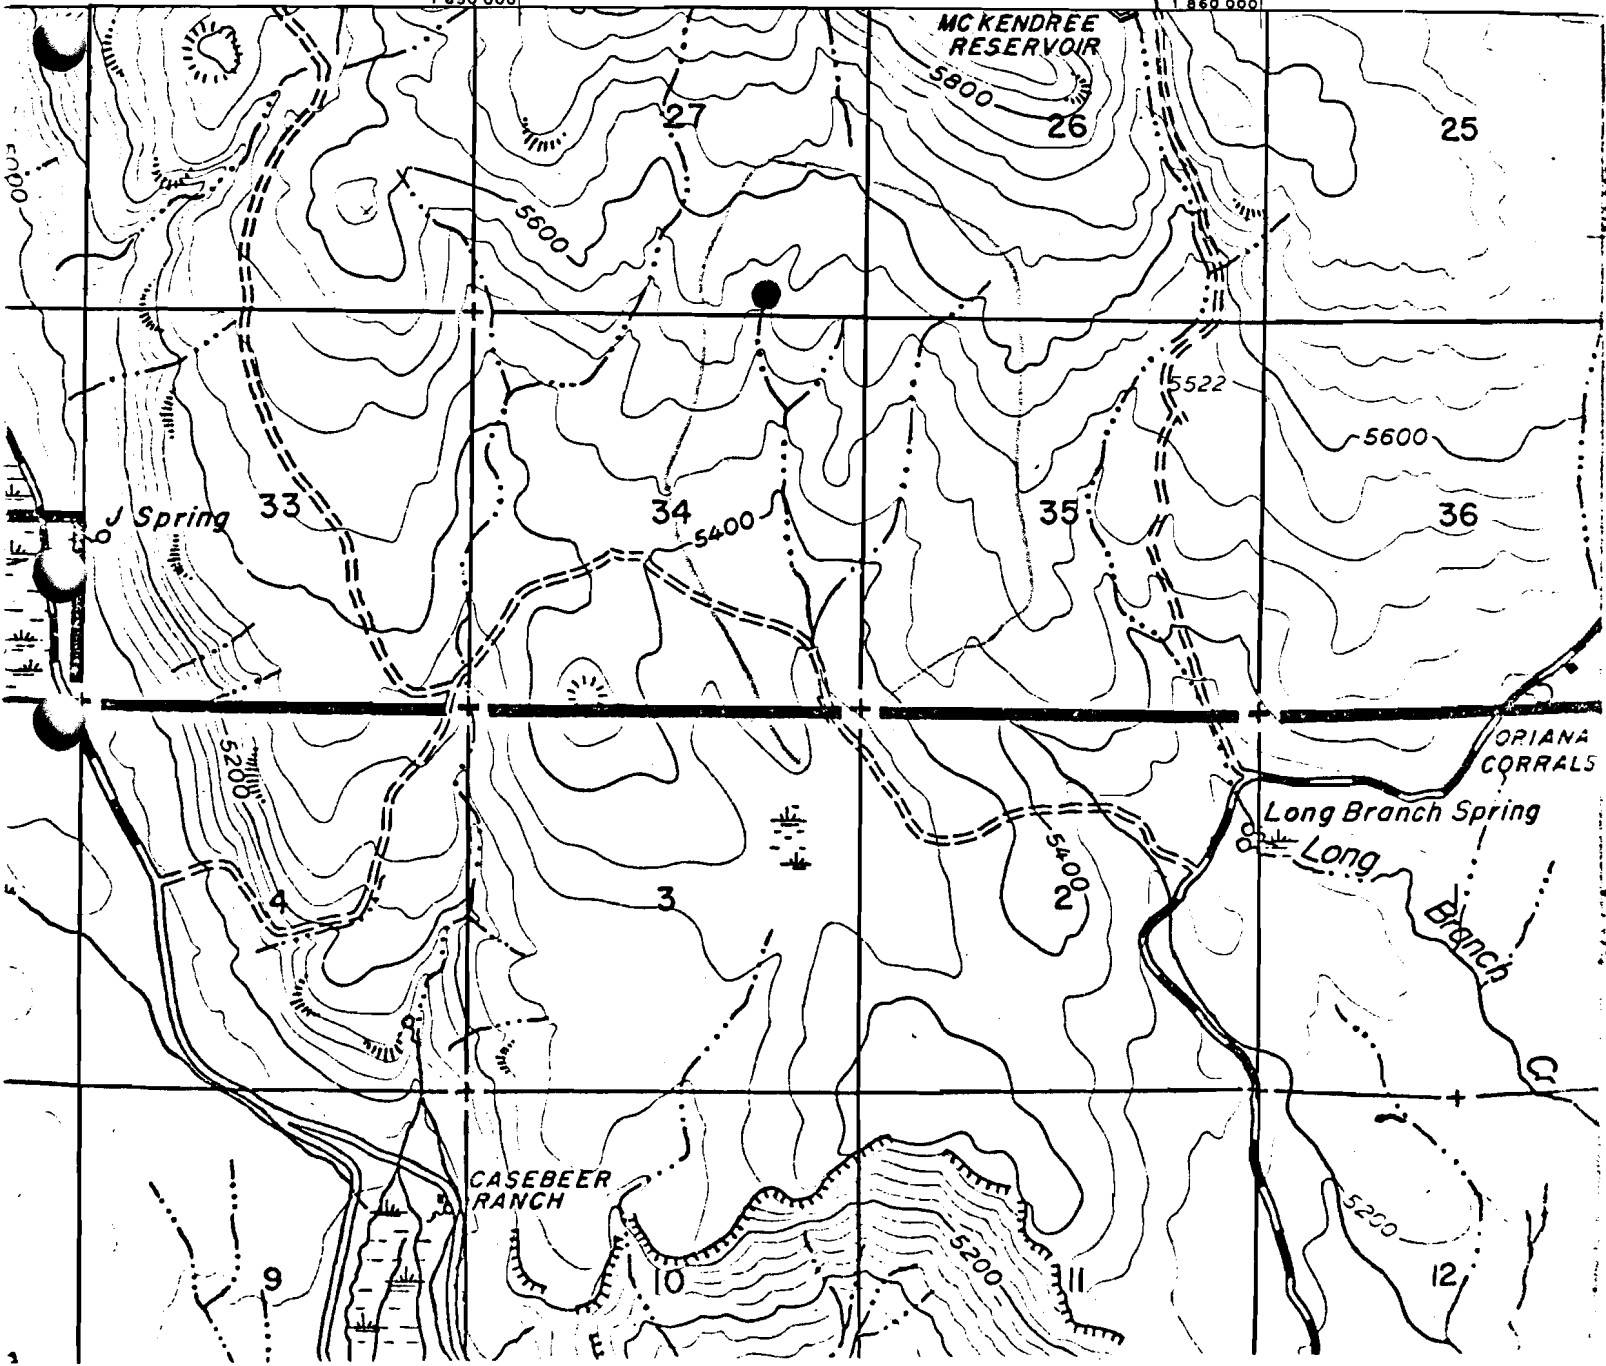

RECEIVED

AUG 19 1981

WATER RESOURCES DEPT  
SALEM, OREGON  
FREMONT N.F.

FIELD MAP SHEET

T. <sup>385</sup>295 R. 14E Sec. .... Subdiv. ....

Mapped by T. OLECHNIAK Reviewed by ..... Scale 2 inches = 1 Mile

RESERVOIR Application No. R-62467 7/7 1981  
DRAINAGE Permit No. R 8919  
ROAD

