

RECEIVED ^{R8922}
59173

AUG 19 1981

FIELD MAP SHEET

WATER RESOURCES DEPT

SALEM, OREGON

FREMONT

N.F.

T. 38S R. 15E Sec. _____ Subdiv. _____


Mapped by T. OLENICHAK Reviewed by _____ Scale 2 inches = 1 Mile

● RESERVOIR Application No. R-62470 7/8, 1981

— DRAINAGE

— ROAD

Permit No. R 8922

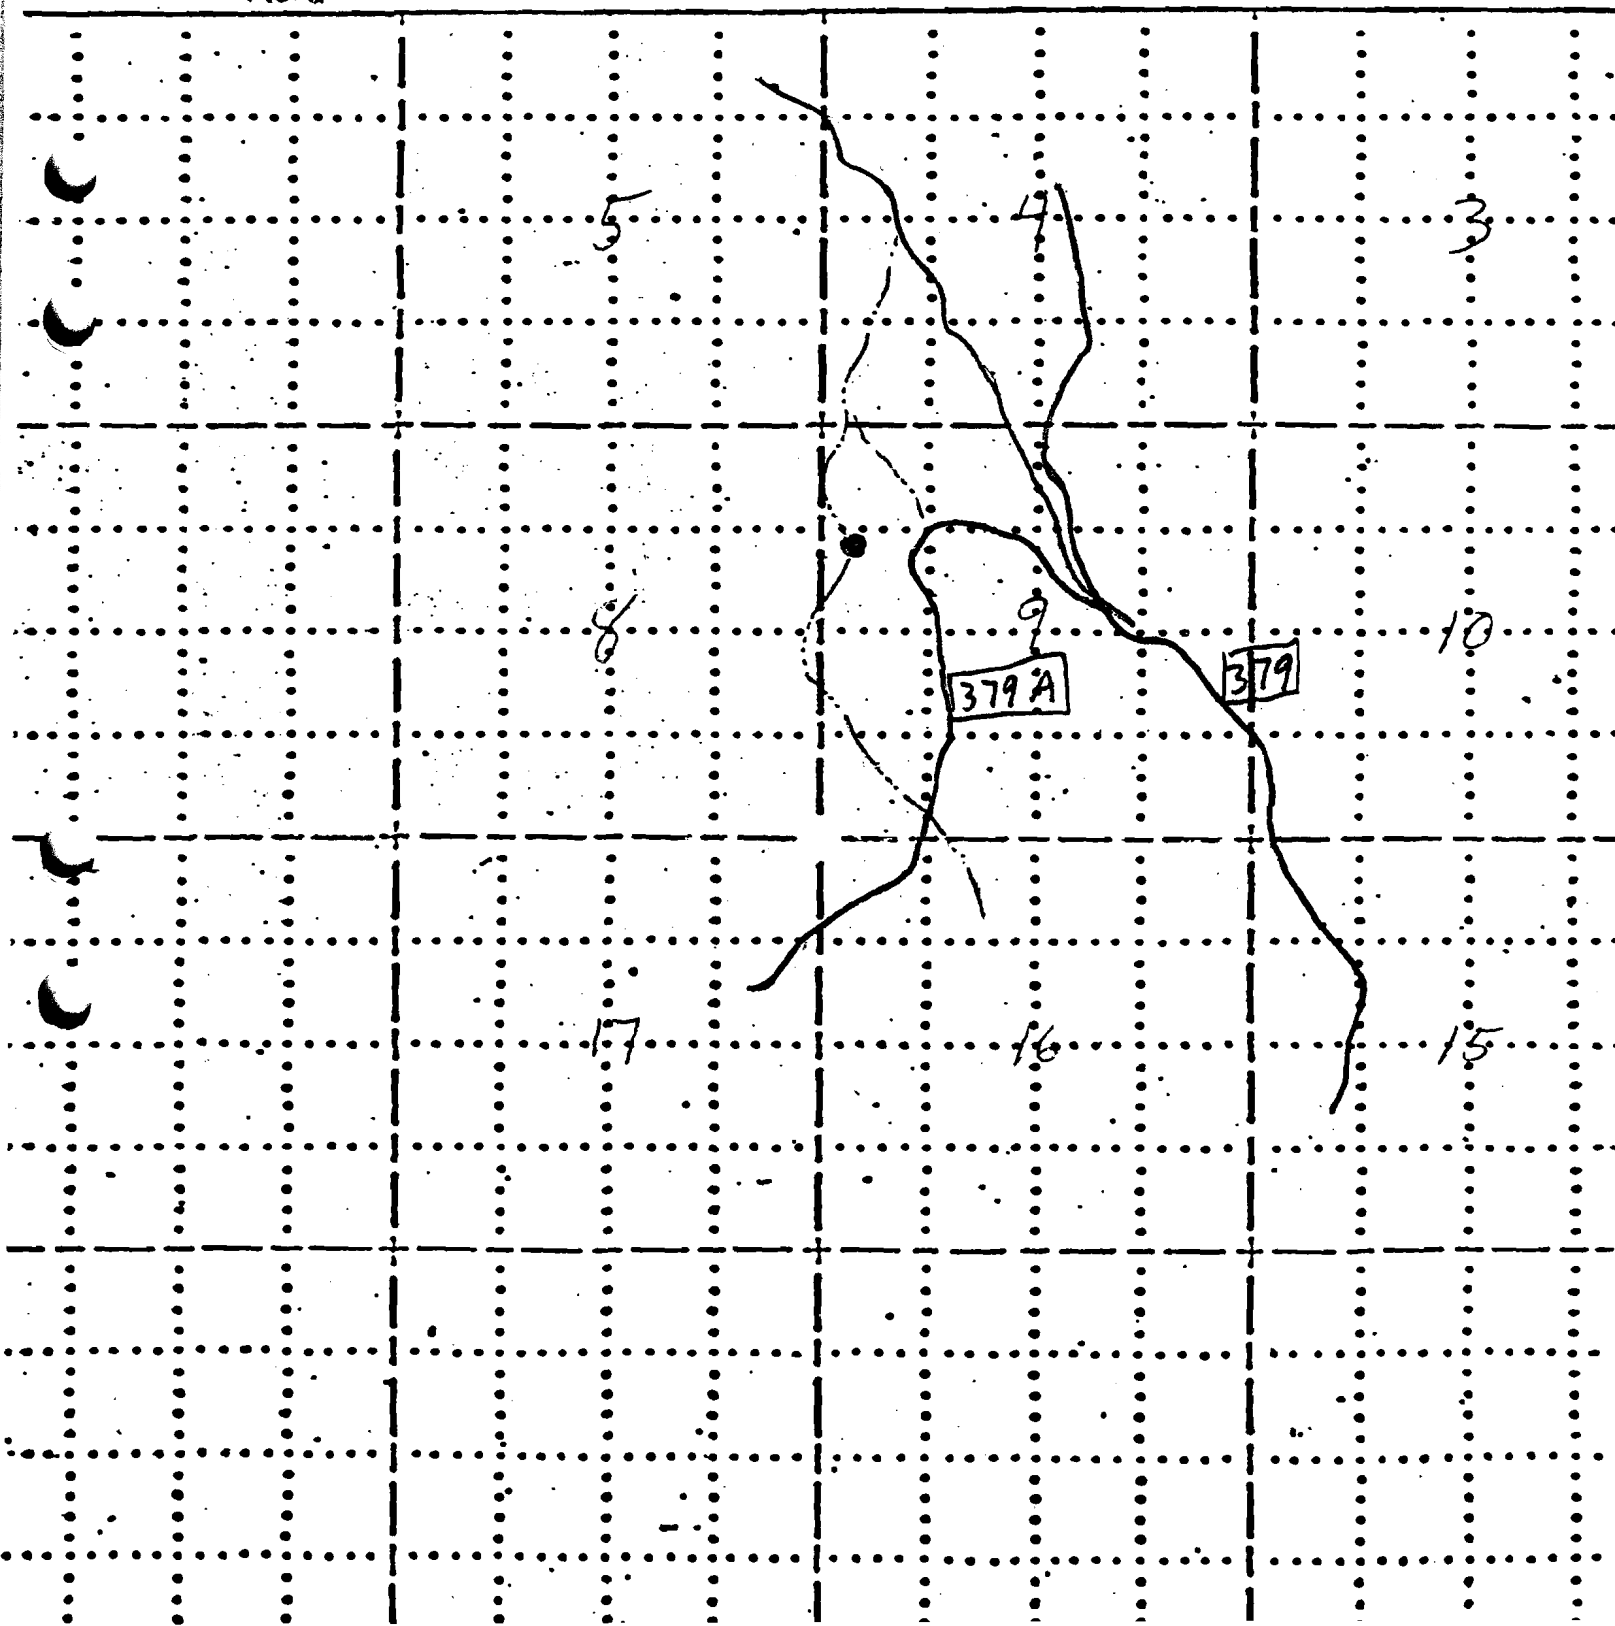

Application No. R-62470

Permit No. 8922

R-8922
39173

RECEIVED

AUG 19 1981

WATER RESOURCES DEPT
SALEM, OREGON

