

RECEIVED R8923
59174

FIELD MAP SHEET

AUG 19 1981

WATER RESOURCES DEPT

SALEM, OREGON

FREMONT

N.F.

T. 38 S R. 15 E Sec. Subdiv.

Mapped by _____ Reviewed by _____

Scale 2 inches = 1 Mile

RESERVOIR Application No. R-62471


7/20

1981

— DRAINAGE


Permit No. R 8923

— ROAD

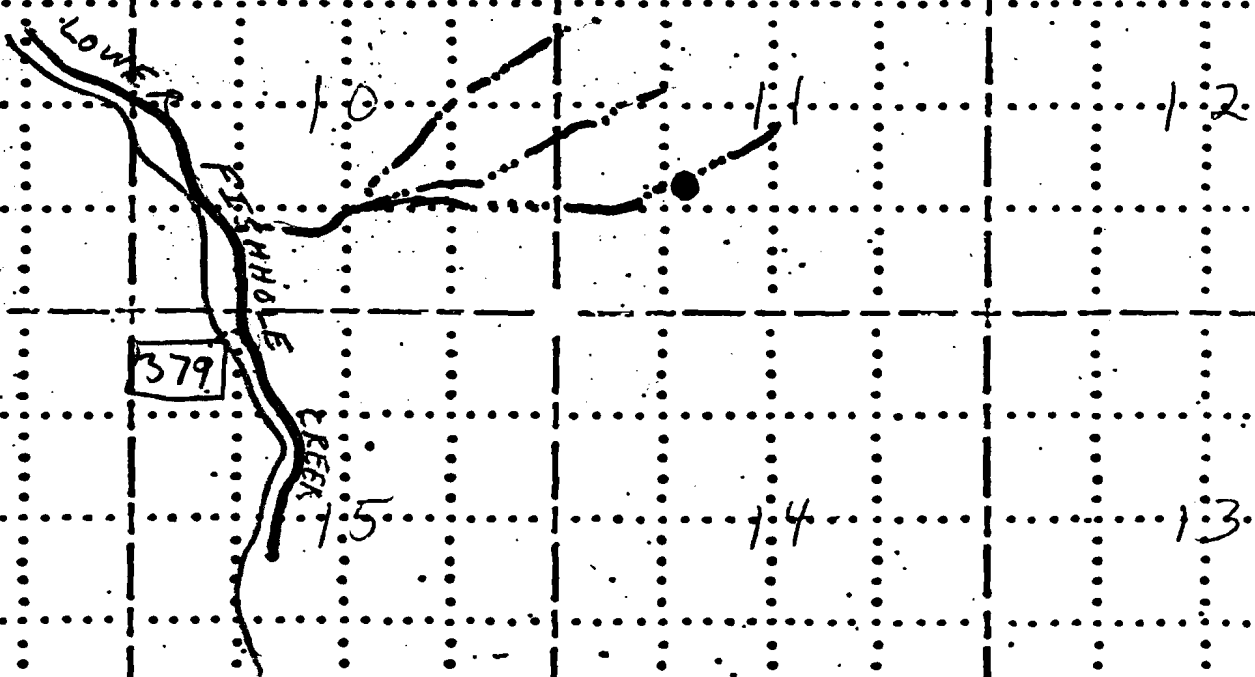

R-8923
59174
38 15 11

Application No. R-62471
Permit No. R-8923

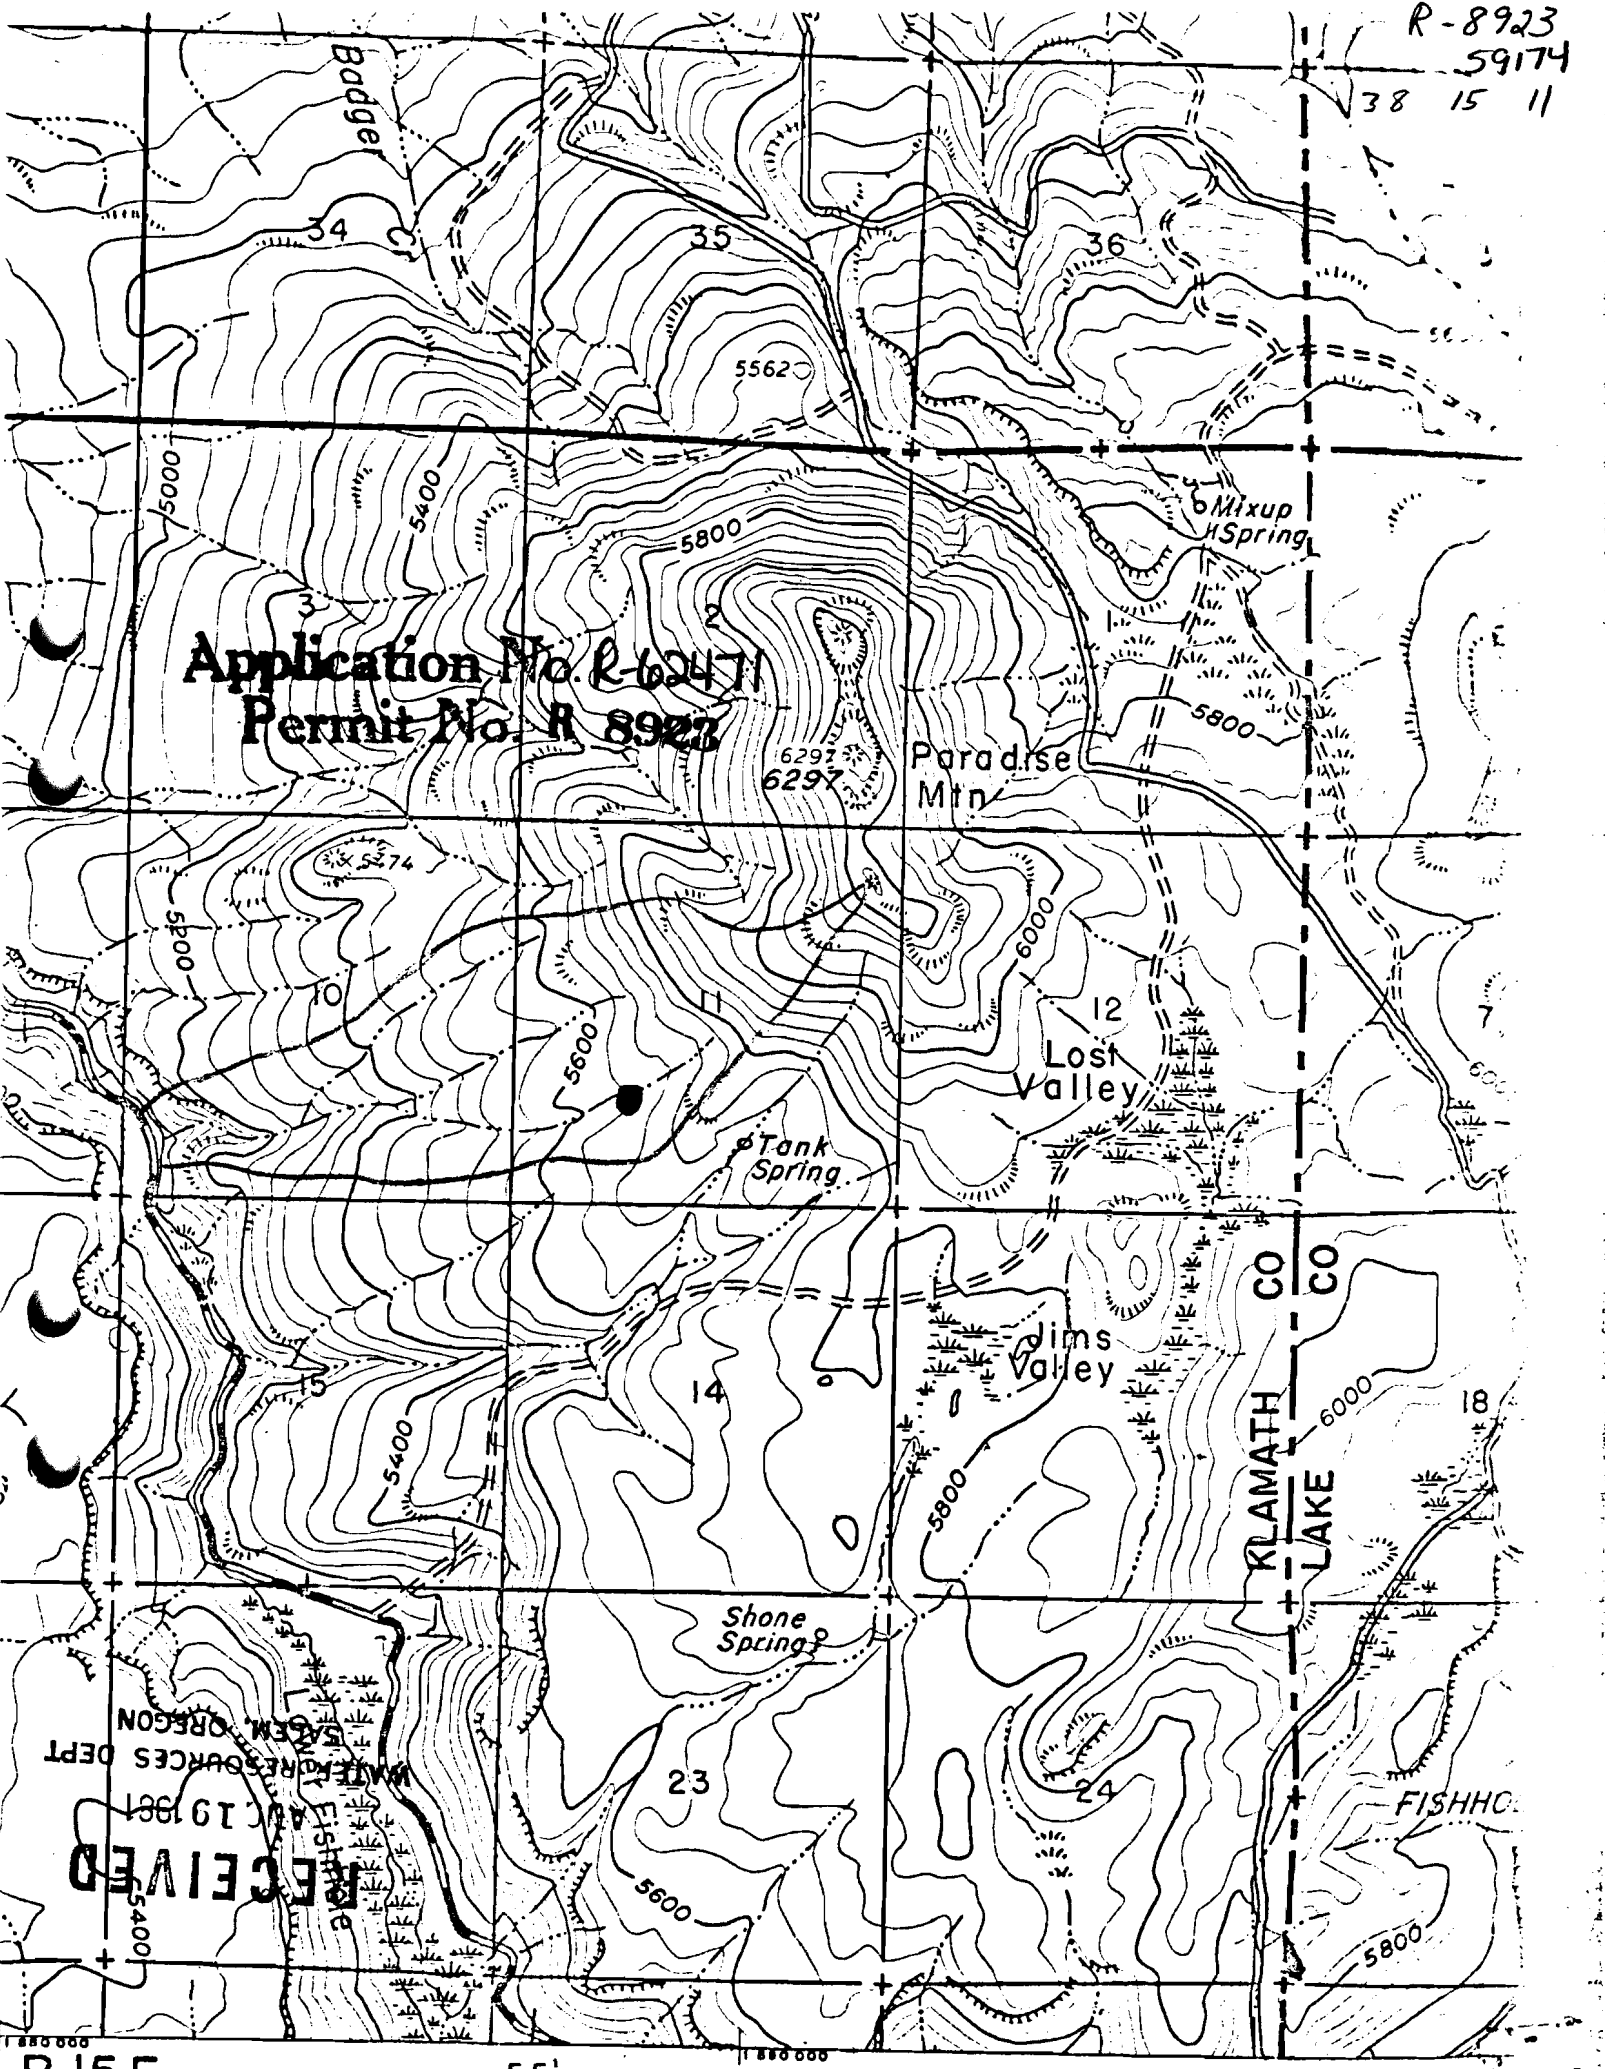

KLAMATH LAKE

RECEIVED
WATER RESOURCES DEPT

R.15E.

55'

