

RECEIVED

R8924
59175

AUG 19 1981

FIELD MAP SHEET WATER RESOURCES DEPT
SALEM, OREGON

T. 37S / 38S R. 14E Sec. _____ Subdiv. _____ FREMONT N.E.


Mapped by _____ Reviewed by _____ Scale 2 inches = 1 Mile

- RESERVOIR
- DRAINAGE
- ROAD

Application No. R-62472

7/21 _____, 1981

Permit No. R 8924

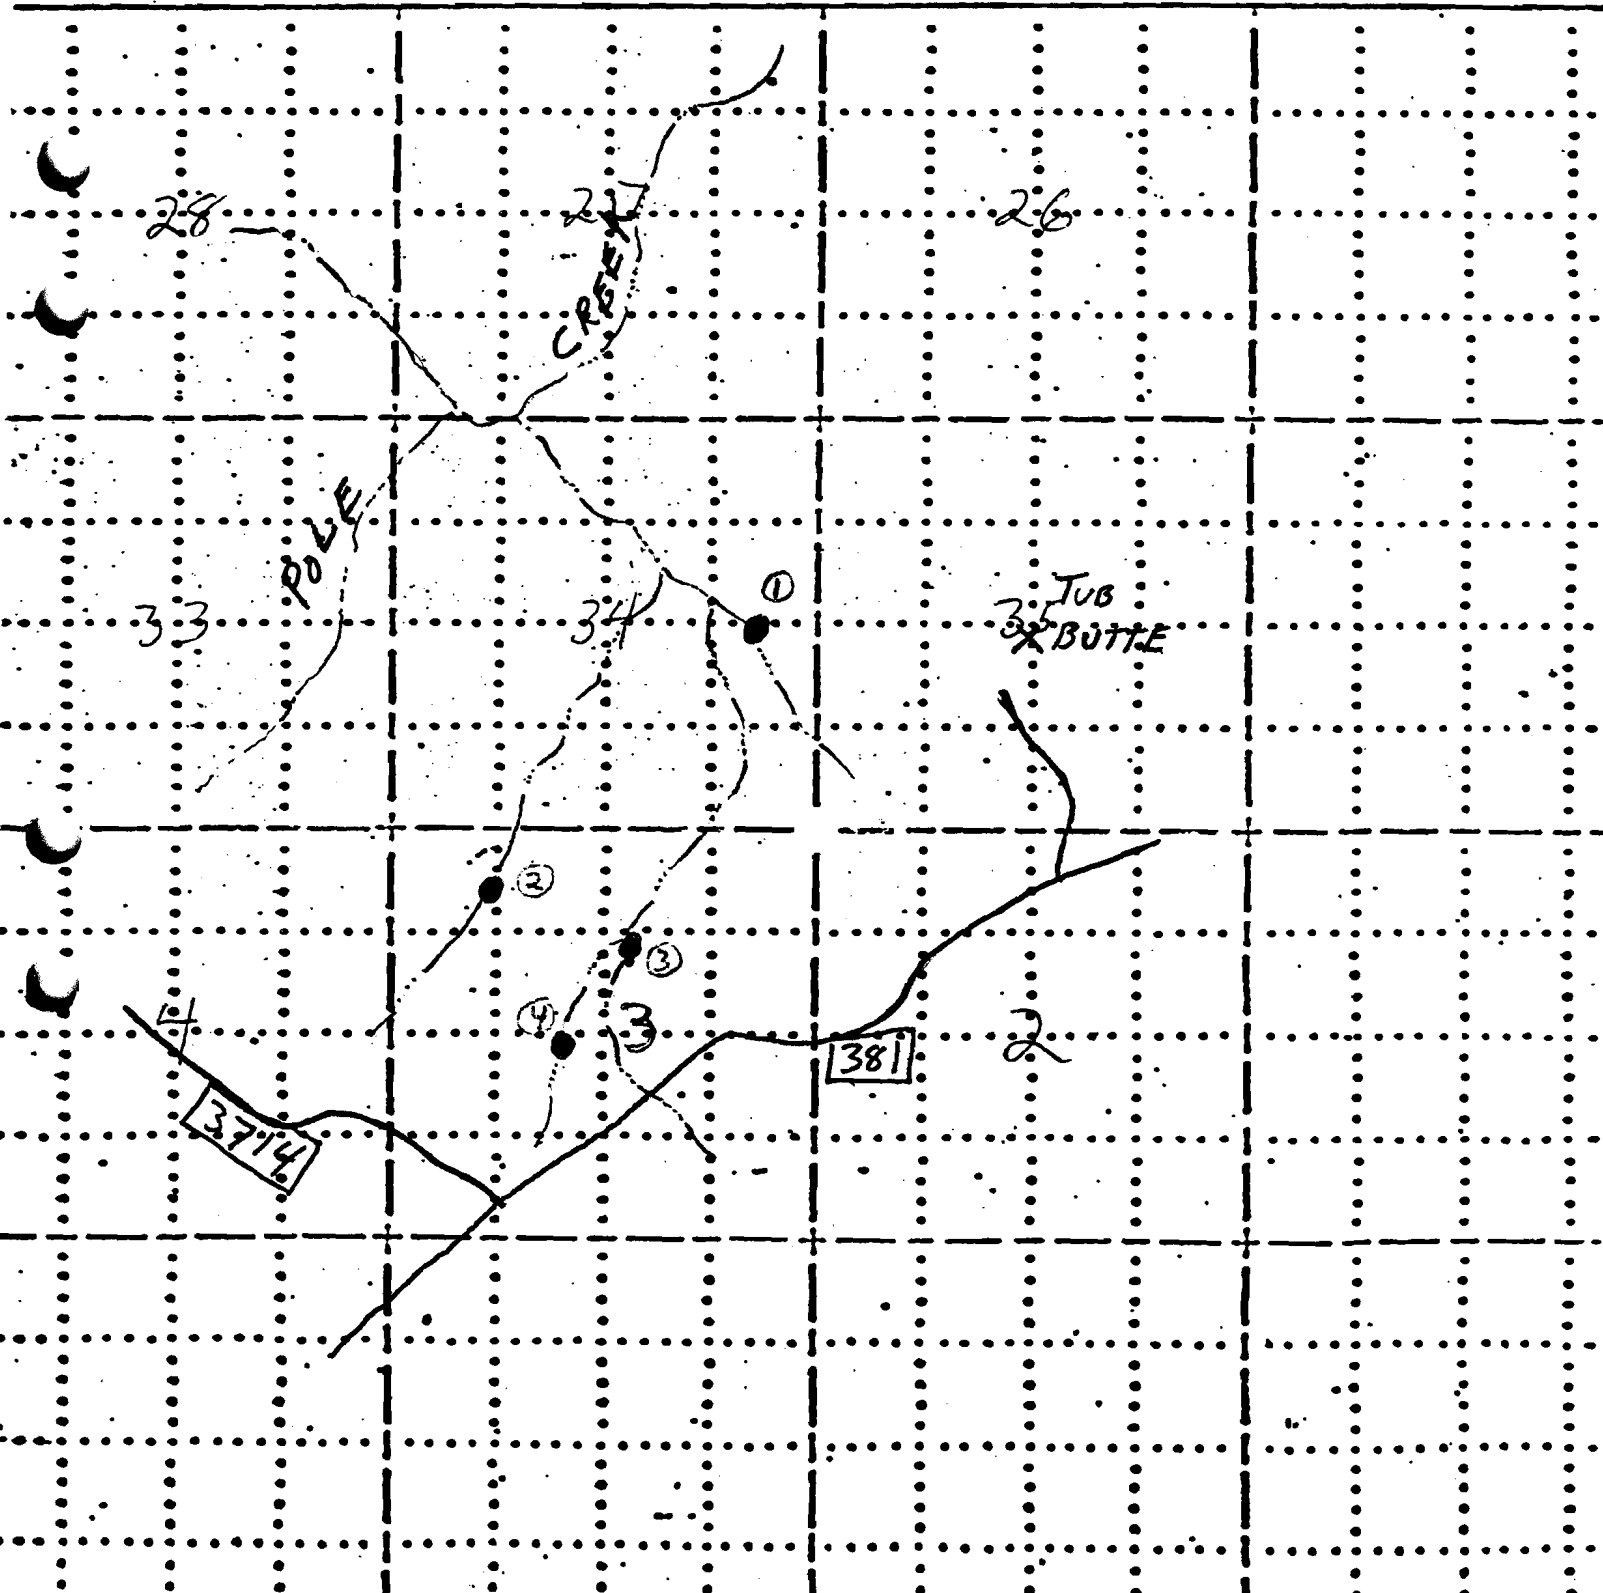

R-8924

RECEIVED

AUG 19 1981

WATER RESOURCES DEPT.
SALEM, OREGON

Application No. R-62472
Permit No. R-8924

25	37	14	34
38	14	3	

