

FIELD MAP SHEET

AUG 19 1981


WATER RESOURCES DEPT
SALEM, OREGON

T. 34S R. 13E Sec. _____ Subdiv. _____ FREMONT N.F.

Mapped by _____ Reviewed by _____ Scale 2 inches = 1 Mile

- RESERVOIR
- DRAINAGE
- ROAD

Application No. R-62475 7/20, 1981
Permit No. R 8926

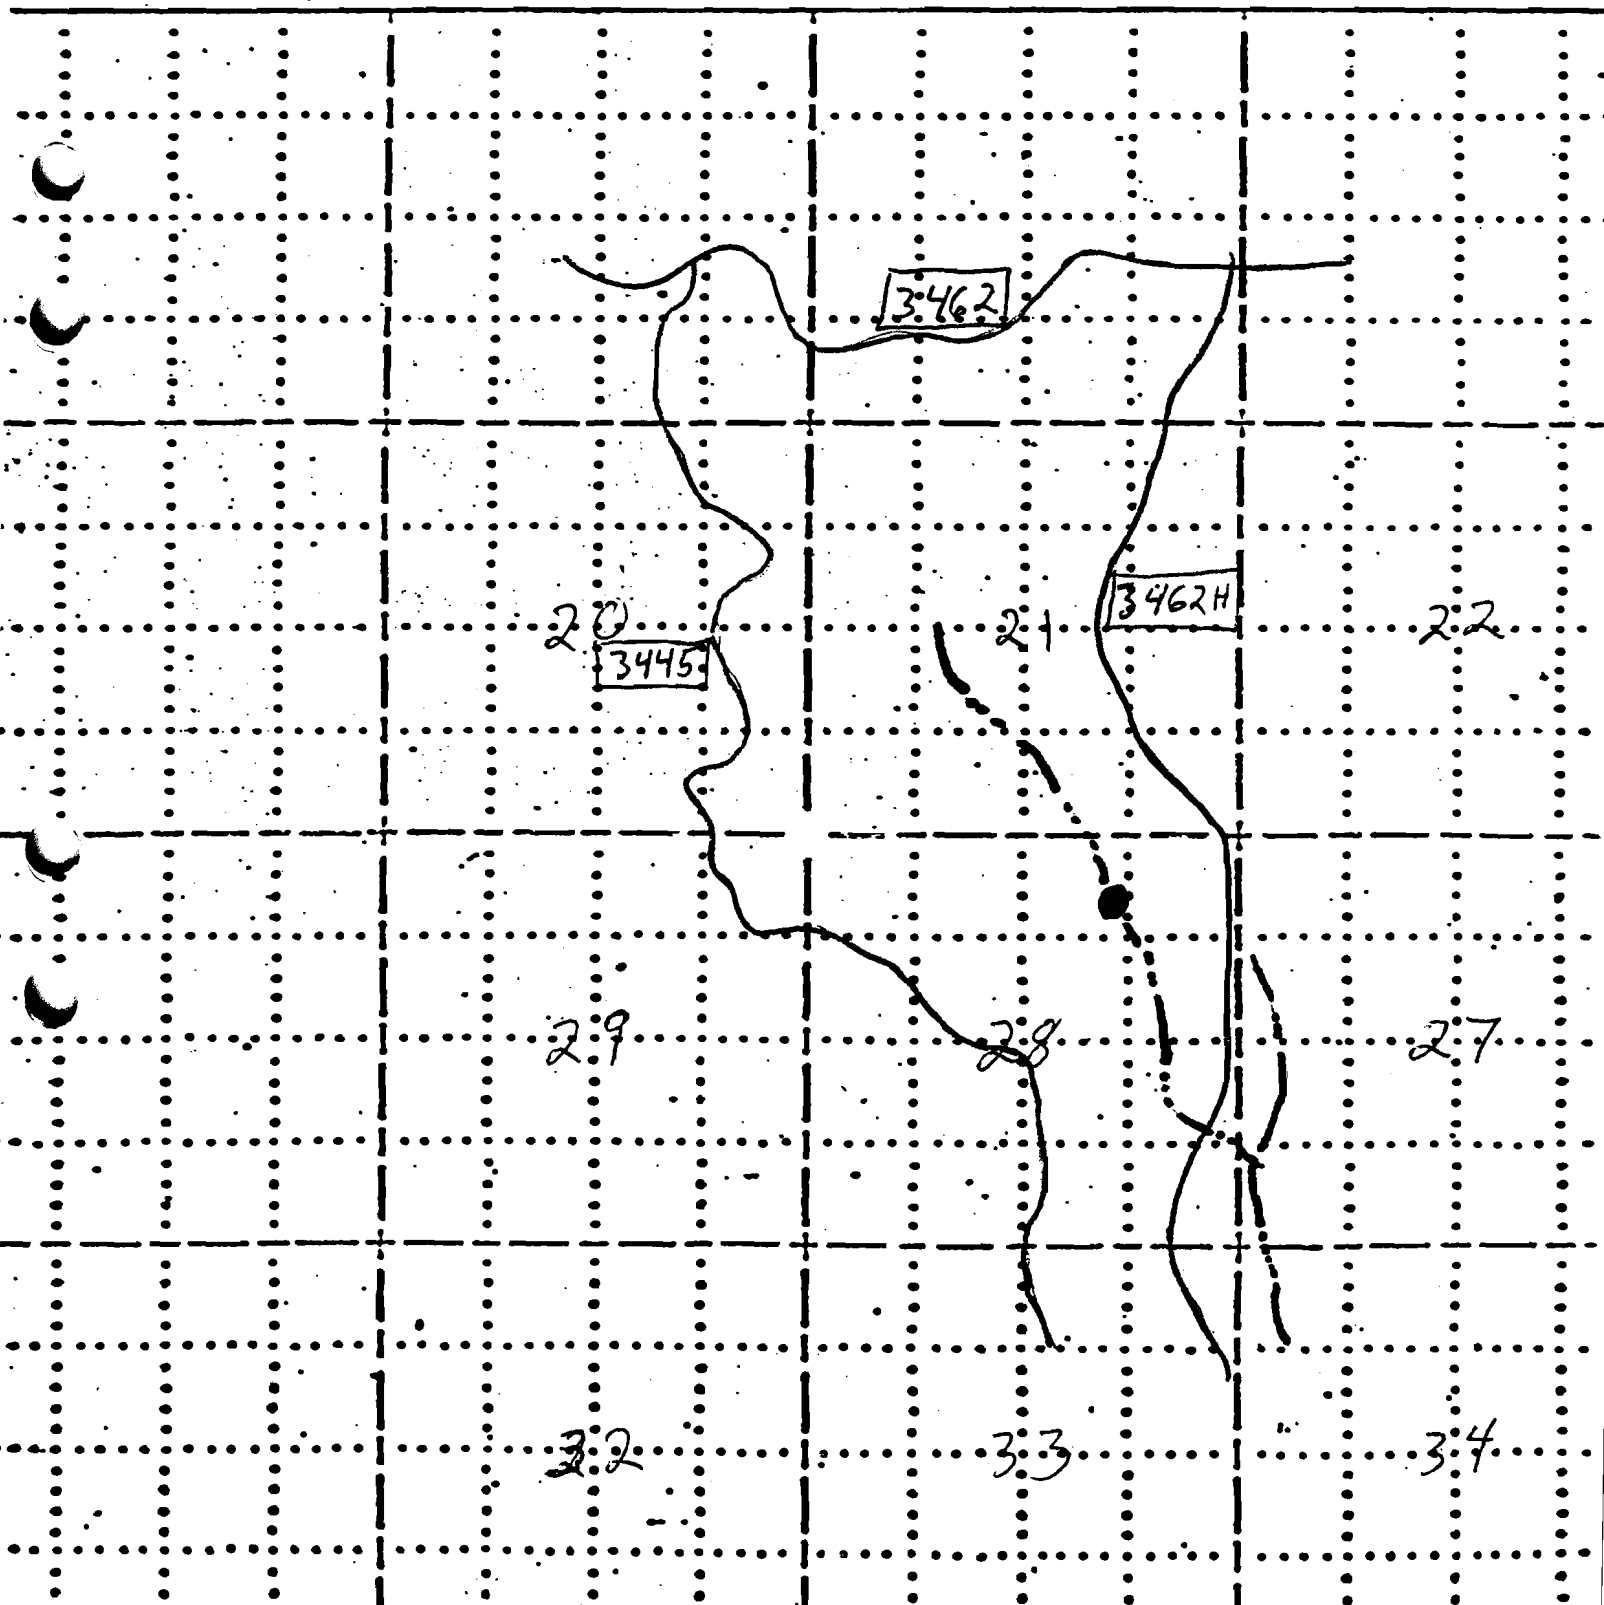

R-8926
5977

34 13 28

RECEIVED

AUG 19 1981

WATER RESOURCES DEPT
5161 SALEM, OREGON

Application No. R-62475

Permit No. R 8926

