

AUG 19 1981 59178

FIELD MAP SHEET

WATER RESOURCES DEPT

SALEM, OREGON

FREMONT

N.F.


T. 35S R. 13E Sec. Subdiv.

Mapped by Reviewed by Scale 2 inches = 1 Mile

RESERVOIR Application No. R-62476 7/20, 1981

DRAINAGE
ROAD

Permit No. R 8927

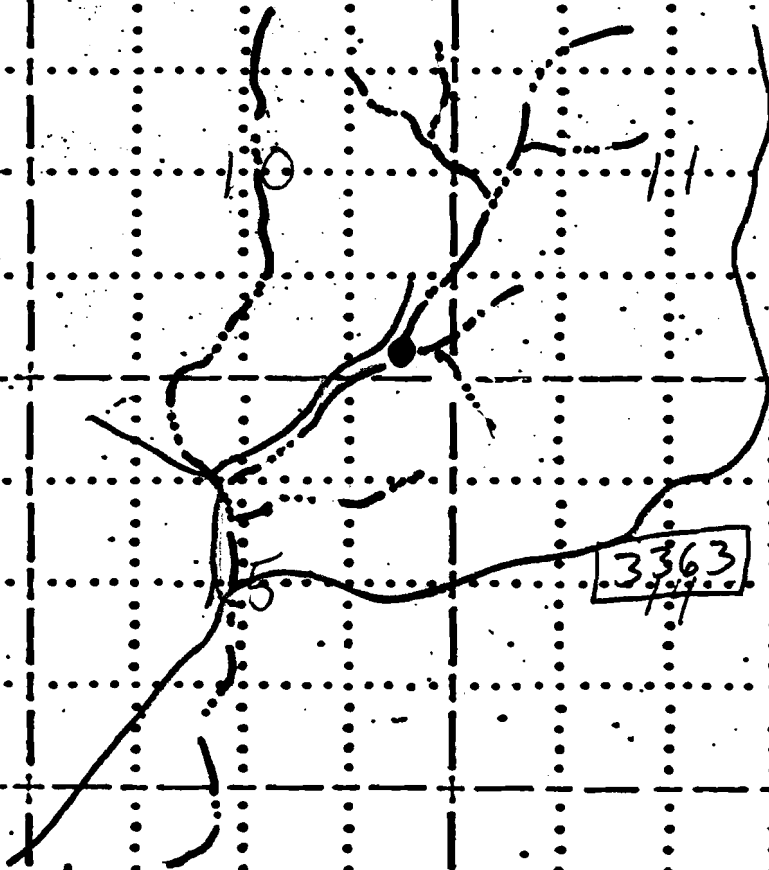

4

3

2

9


10

11

16

15

3363
7/20

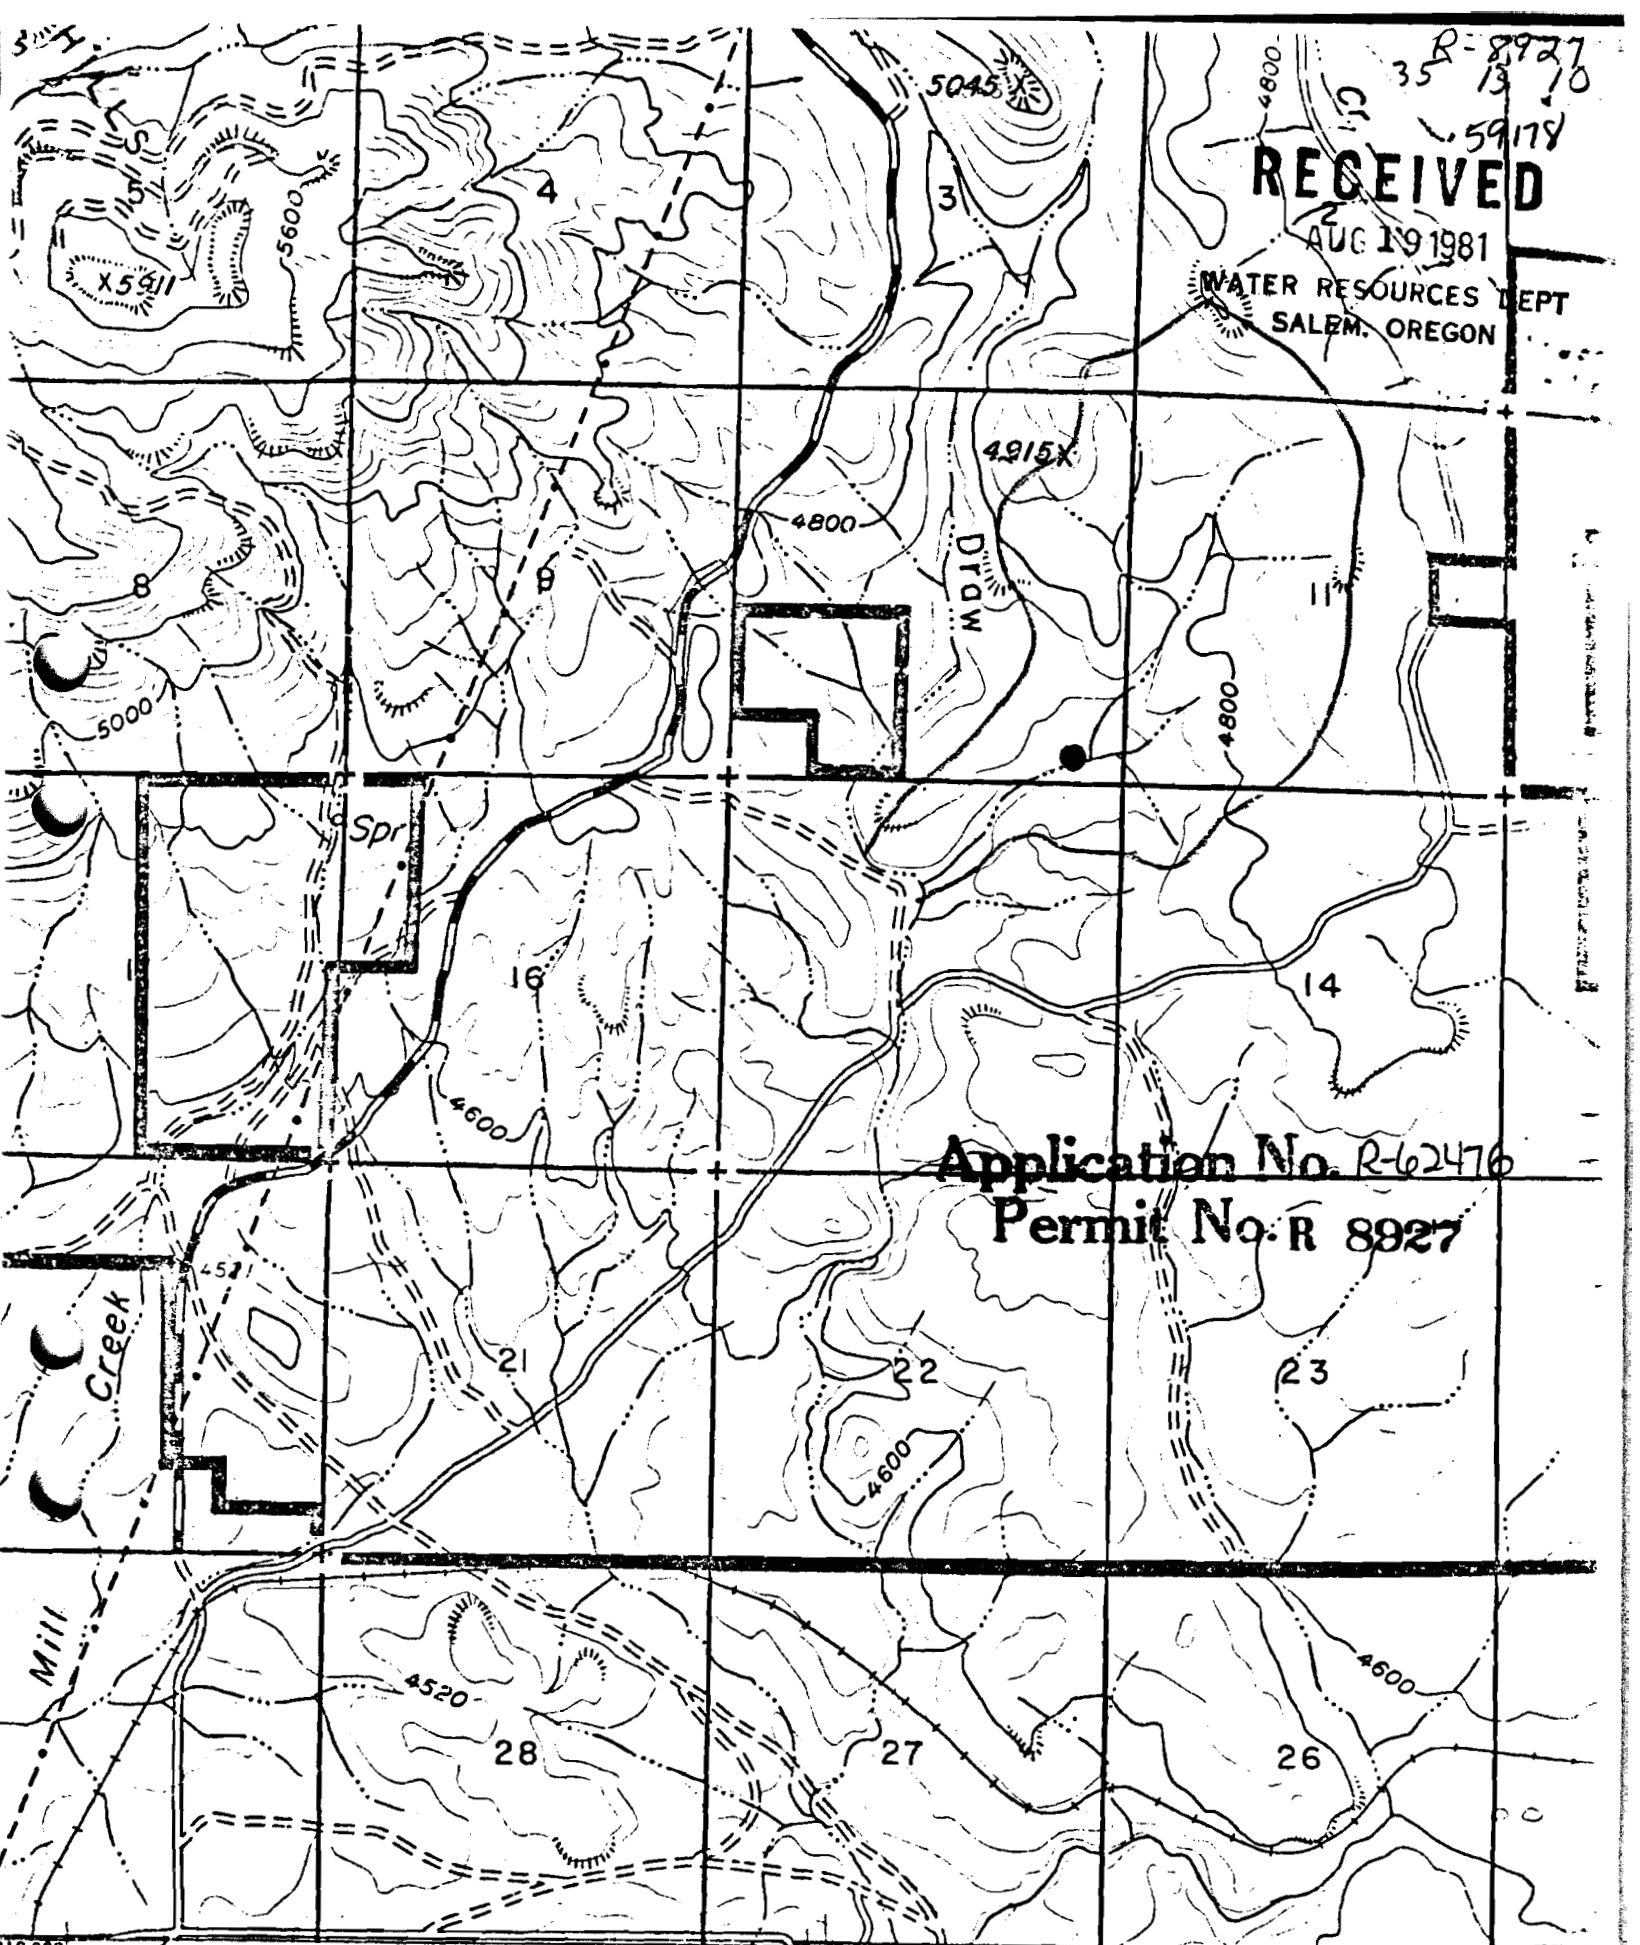

R-8927
35 13 70
59178
RECEIVED
AUG 19 1981
WATER RESOURCES DEPT
SALEM, OREGON

Application No. R-62476
Permit No. R 8927

BEATTY 5.8 MI

R. 13 E. 10

SCAL

enlargement

