

RECEIVED

R 8928
59179

FIELD MAP SHEET

AUG 19 1981

WATER RESOURCES DEPT

SALEM, OREGON

FREMONT

N.F.

T. 35S R. 13E Sec. _____ Subdiv. _____


Mapped by _____ Reviewed by _____ Scale 2 inches = 1 Mile

- RESERVOIR
- DRAINAGE
- ROAD

Application No. R-62477

7/20, 1981

Permit No. R 8928

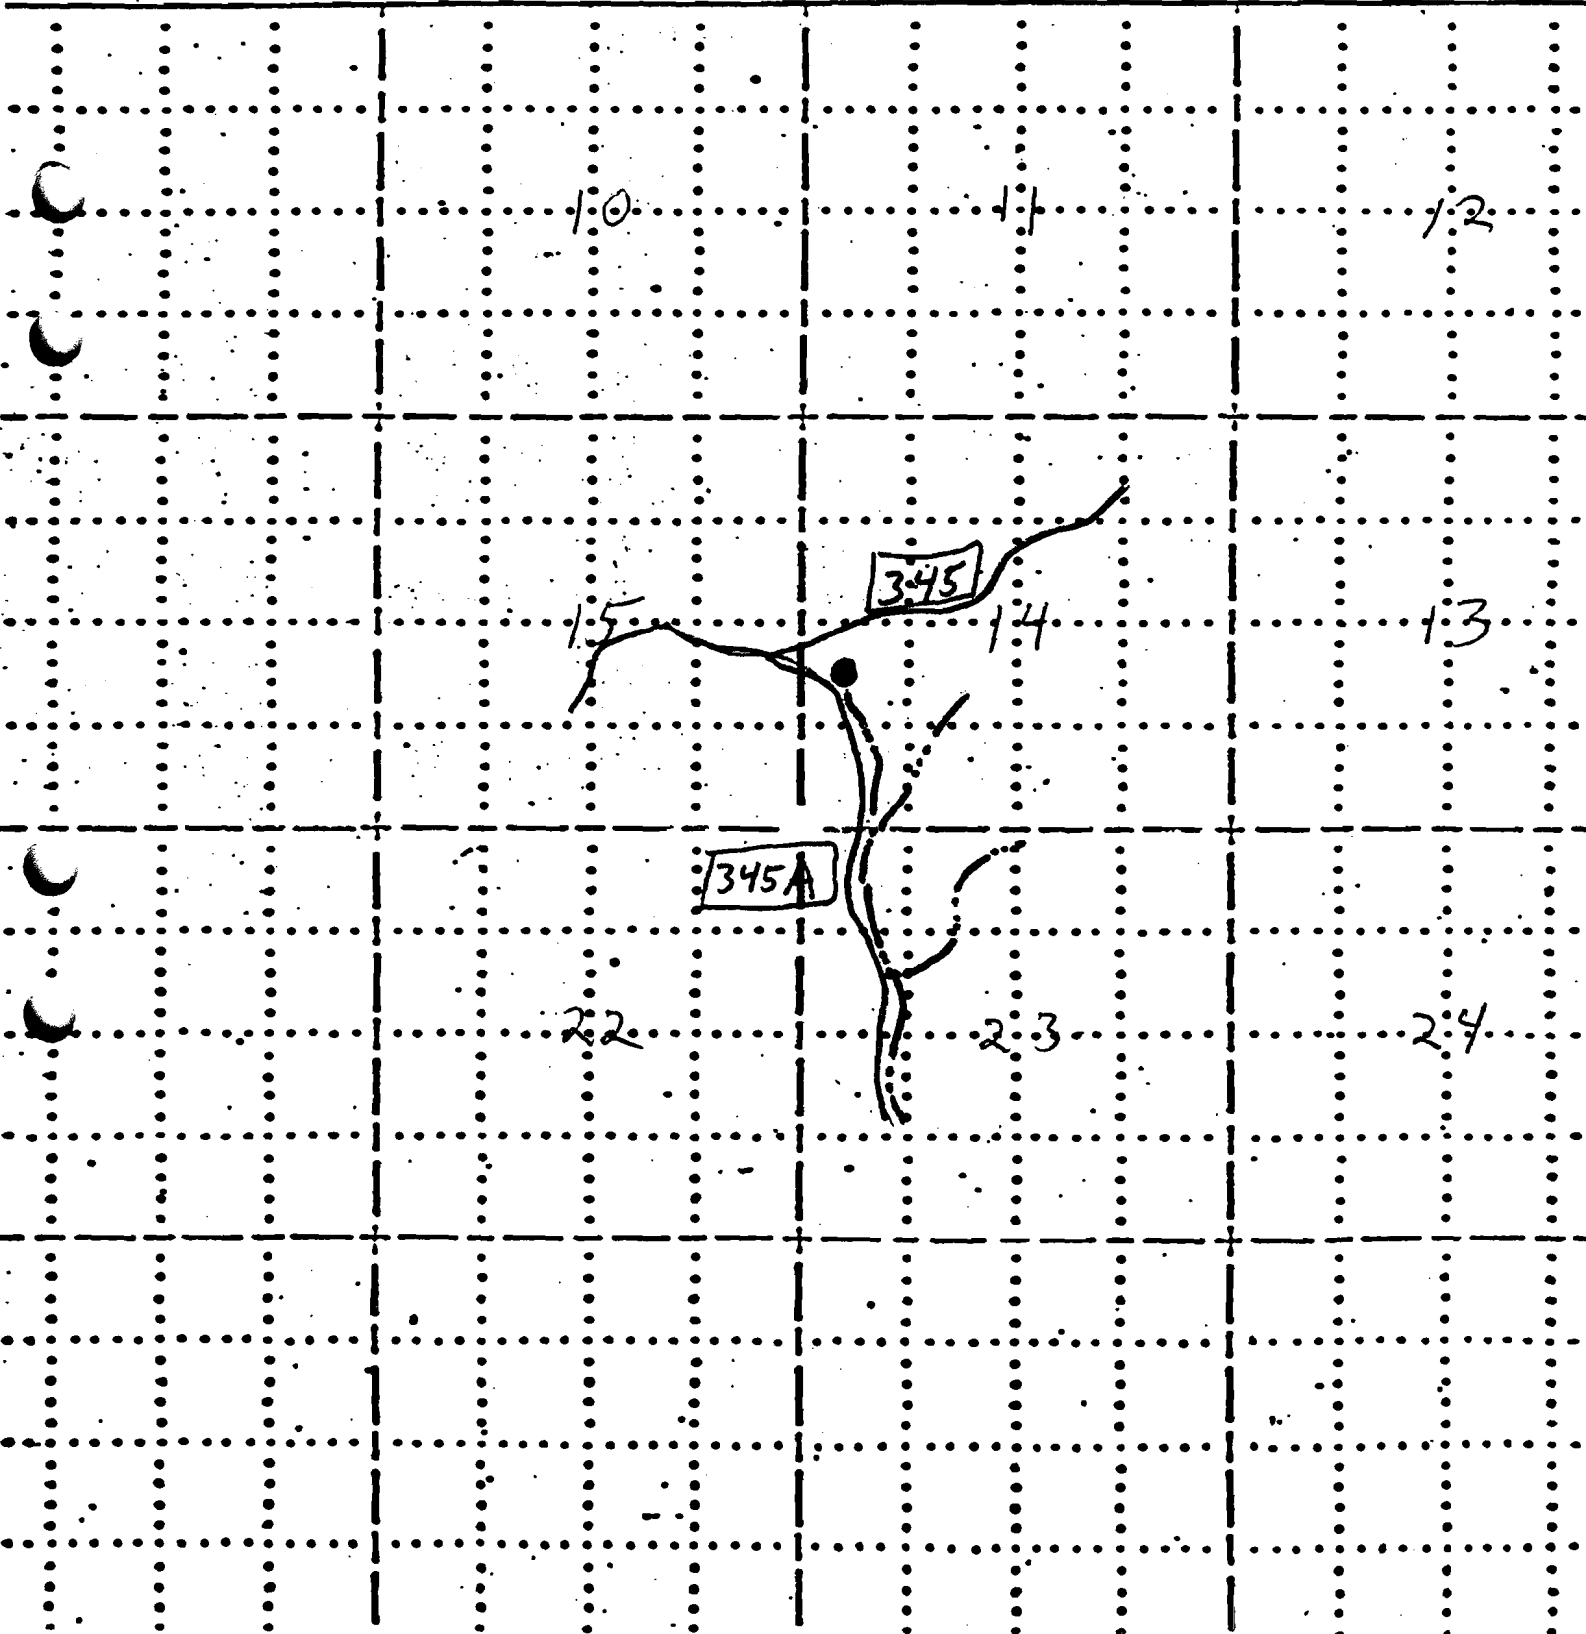


R-8928
59179

35 13 14
RECEIVED

AUG 19 1981

WATER RESOURCES DEPT
SALEM OREGON

Application No. R-6247A
Permit No. R 8928

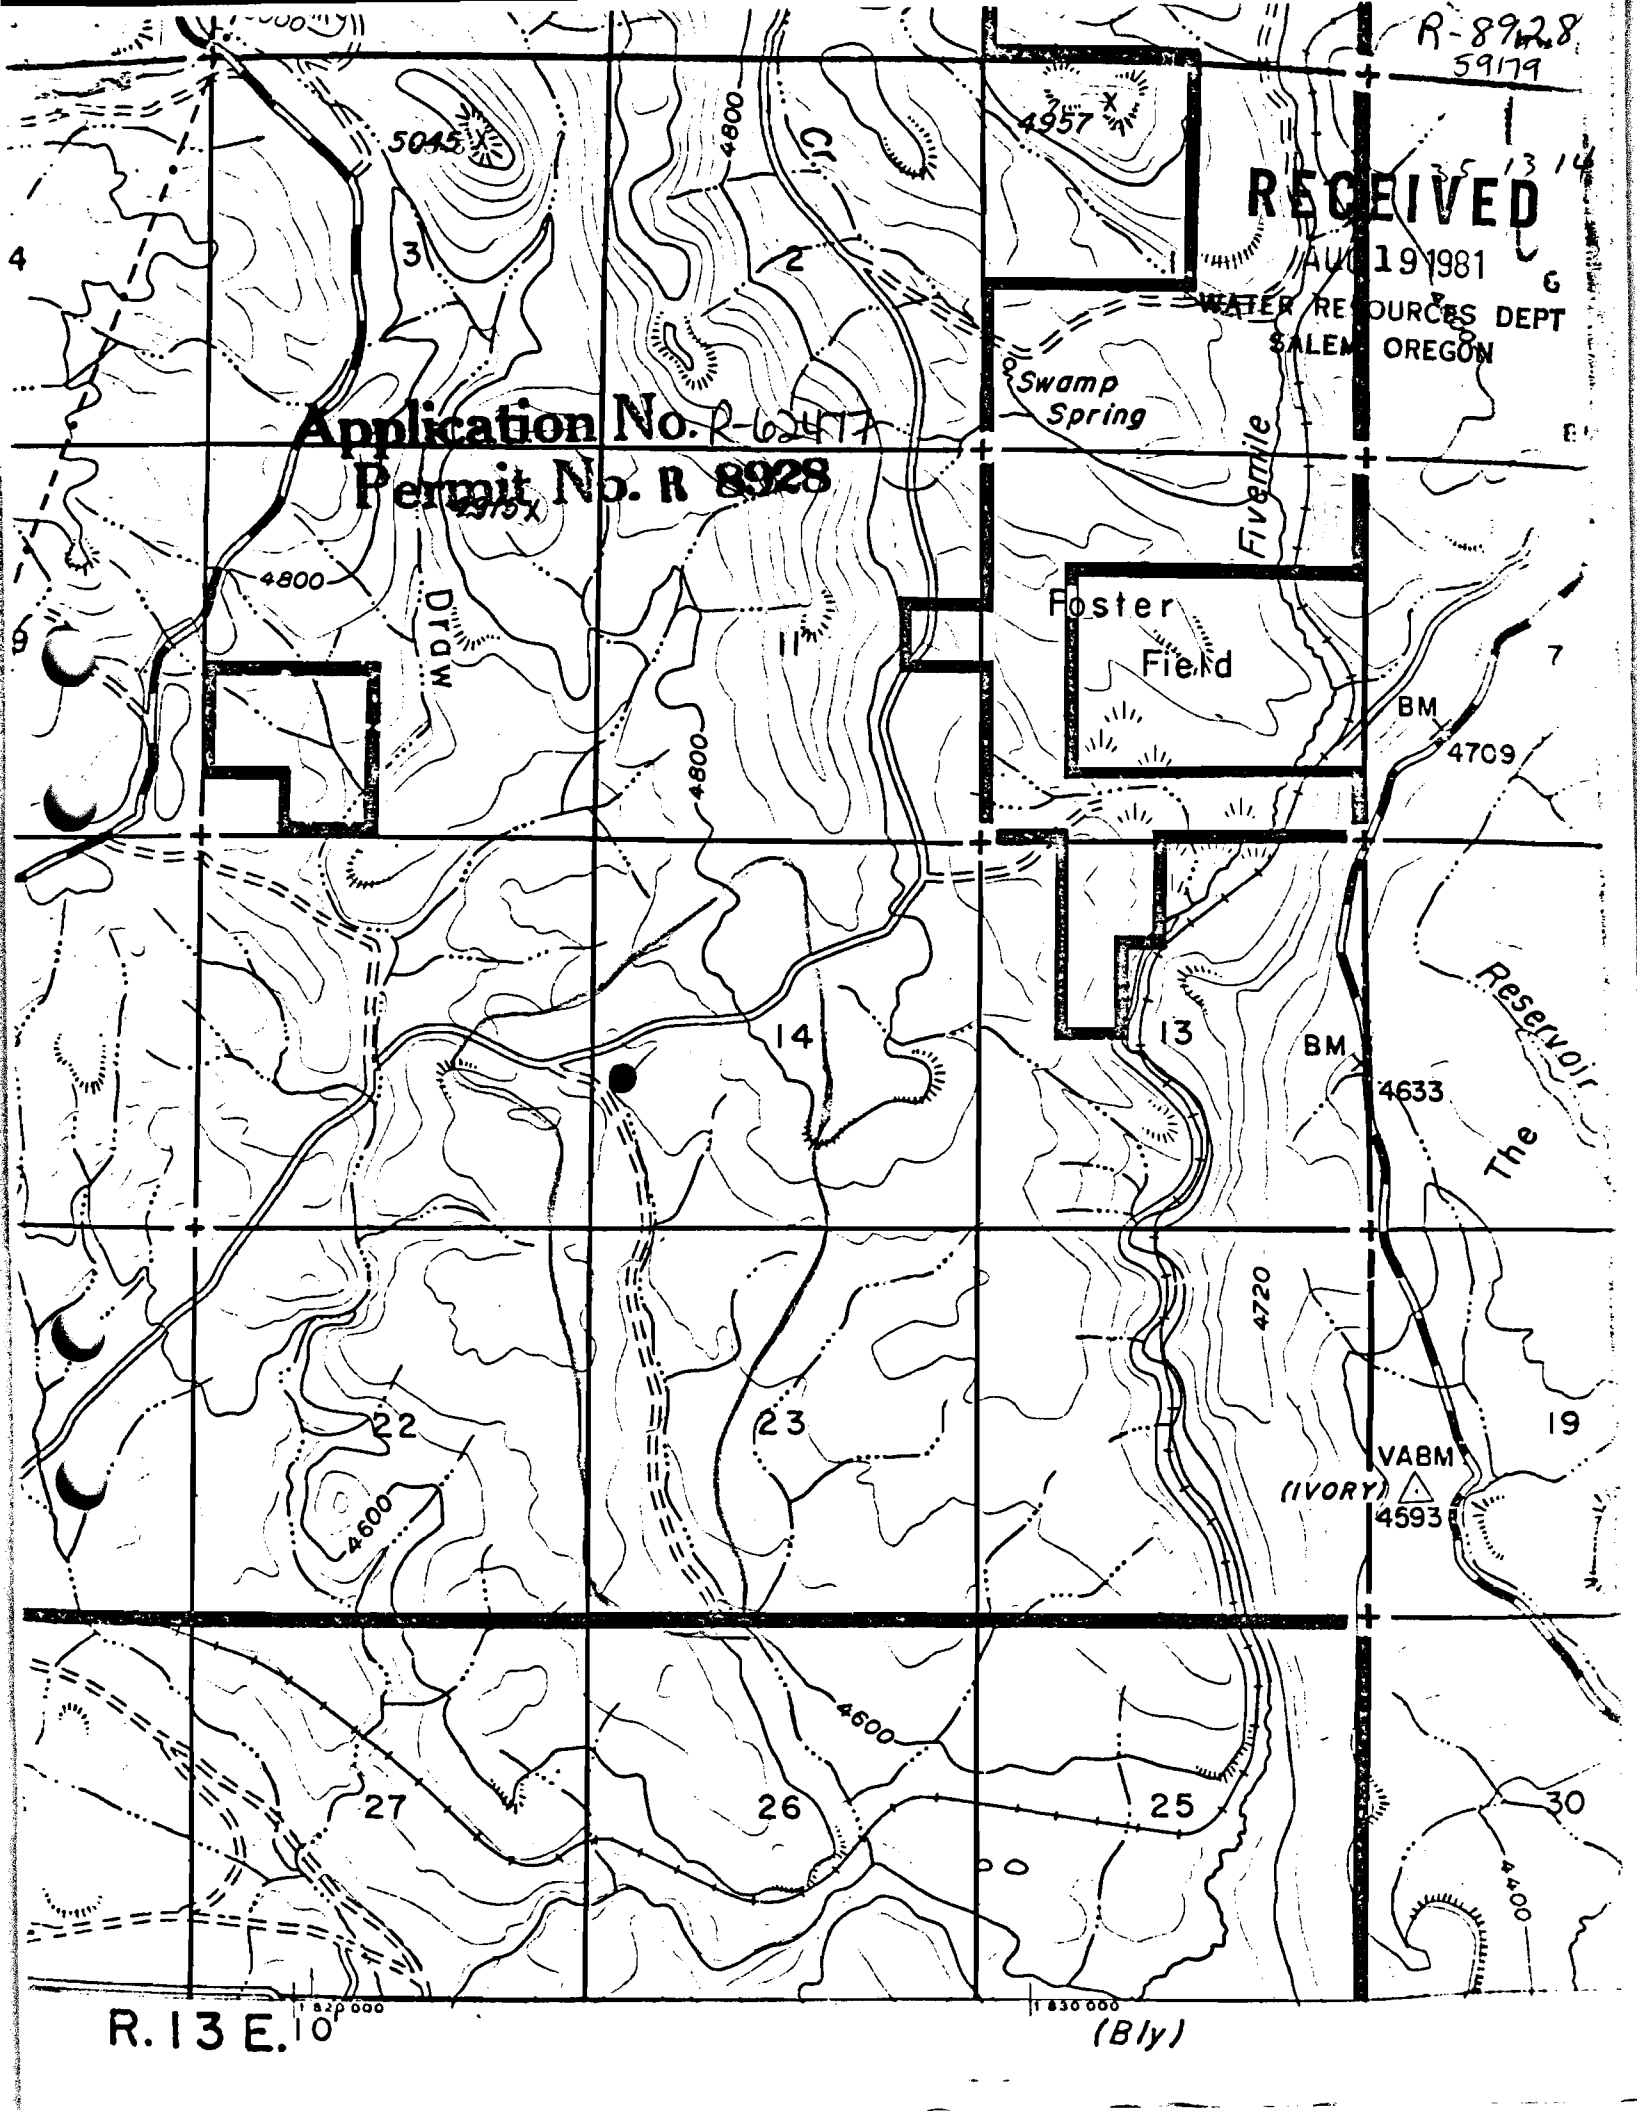

R.13 E.10

(Bly)