


FIELD MAP SHEET WATER RESOURCES DEPT
SALEM, OREGON

T. 36S R. 13E Sec. Subdiv. FREMONT N.F.

Mapped by Reviewed by Scale 2 inches = 1 Mile

- RESERVOIR
- DRAINAGE
- ROAD

Application No. R-62480 7/21 1981
Permit No. R-8931

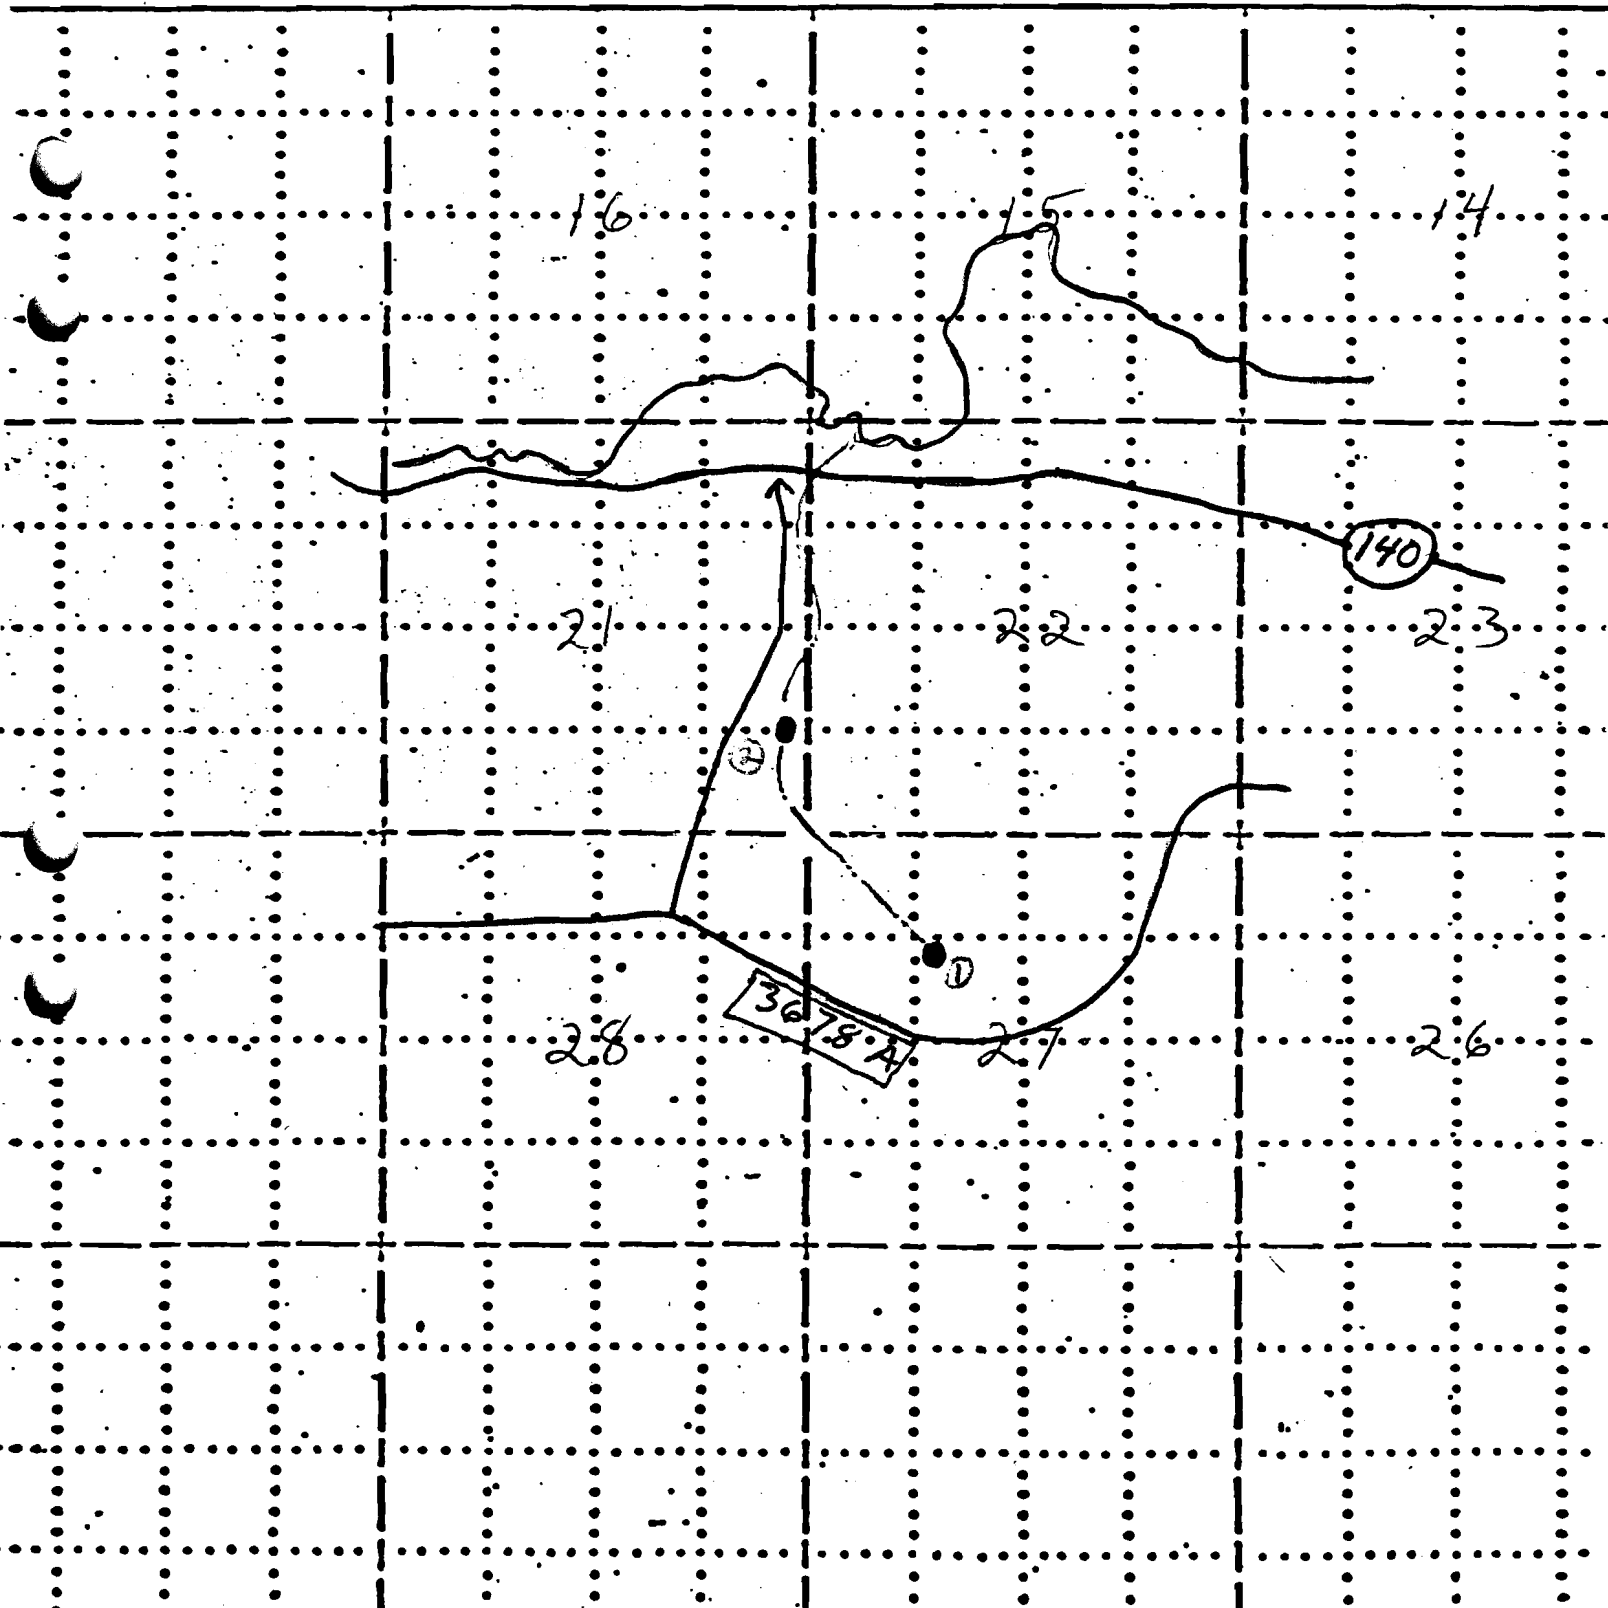

R-8931
36 13 21
59182

RECEIVED

AUG 19 1981
WATER RESOURCES DEPT
10 SALEM, OREGON

Application No. R-62480
Permit No. R-8931

