

RECEIVED

R8932
59183

FIELD MAP SHEET

AUG 19 1981


WATER RESOURCES DEPT

SALEM, OREGON

T. 36S
37S R. 17E Sec. _____ Subdiv. _____ PREMEX N.F.

Mapped by _____ Reviewed by _____ Scale 2 inches = 1 Mile

● RESERVOIR Application No. R-62481
— DRAINAGE Permit No. R 8932
— ROAD 7/21, 1981

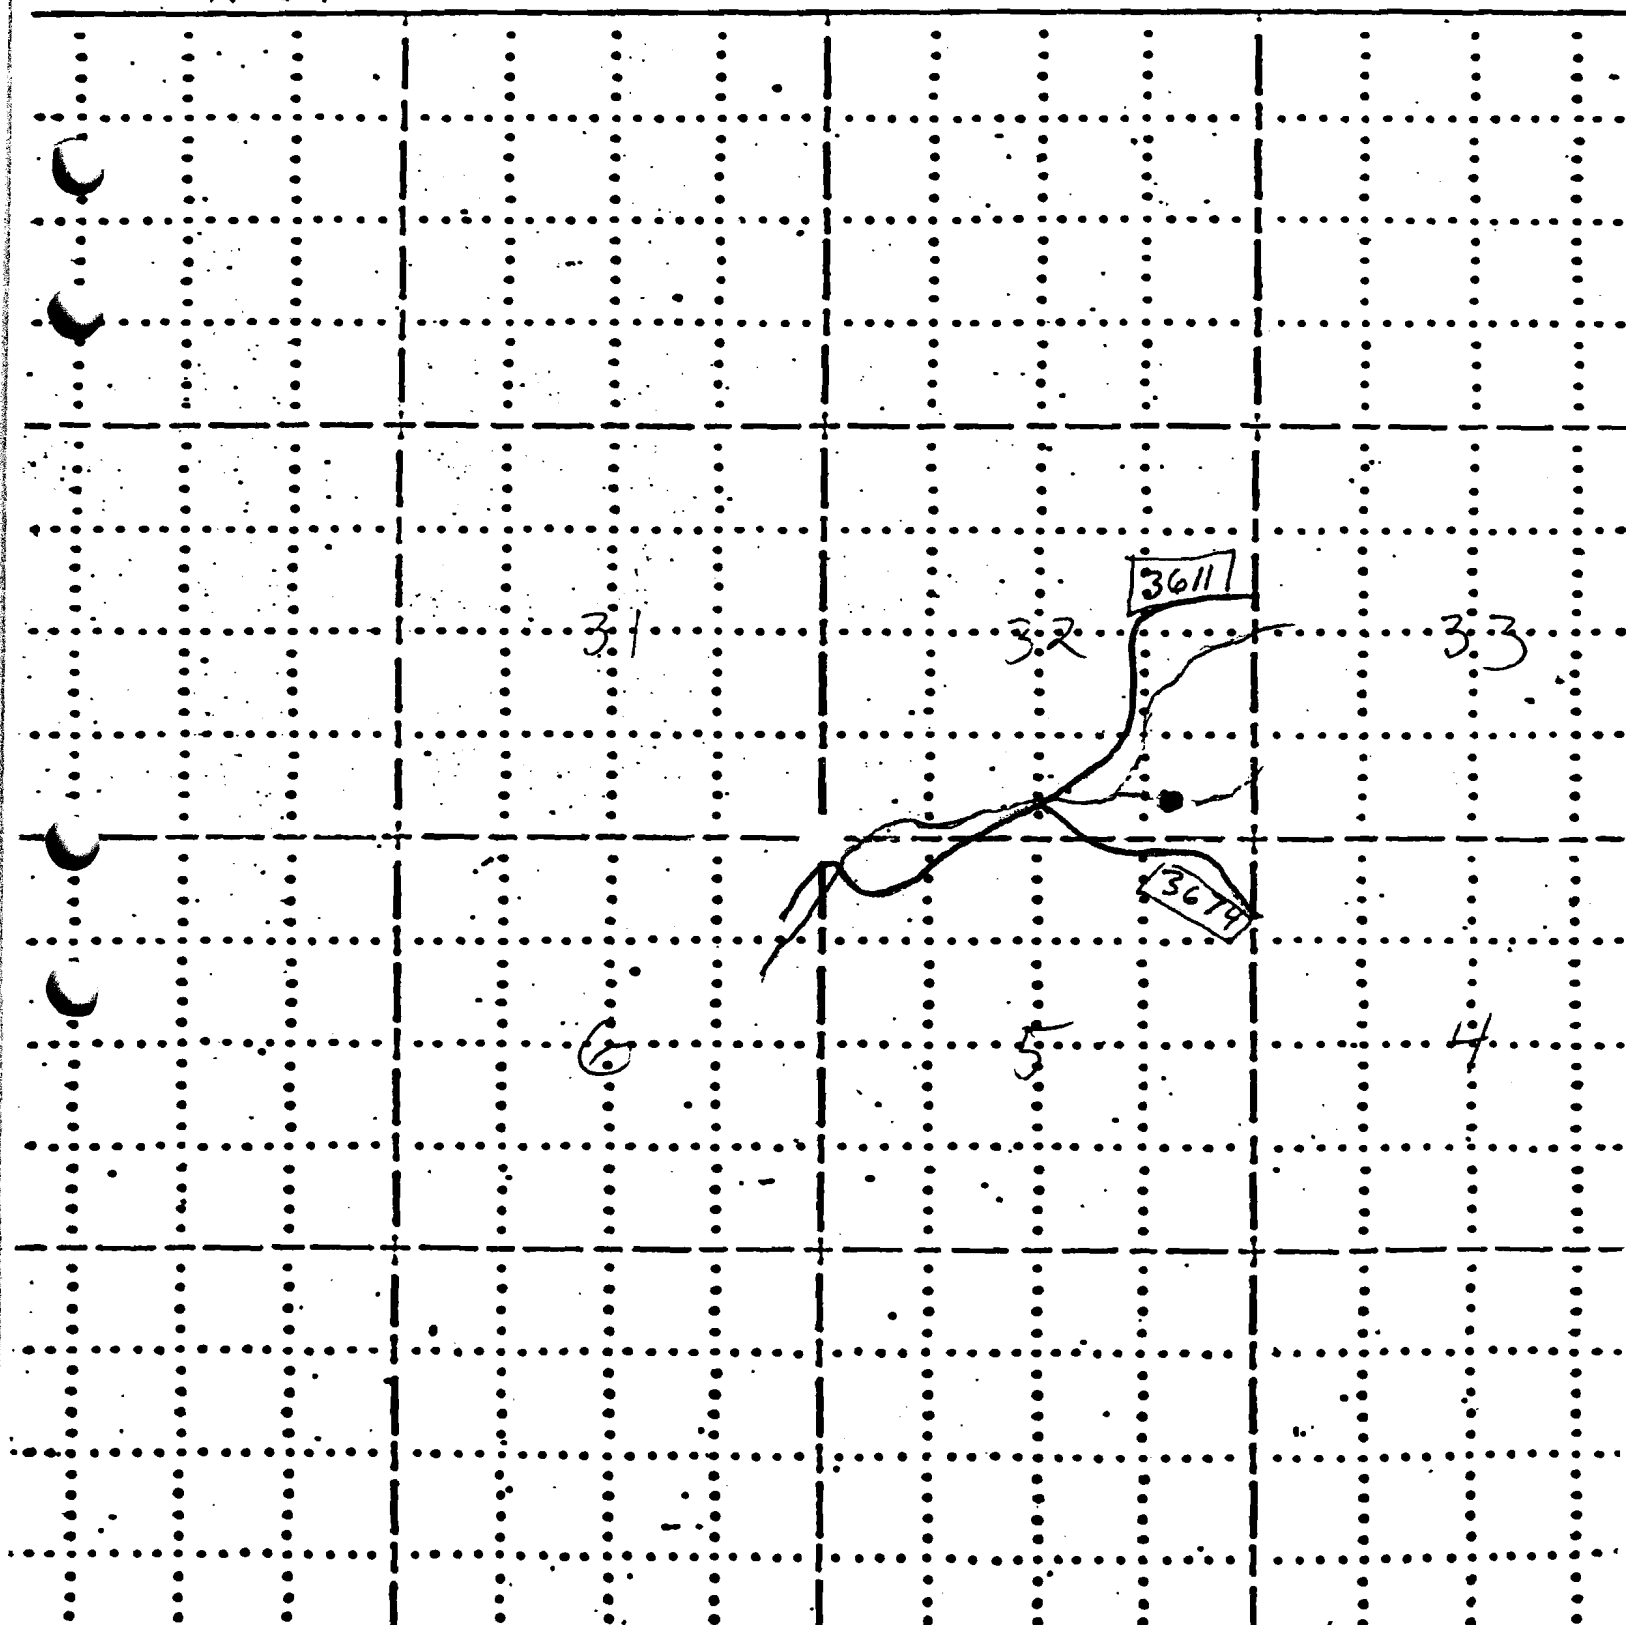

R-8932
36 17 32
59183

RECEIVED

AUG 19 1981

WATER RESOURCES DEPT
SALEM, OREGON

Application No. R-62481
Permit No. R 8932

