

RECEIVED <sup>R8933</sup> 59184

FIELD MAP SHEET


AUG 19 1981

WATER RESOURCES DEPT  
SALEM, OREGON  
FREMONT N.F.

T. <sup>365</sup> 373 R. 15E Sec. Subdiv.

Mapped by \_\_\_\_\_ Reviewed by \_\_\_\_\_ Scale 2 inches = 1 Mile

RESERVOIR Application No. R-62482 7/20 1981  
DRAINAGE Permit No. R 8933

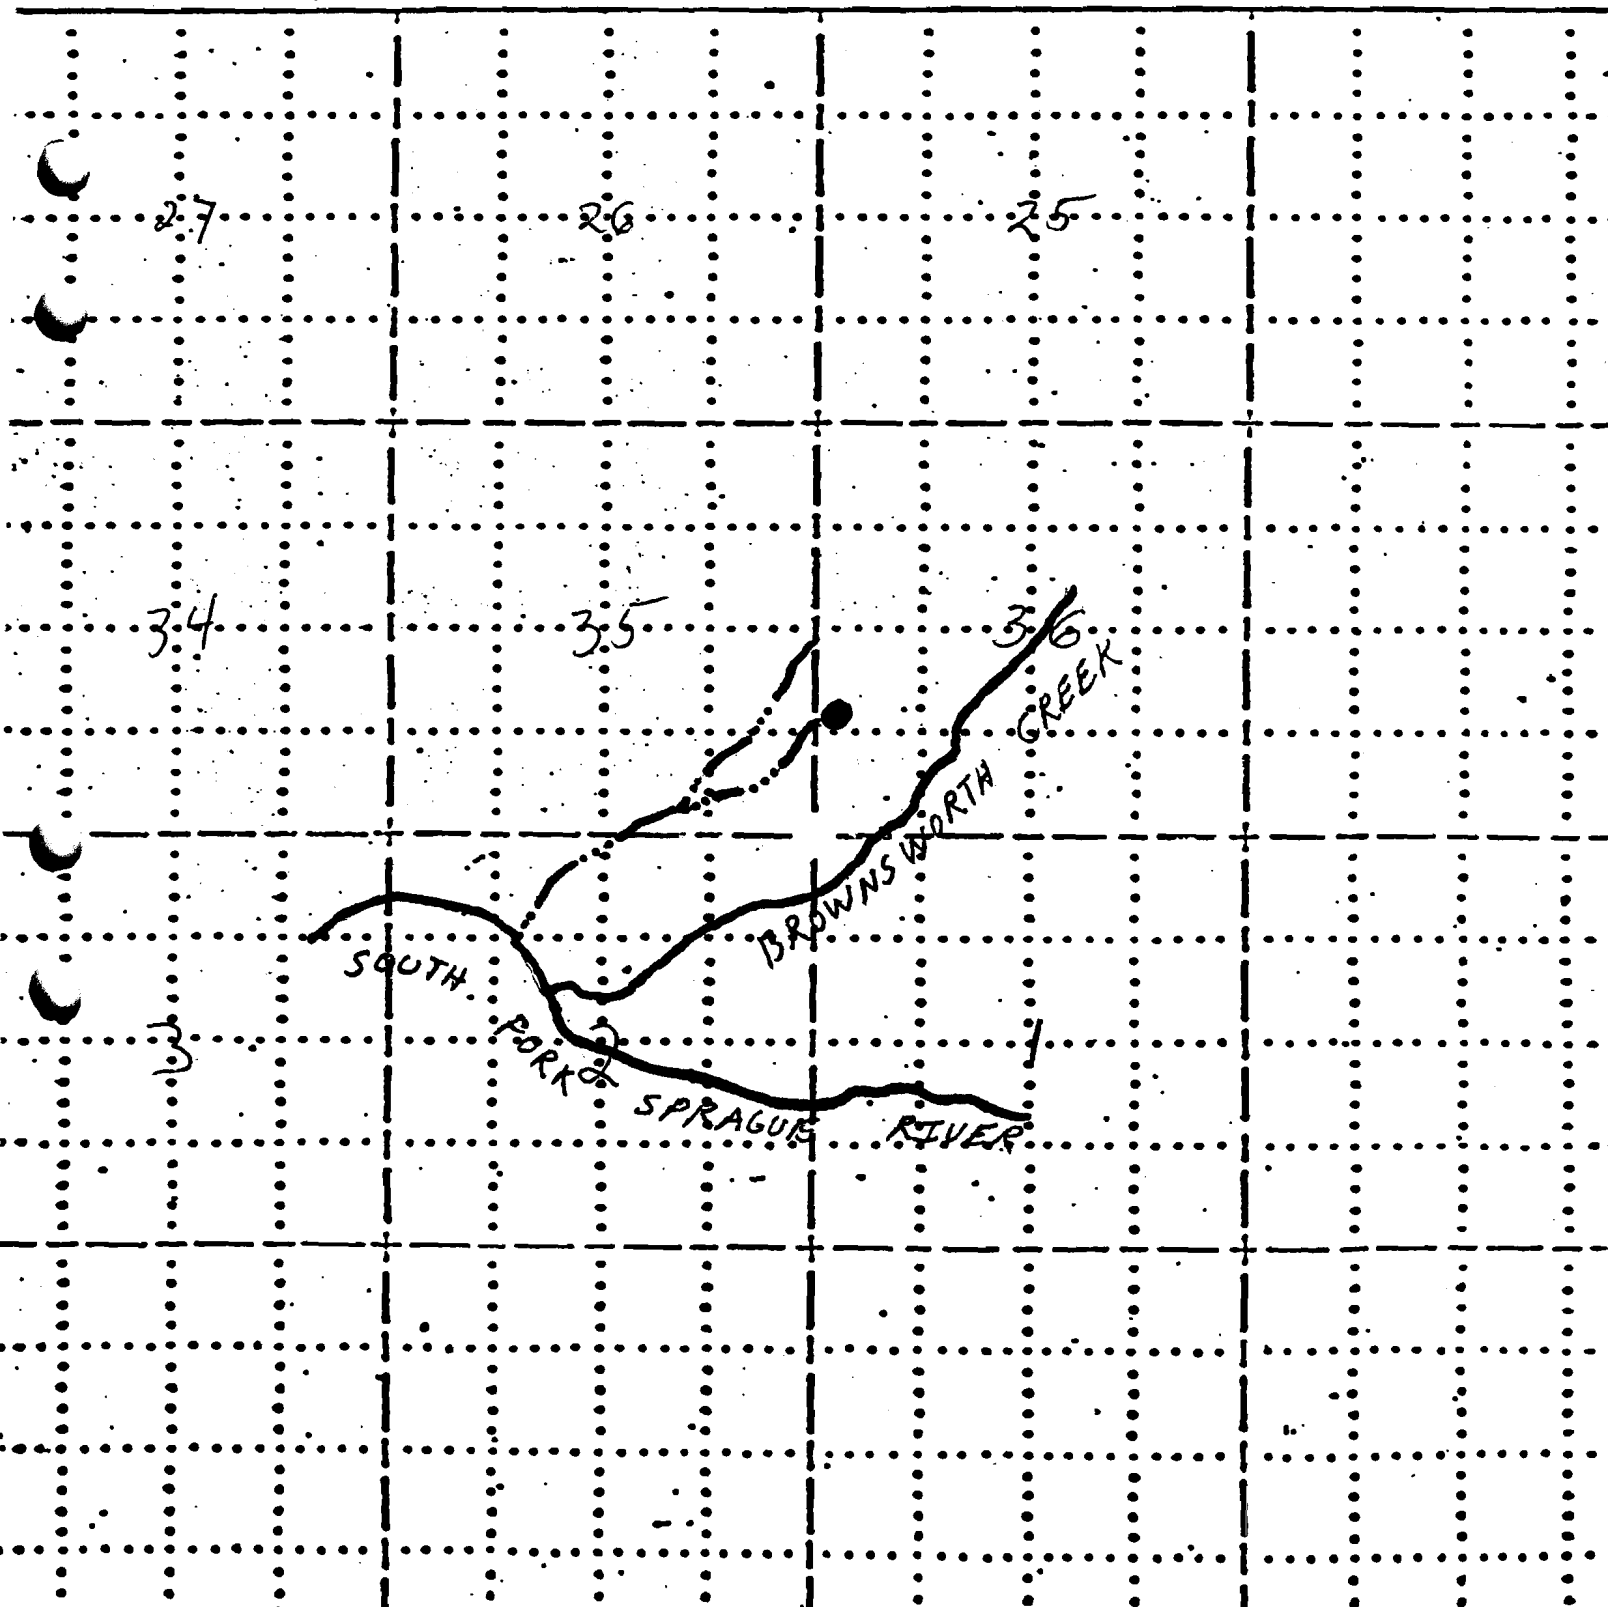

R 8933  
59184

36.15 36

**RECEIVED**

AUG 19 1981

WATER RESOURCES DEPT  
SALEM, OREGON

Application No. R62482

Permit No. R 8933

