


FIELD MAP SHEET

WATER RESOURCES DEPT
SALEM, OREGON

T. 36S R. 15E Sec. _____ Subdiv. _____ FREMONT N.F.

Mapped by _____ Reviewed by _____ Scale 2 inches = 1 Mile

● RESERVOIR Application No. R-62484 7/20 _____, 1981
— DRAINAGE Permit No. R 8935
— ROAD

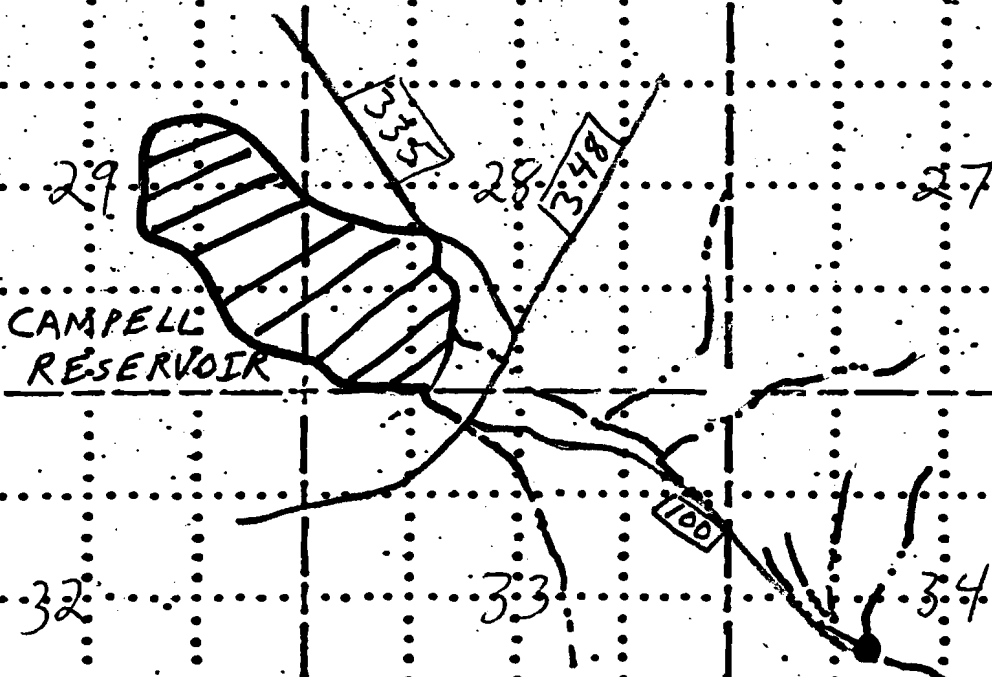

R-8935

59.186

36 15 34, 35

24
RECEIVED

AUG 19 1981

WATER RESOURCES DEPT
SALEM, OREGON

Application No. R-62484

Permit No. R 8935

Dutchman
Flat

Swede
Cabin
Flat

SWEDE
CABIN

5345 X
Round
Butte

South Fork
Sprague River

Butte
Spring

