

AUG 19 1981

FIELD MAP SHEET WATER RESOURCES DEPT
SALEM, OREGON


T. 36S R. 13E Sec. _____ Subdiv. _____ FREMONT N.F.

Mapped by T. OLENICHAK Reviewed by _____ Scale 2 inches = 1 Mile

● RESERVOIR Application No. R-62485 7/8 1981

— DRAINAGE Permit No. R 8936

— ROAD

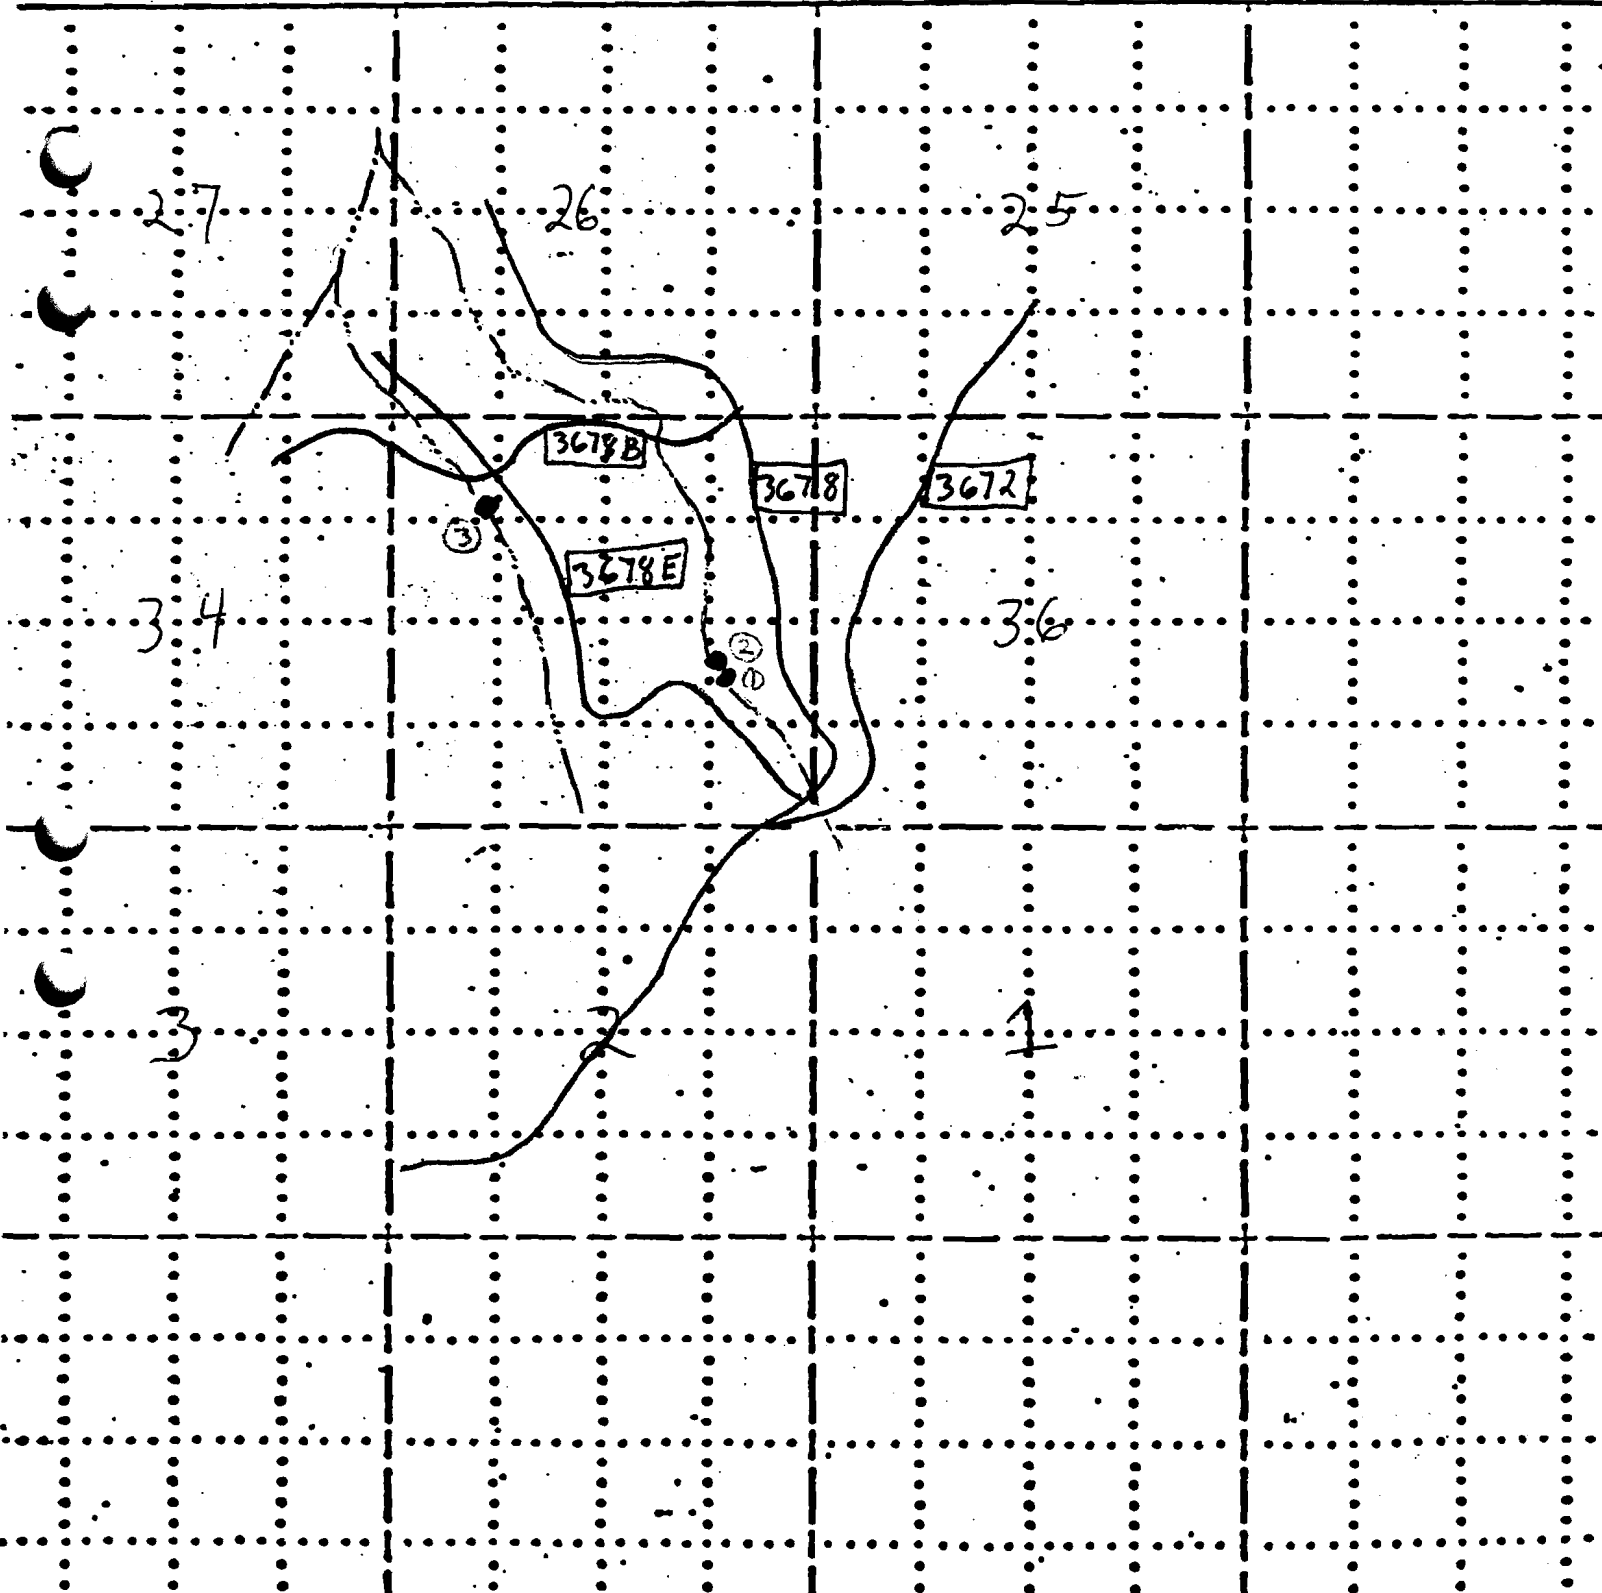

8936
59187
36 13 35

RECEIVED.

AUG 19 1981

WATER RESOURCES DEPT
SALM, OREGON

Application No. R-62485

Permit No. R 8936

