

AUG 19 1981


FIELD MAP SHEET

WATER RESOURCES DEPT
SALEM, OREGON

T. 37S R. 11E/12E Sec. _____ Subdiv. _____ FREEMONT N.F.

Mapped by T. OLESEN Reviewed by _____ Scale 2 inches = 1 Mile

● RESERVOIR Application No. R-62486 7/8, 1981
— DRAINAGE Permit No. R 8937
— ROAD

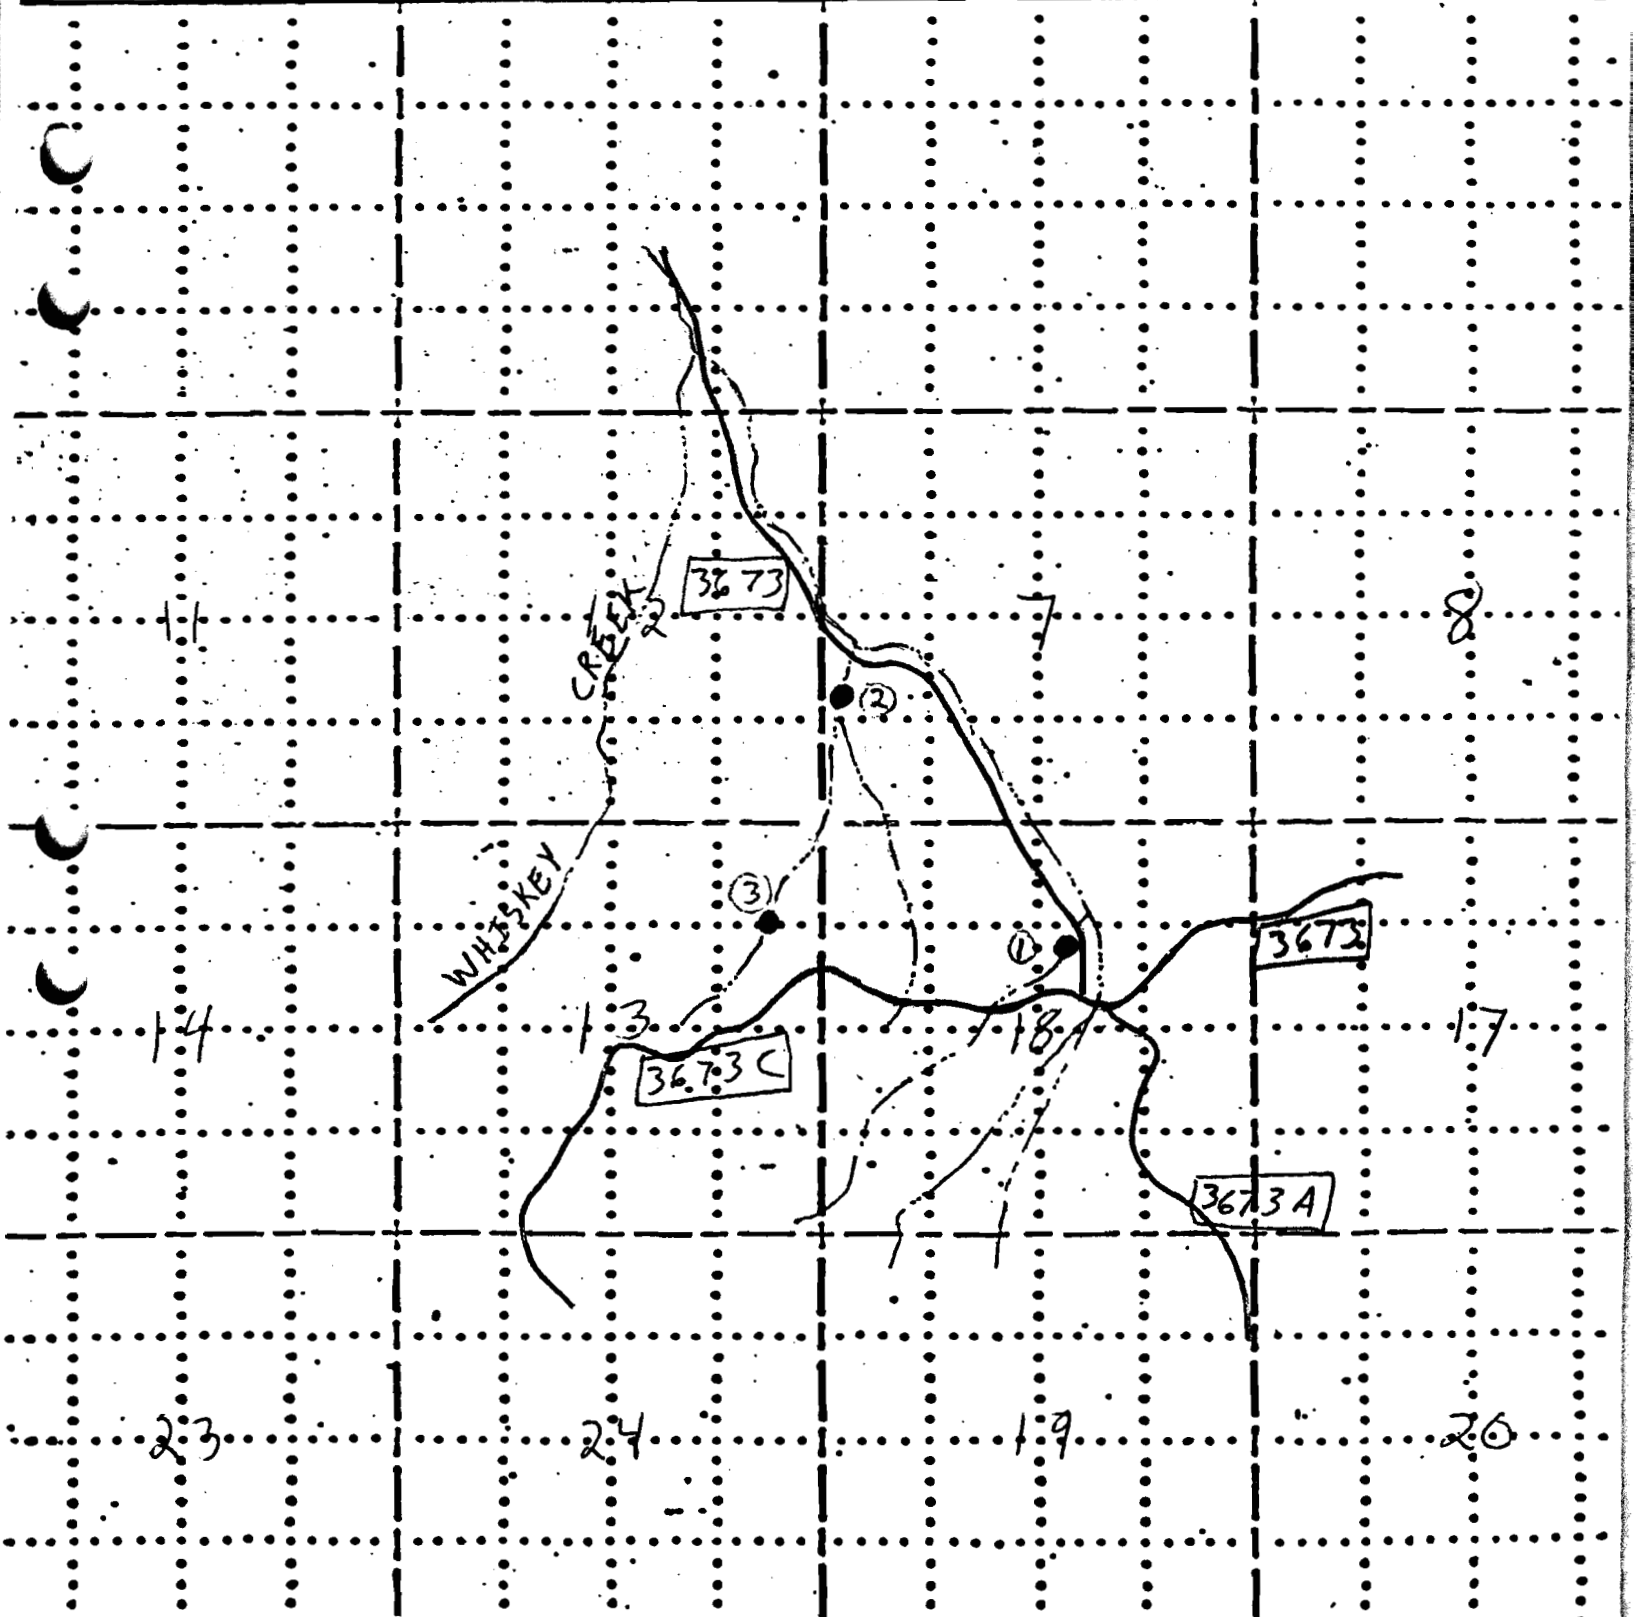

R-8937
59188
37 12 78
37 11 13

RECEIVED

AUG 19 1981
WATER RESOURCES DEPT
SALEM, OREGON

Application No. R-62486
Permit No. R 8937

