

AUG 19 1981

FIELD MAP SHEET WATER RESOURCES DEPT
SALEM, OREGON


T. 37S R. 13E/14E Sec. Subdiv. FREMONT N.F.

Mapped by T. OLENICHIK Reviewed by Scale 2 inches = 1 Mile

Application No. R-62488

Permit No. R 8939

7/7 19 81

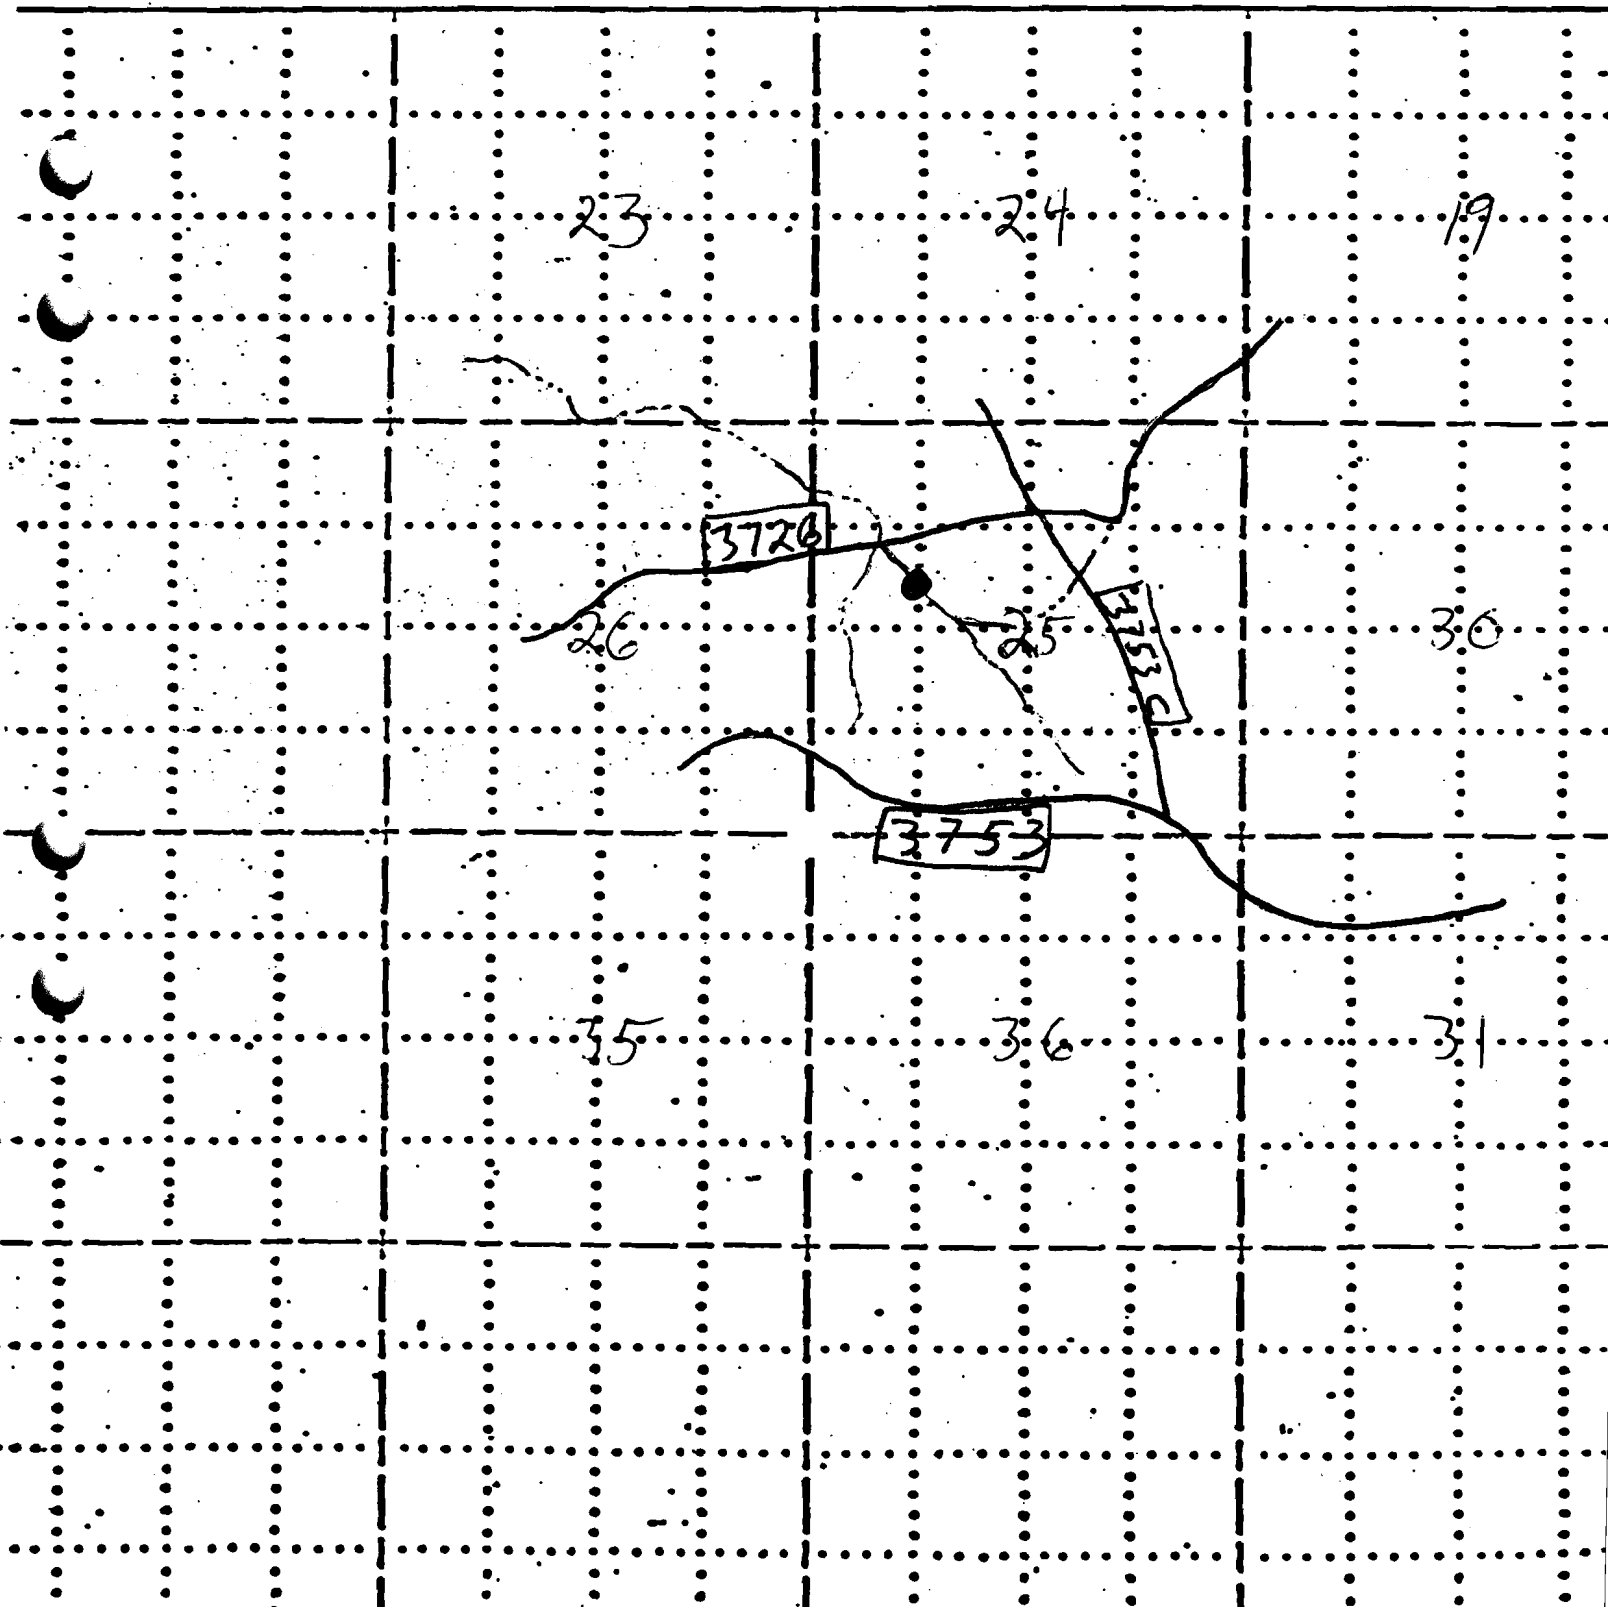

R-8939
59190

37 13 25

RECEIVED

AUG 19 1981

WATER RESOURCES DEPT
SALEM, OREGON

Application No. R62488
Permit No. R 8939

