

RECEIVED

R. 8946
59191

AUG 19 1981

FIELD MAP SHEET

WATER RESOURCES DEPT

SALEM, OREGON


FREMONT

N.F.

T. 37S R. 13E/14E Sec. Subdiv.

Mapped by Reviewed by Scale 2 inches = 1 Mile

● RESERVOIR Application No. R-62489 7/20, 1981
— DRAINAGE Permit No. R 8940
— ROAD

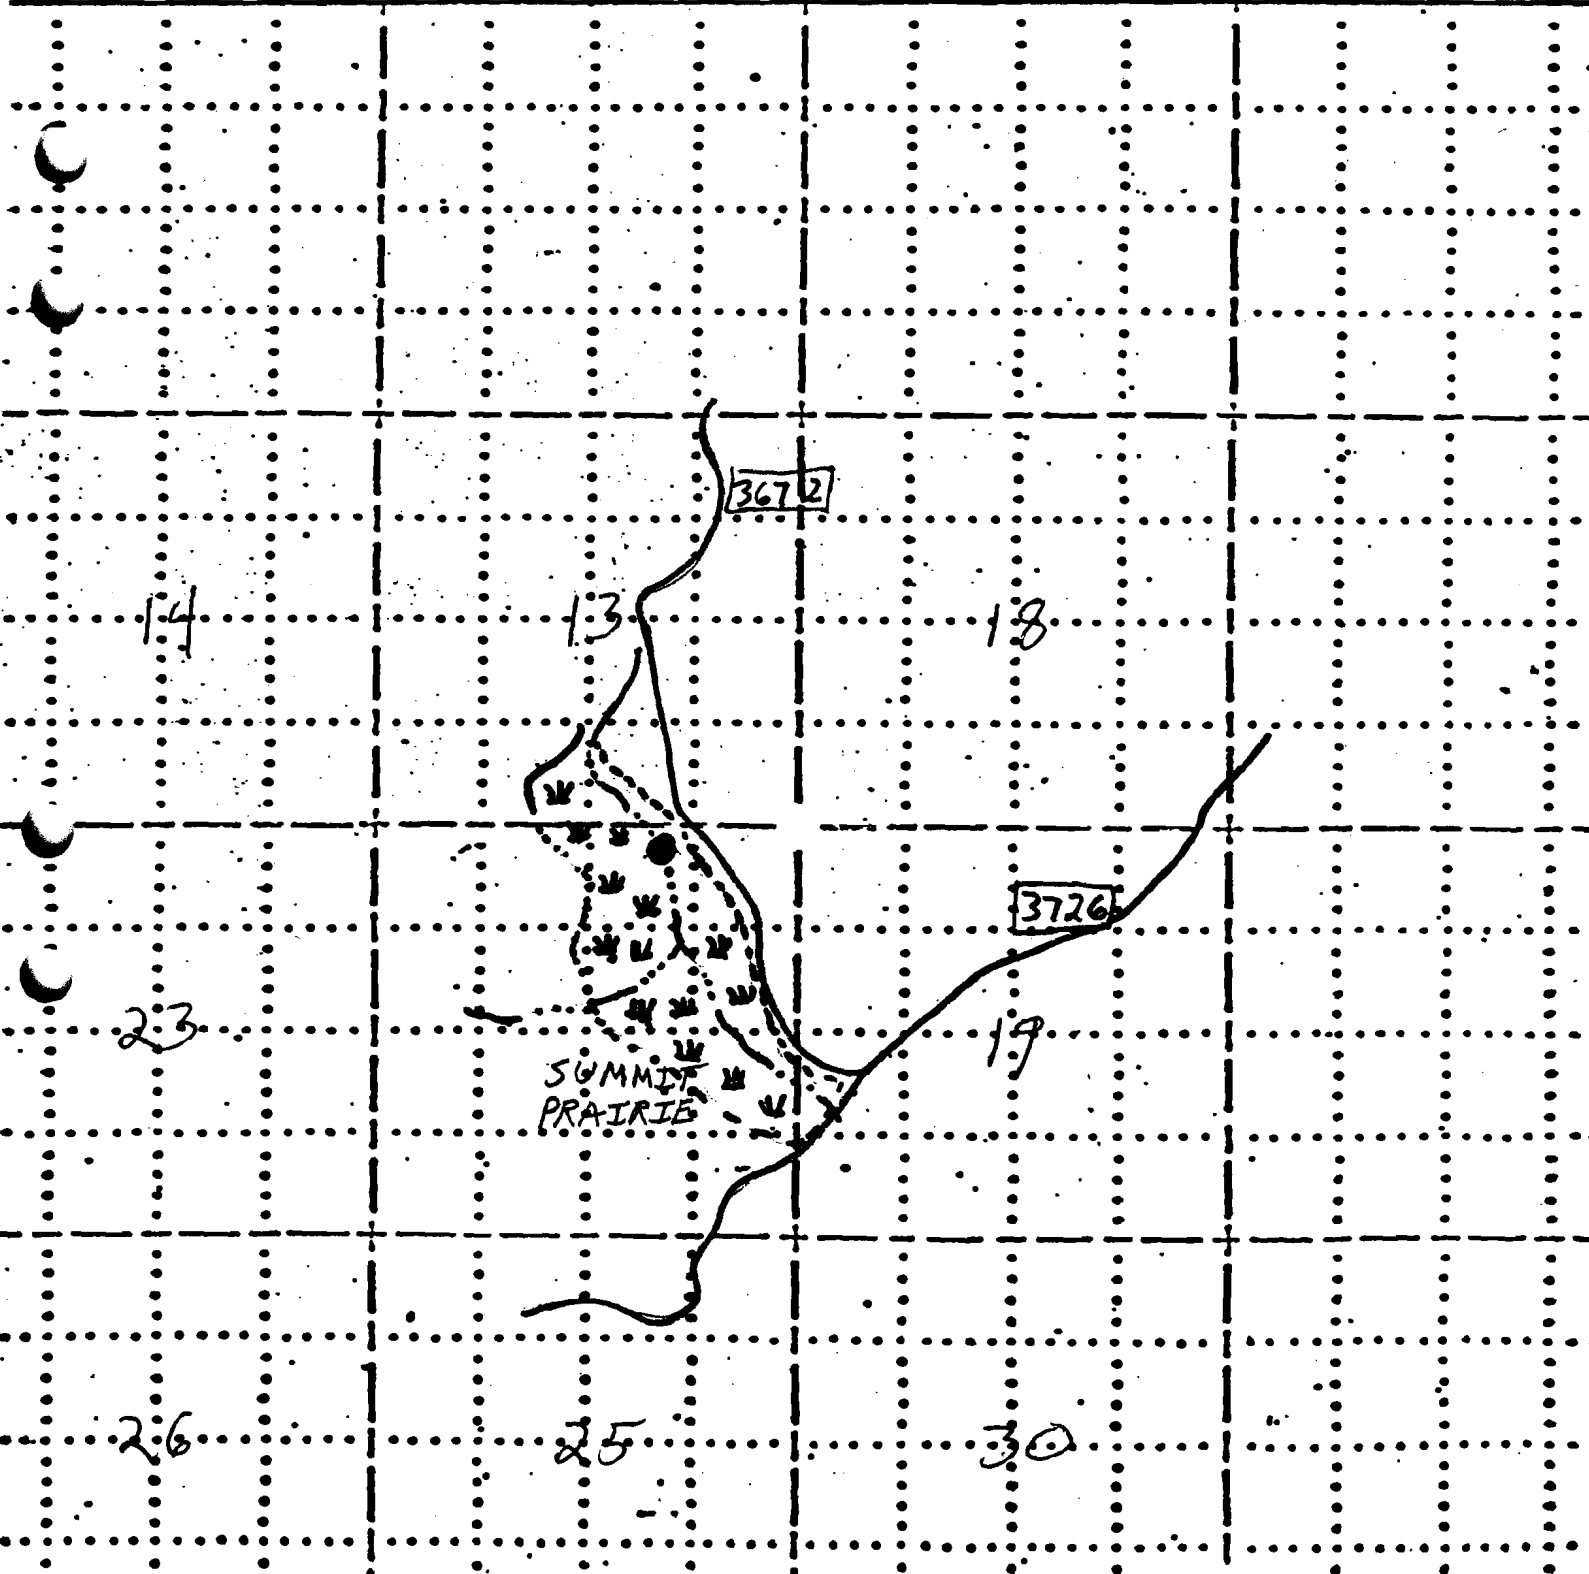


R 58940
59191

RECEIVED

AUG 19 1981

WATER RESOURCES DEPT
SALEM, OREGON
37 13 24

Application No. R-62489
Permit No. R 8940

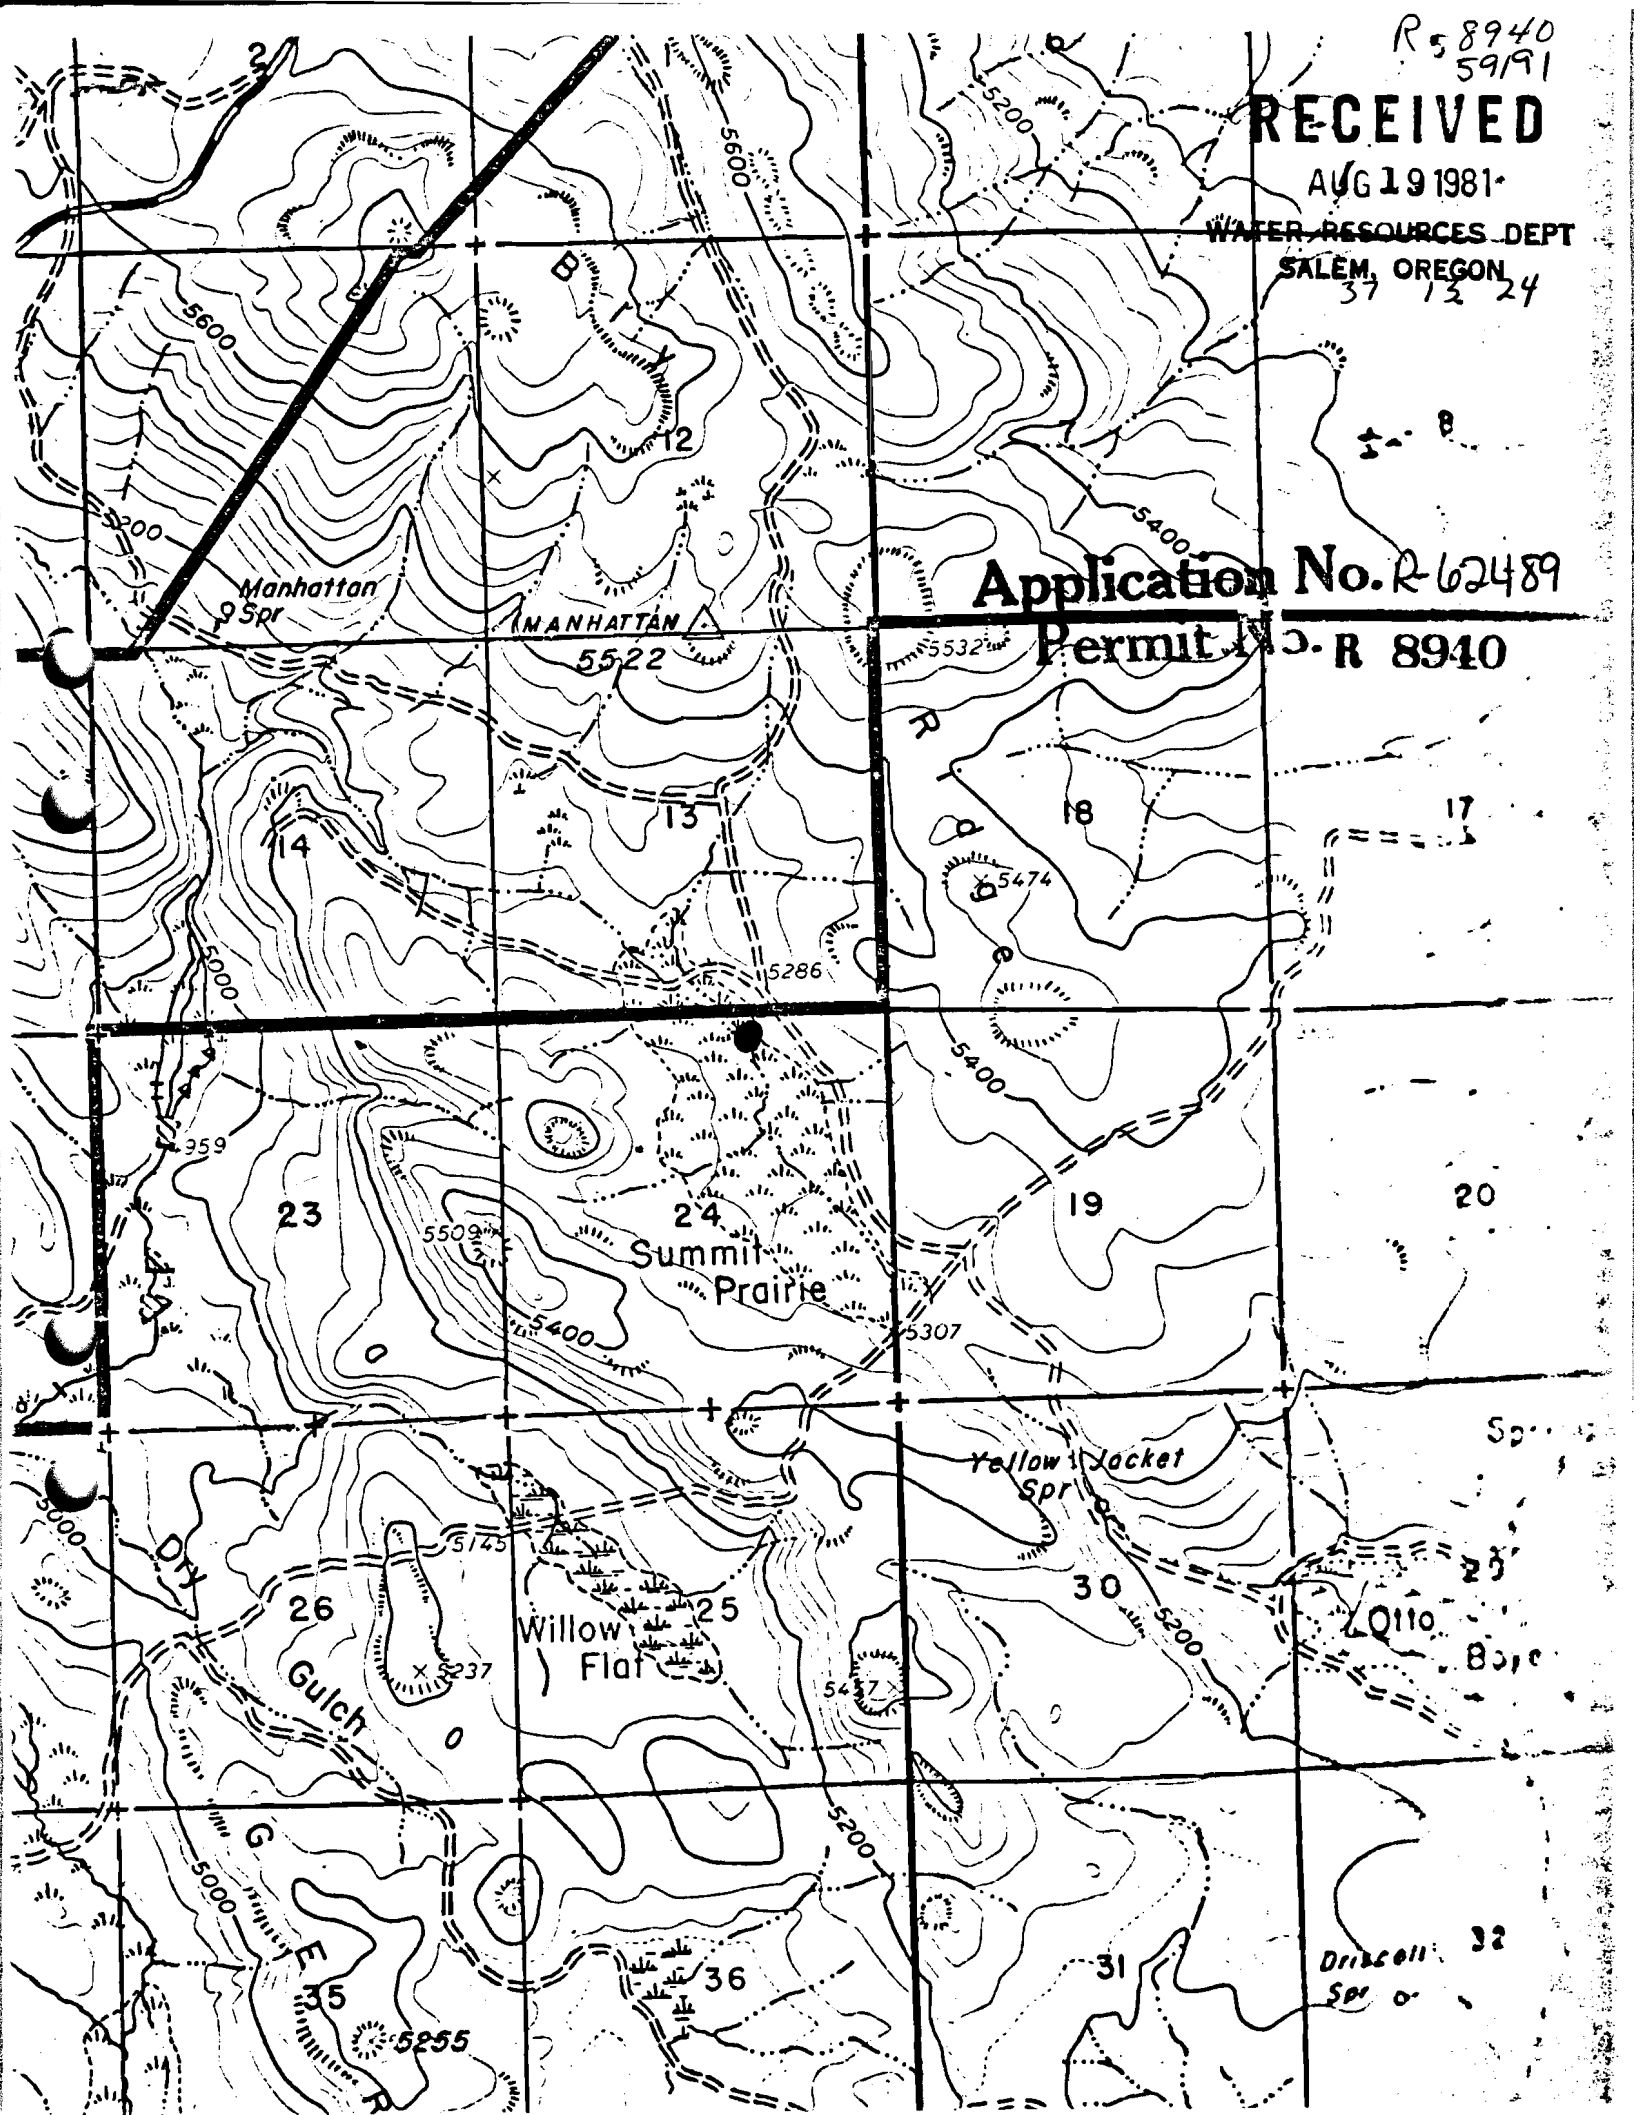

Driscoll 32
Spr 0