

FIELD MAP SHEET

WATER RESOURCES DEPT
SALEM, OREGON


T. 37S R. 15E Sec. _____ Subdiv. _____ FREMONT N.F.

Mapped by _____ Reviewed by _____ Scale 2 inches = 1 Mile

- RESERVOIR
- DRAINAGE
- ROAD

Application No. R-62492 7/21, 1981

Permit No. R 8943

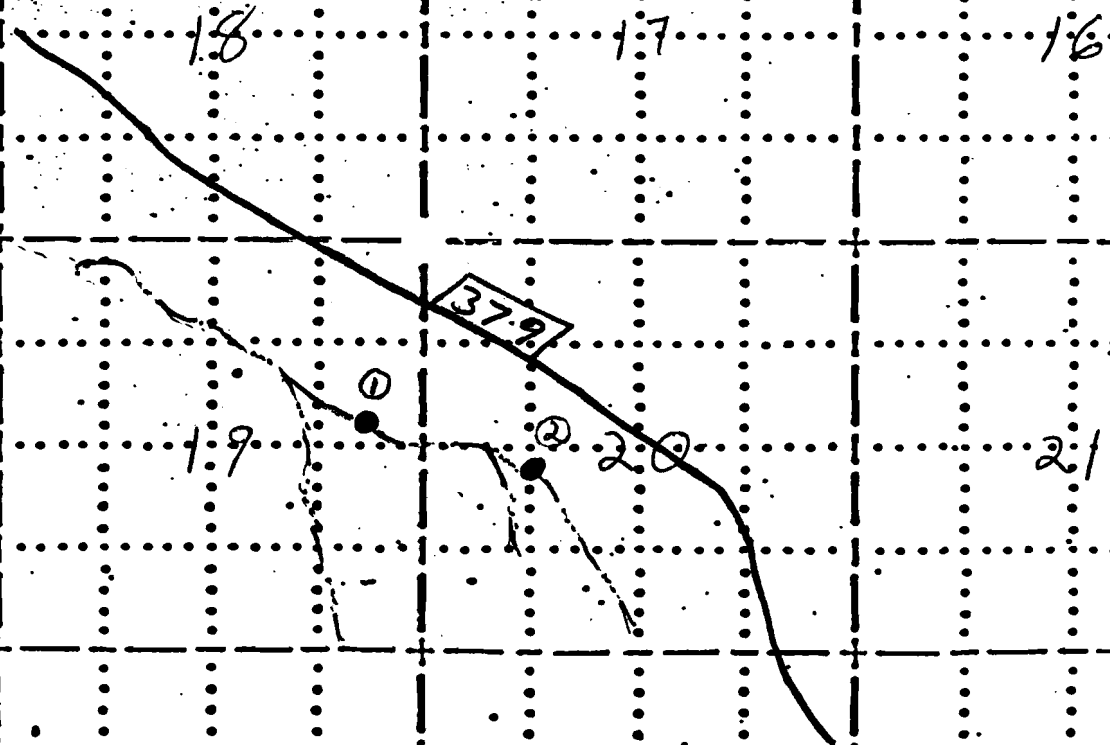

R-8943
59194

91

(Bly)
350,000

7-C RANCH

SPRAGUE RIVER

CASEBEER RANCH

Paradise Creek

BM
4699

Application No. R-62192
Permit No. R 8943

T.37 S.


20'

350,000

RECEIVED

AU 19 1981

WATER RESOURCES DEPT.
SALEM, OREGON

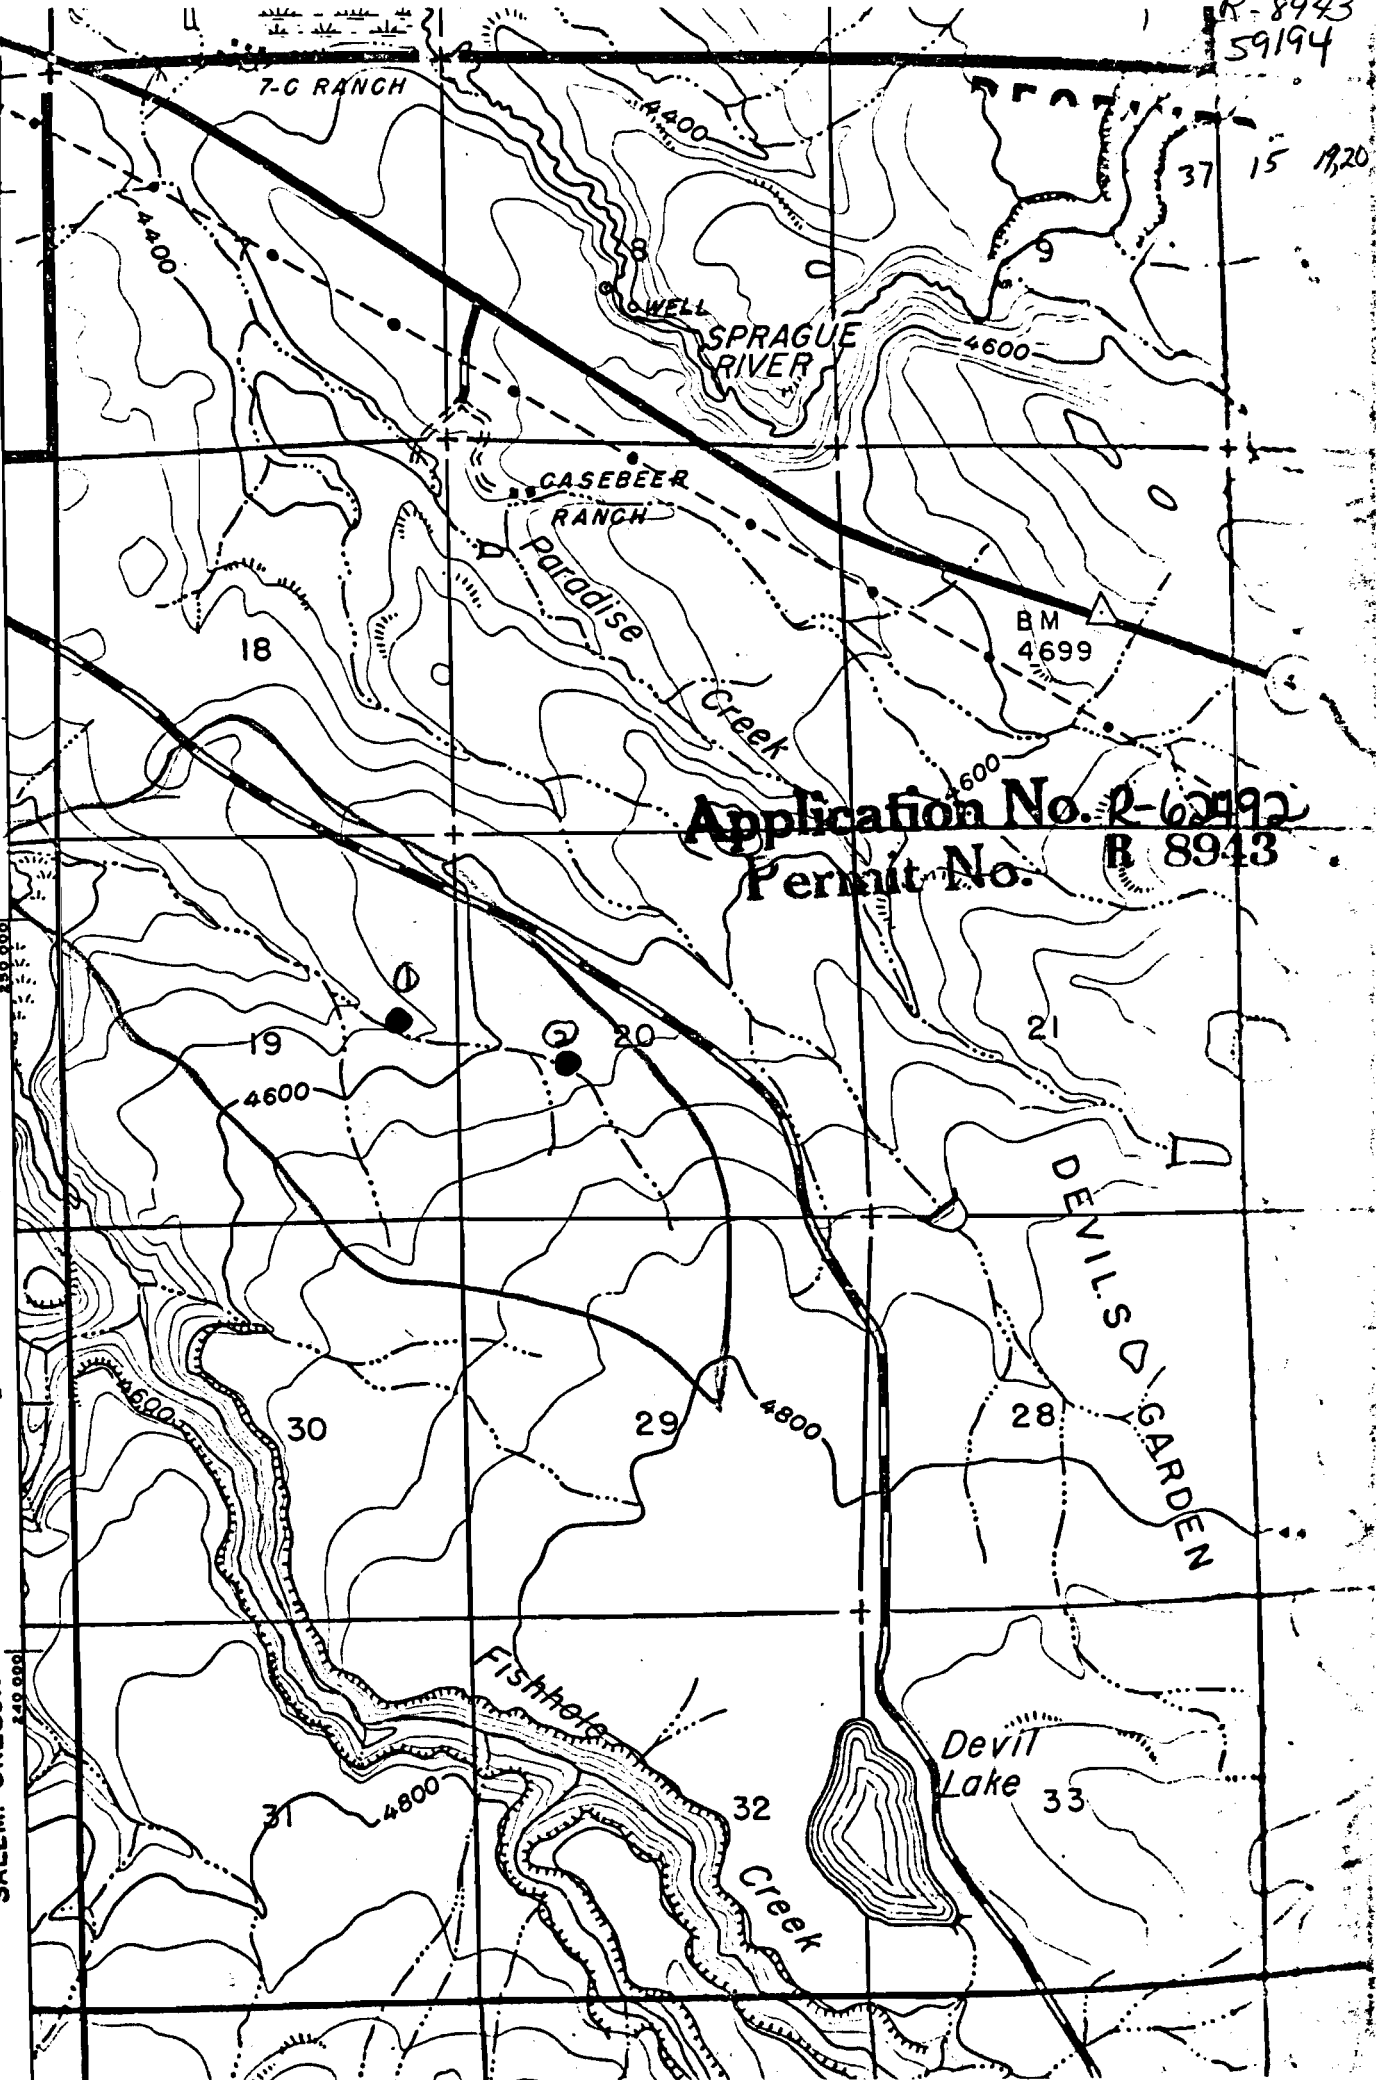

Fishhole Creek

Devil Lake

DEVIL'S GARDEN