

RECEIVED

R9090  
59195

FIELD MAP SHEET

AUG-19 1981

WATER RESOURCES DEPT

SALEM, OREGON


FREMONT

N.F.

T. 37S  
38S R. 16E Sec. .... Subdiv. ....

Mapped by T. OLENICHAK Reviewed by ..... Scale 2 inches = 1 Mile

● RESERVOIR Application No. R-62494 7/8, 1981  
 — DRAINAGE Permit No. R 9099  
 — ROAD

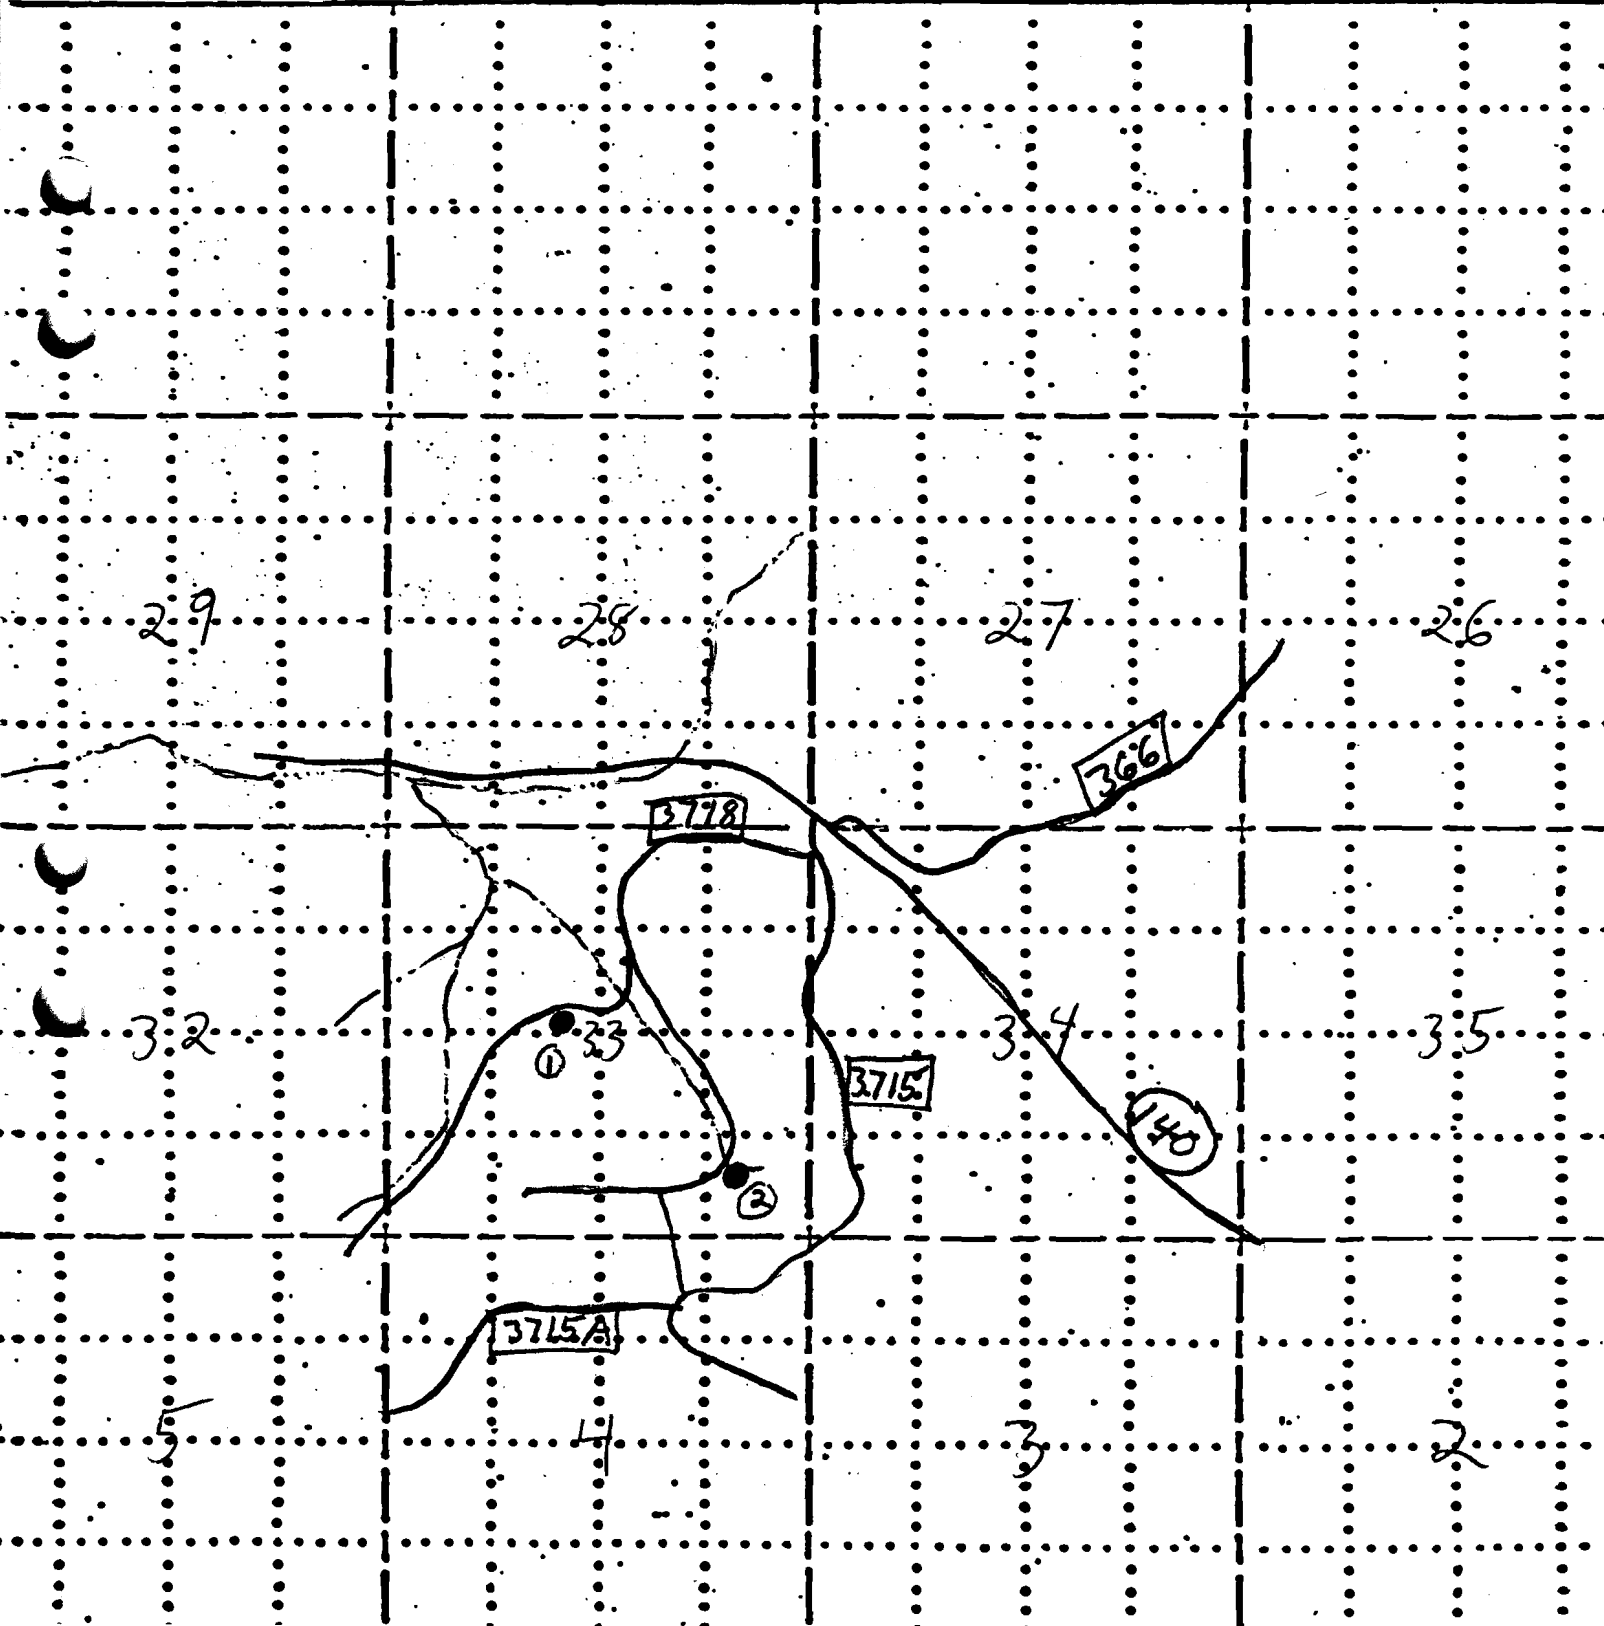


R-9099  
37 16 33

**RECEIVED**

AUG 19 1981

WATER RESOURCES DEPT  
SALEM, OREGON

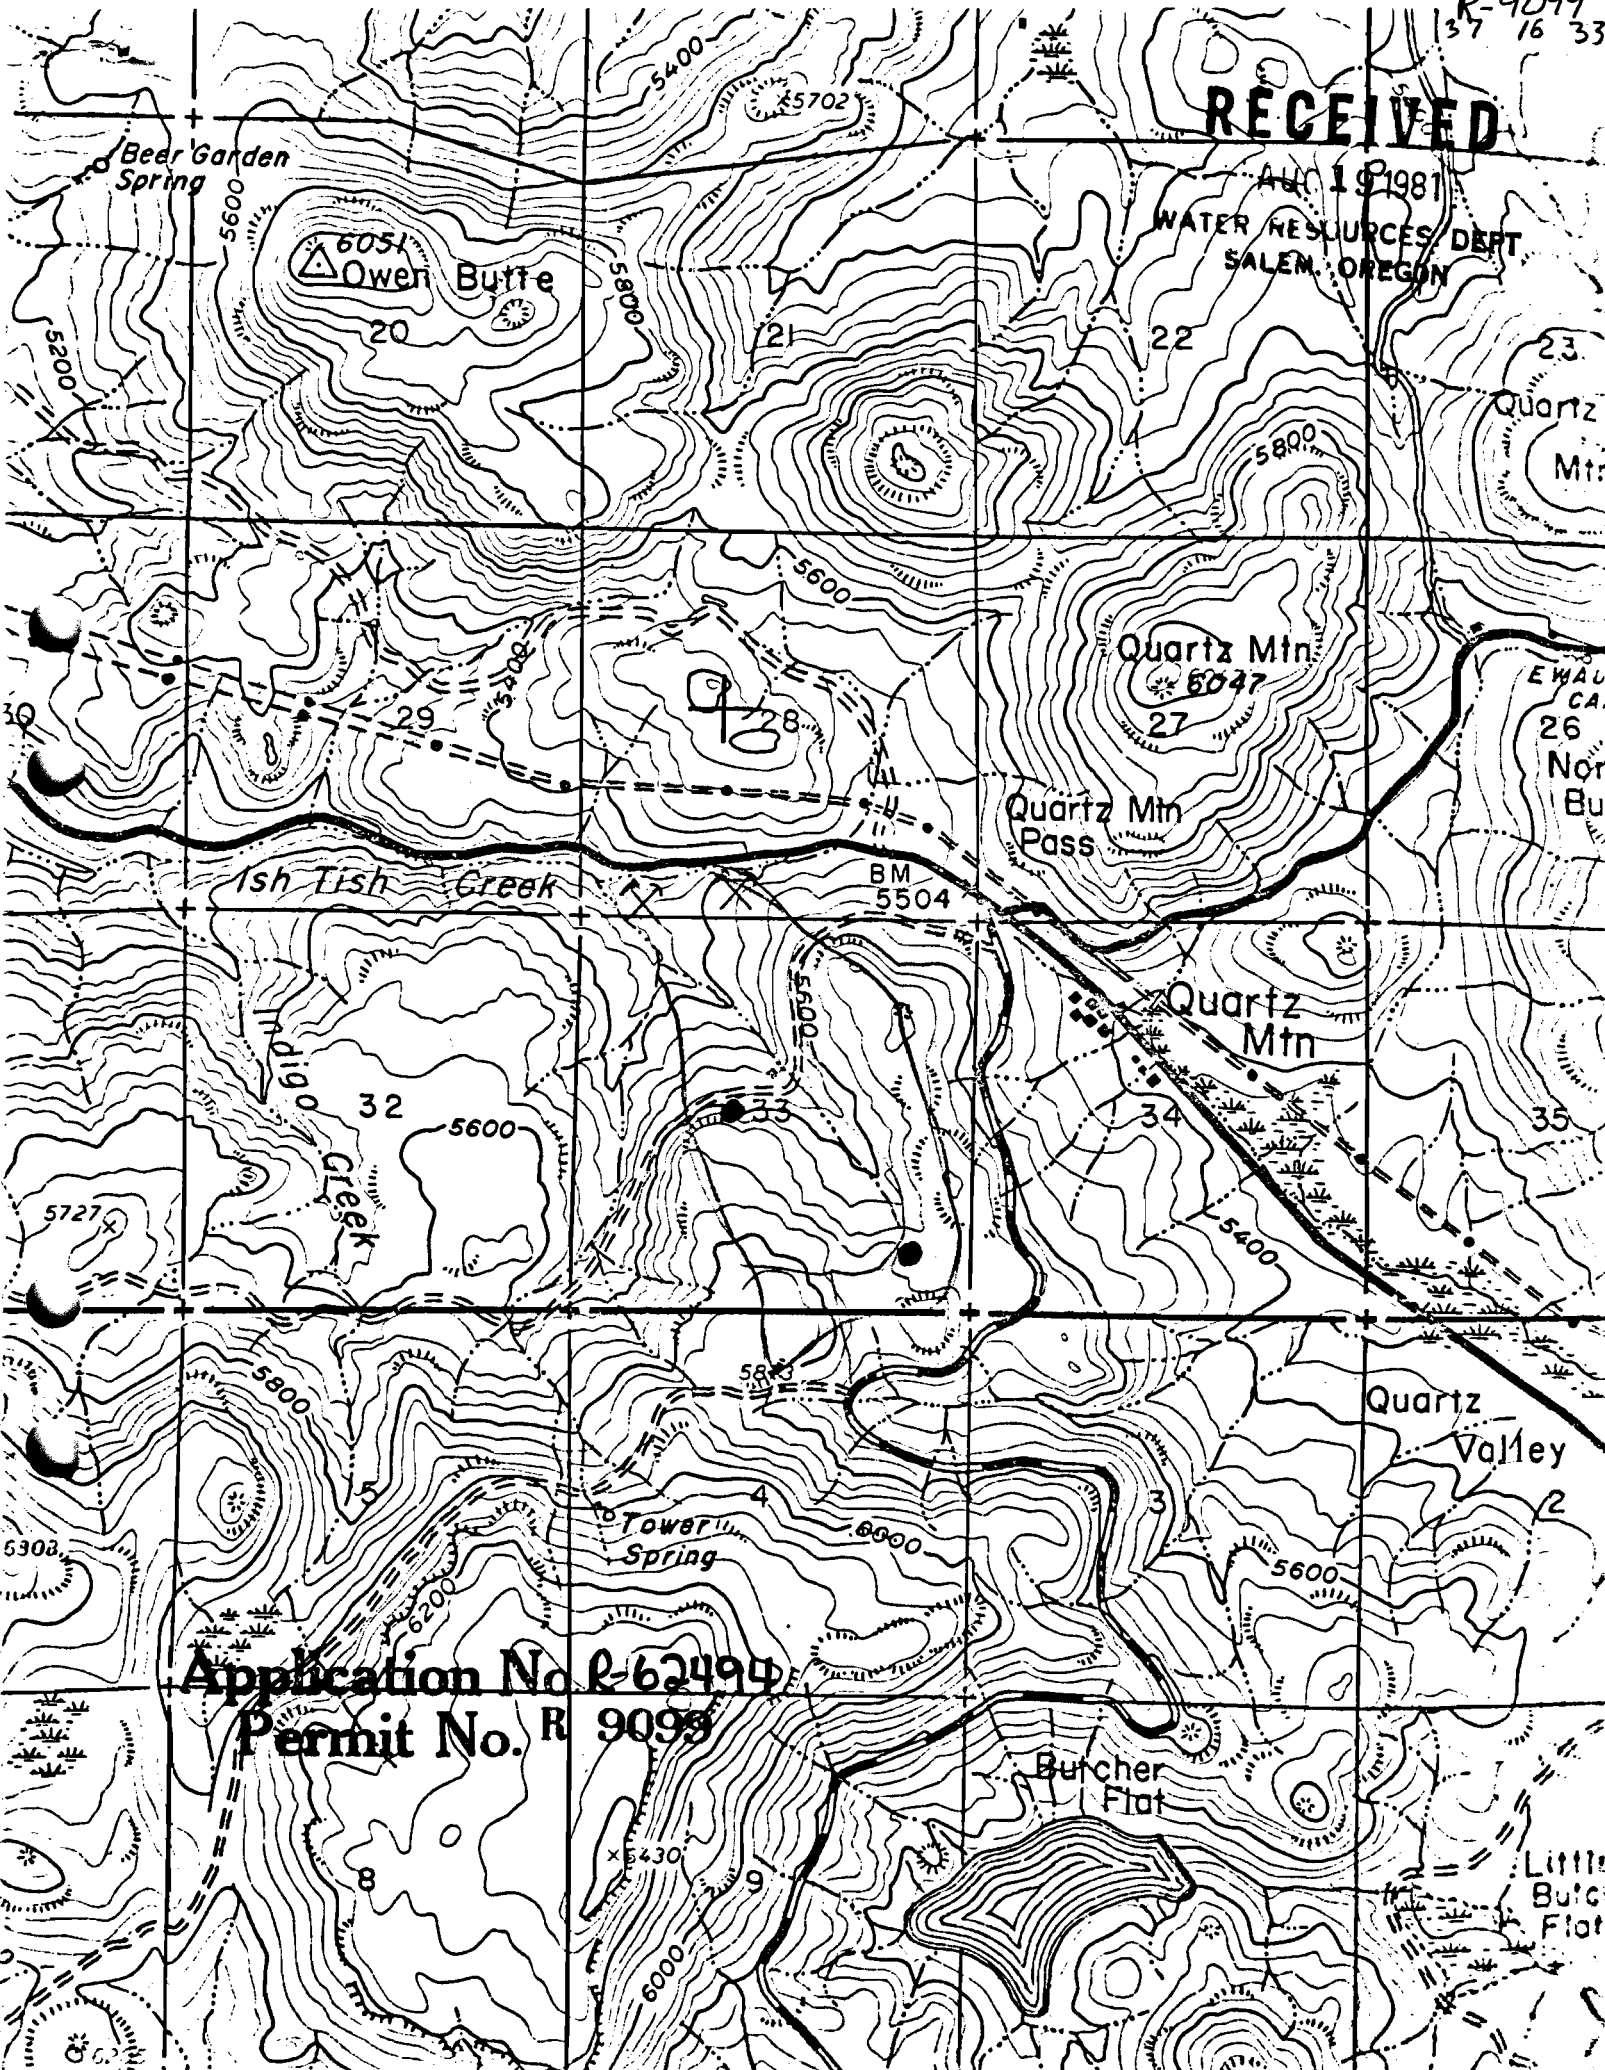

**Application No. R-62494**  
**Permit No. R-9099**

23  
Quartz Mtn

26  
Nor Bu

35

2  
Quartz Valley

Little Bulc Flat