

RECEIVED

R. 9100
59196

AUG 19 1981

FIELD MAP SHEET

WATER RESOURCES DEPT

SALEM, OREGON

PREMONT

N.F.

T. 38S R. 13E Sec. Subdiv.


Mapped by _____ Reviewed by _____ Scale 2 inches = 1 Mile


RESERVOIR Application No. R-62495 7/20, 1981

DRAINAGE

Permit No. R 9100

ROAD

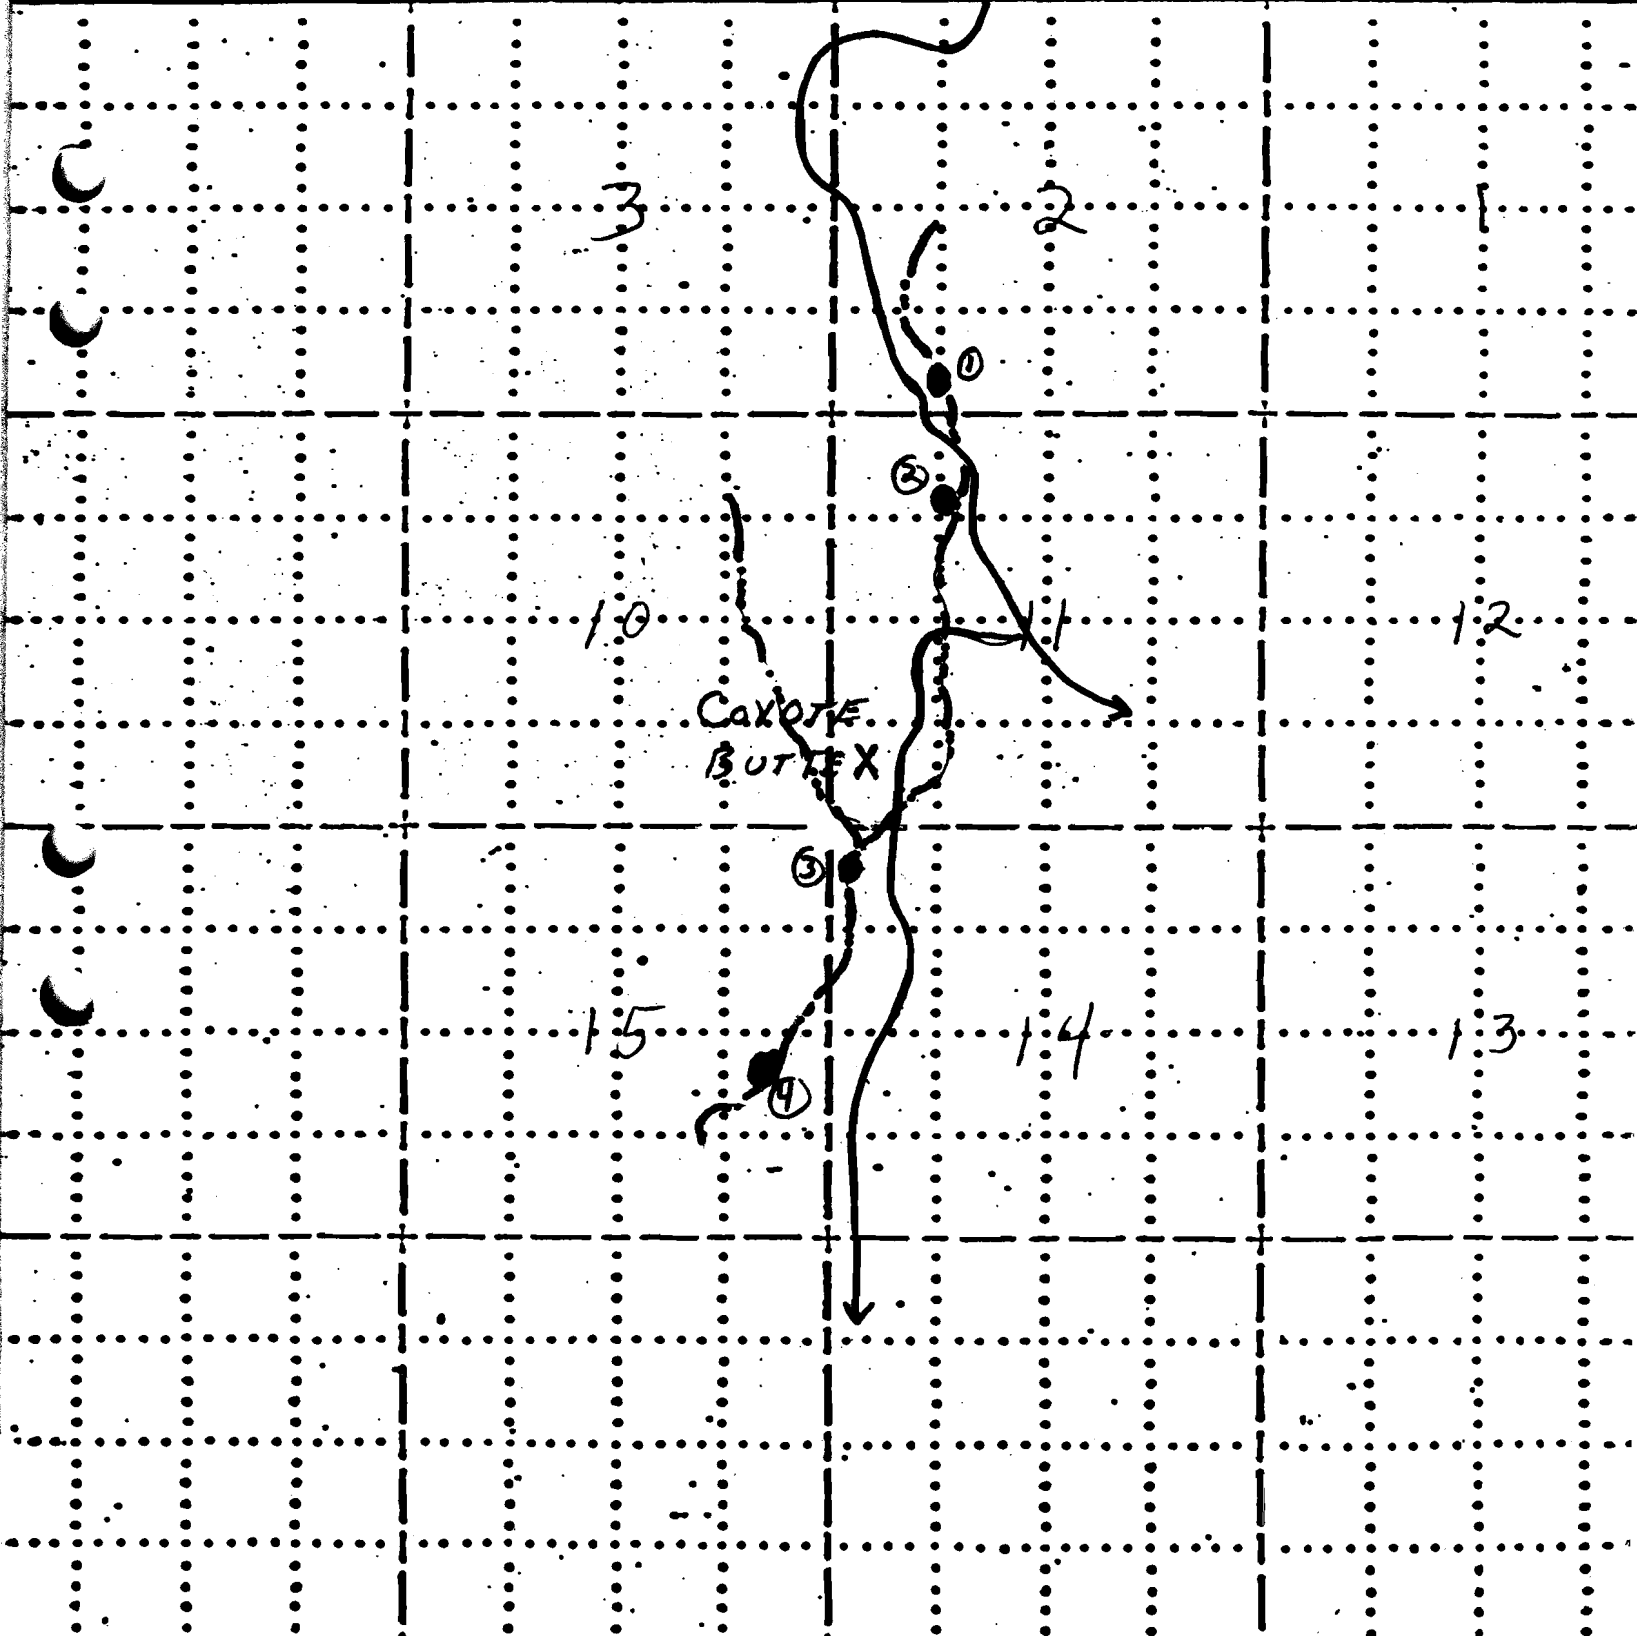

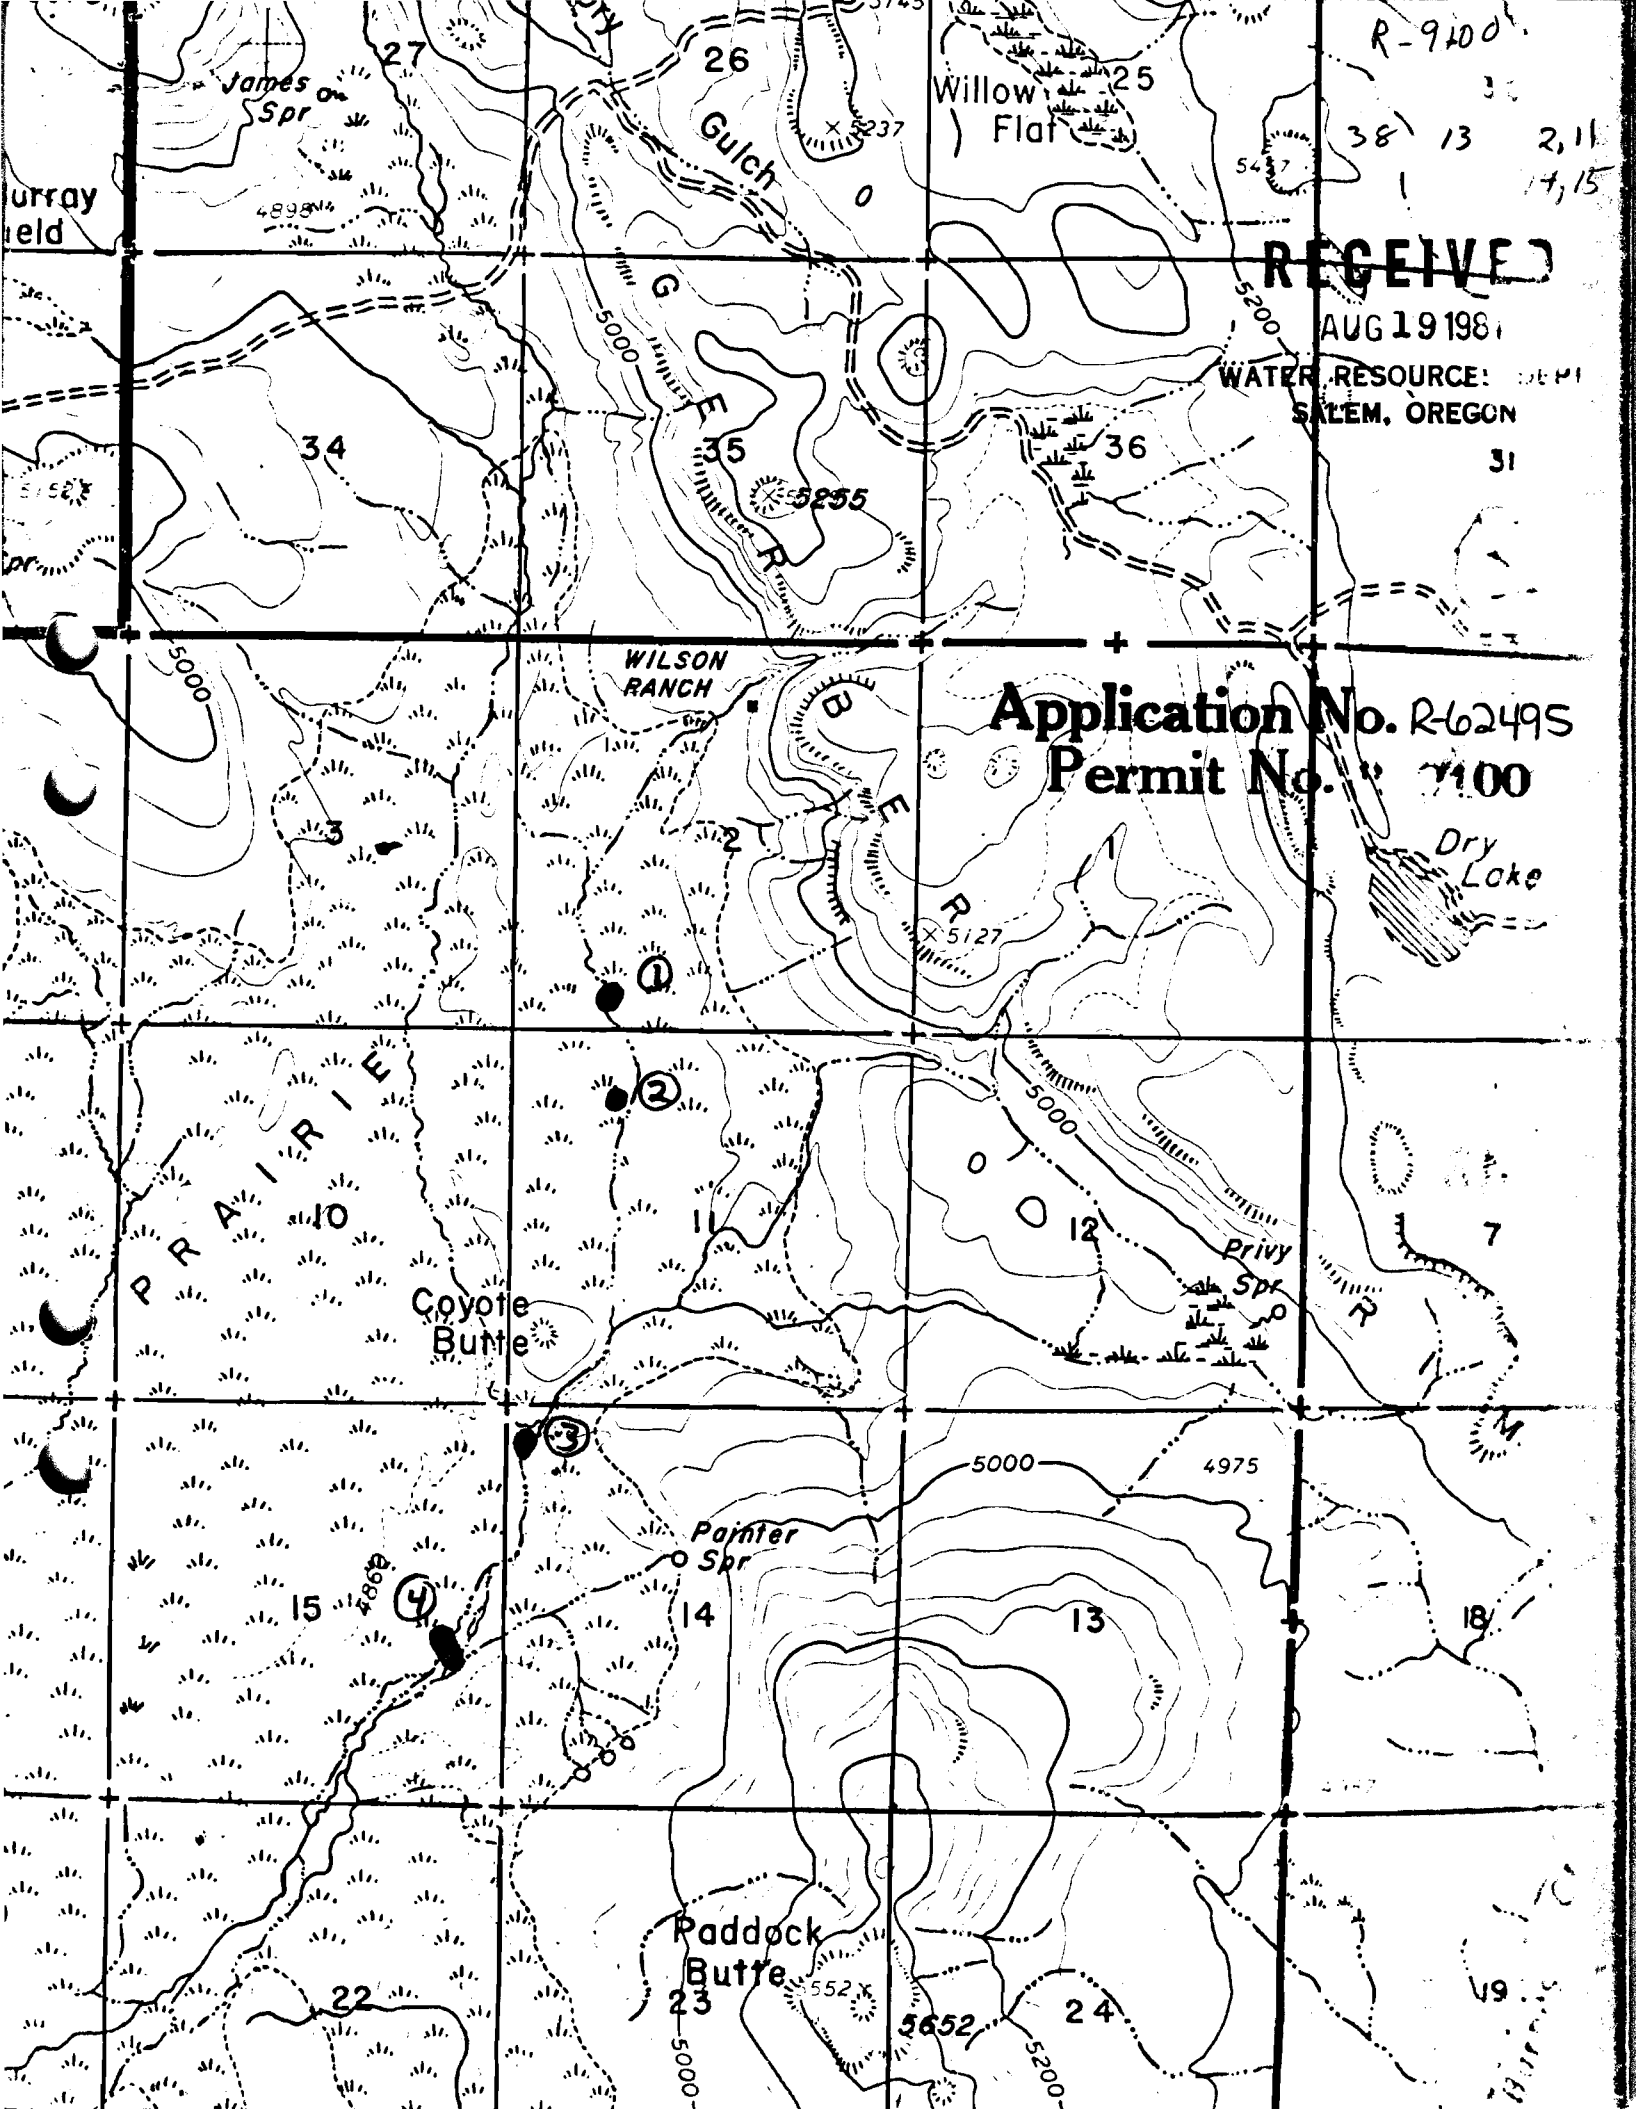

R-9100

38 13 2, 11
17, 15

RECEIVED

AUG 19 1981

WATER RESOURCE DEPT
SALEM, OREGON

31

Application No. R-62495
Permit No. 9100

Dry Lake

PRAIRIE

Coyote Butte

Painters Spr

Paddock Butte

19