

RECEIVED

R 9102
59198

AUG 19 1981


FIELD MAP SHEET WATER RESOURCES DEPT
SALEM, OREGON

T. 39S 119S R. 15E Sec. Subdiv. N.F.

Mapped by Reviewed by Scale 2 inches = 1 Mile

- ROAD
- DRAINAGE
- RESERVOIR

Application No. R-62500, 19
Permit No. R 9102

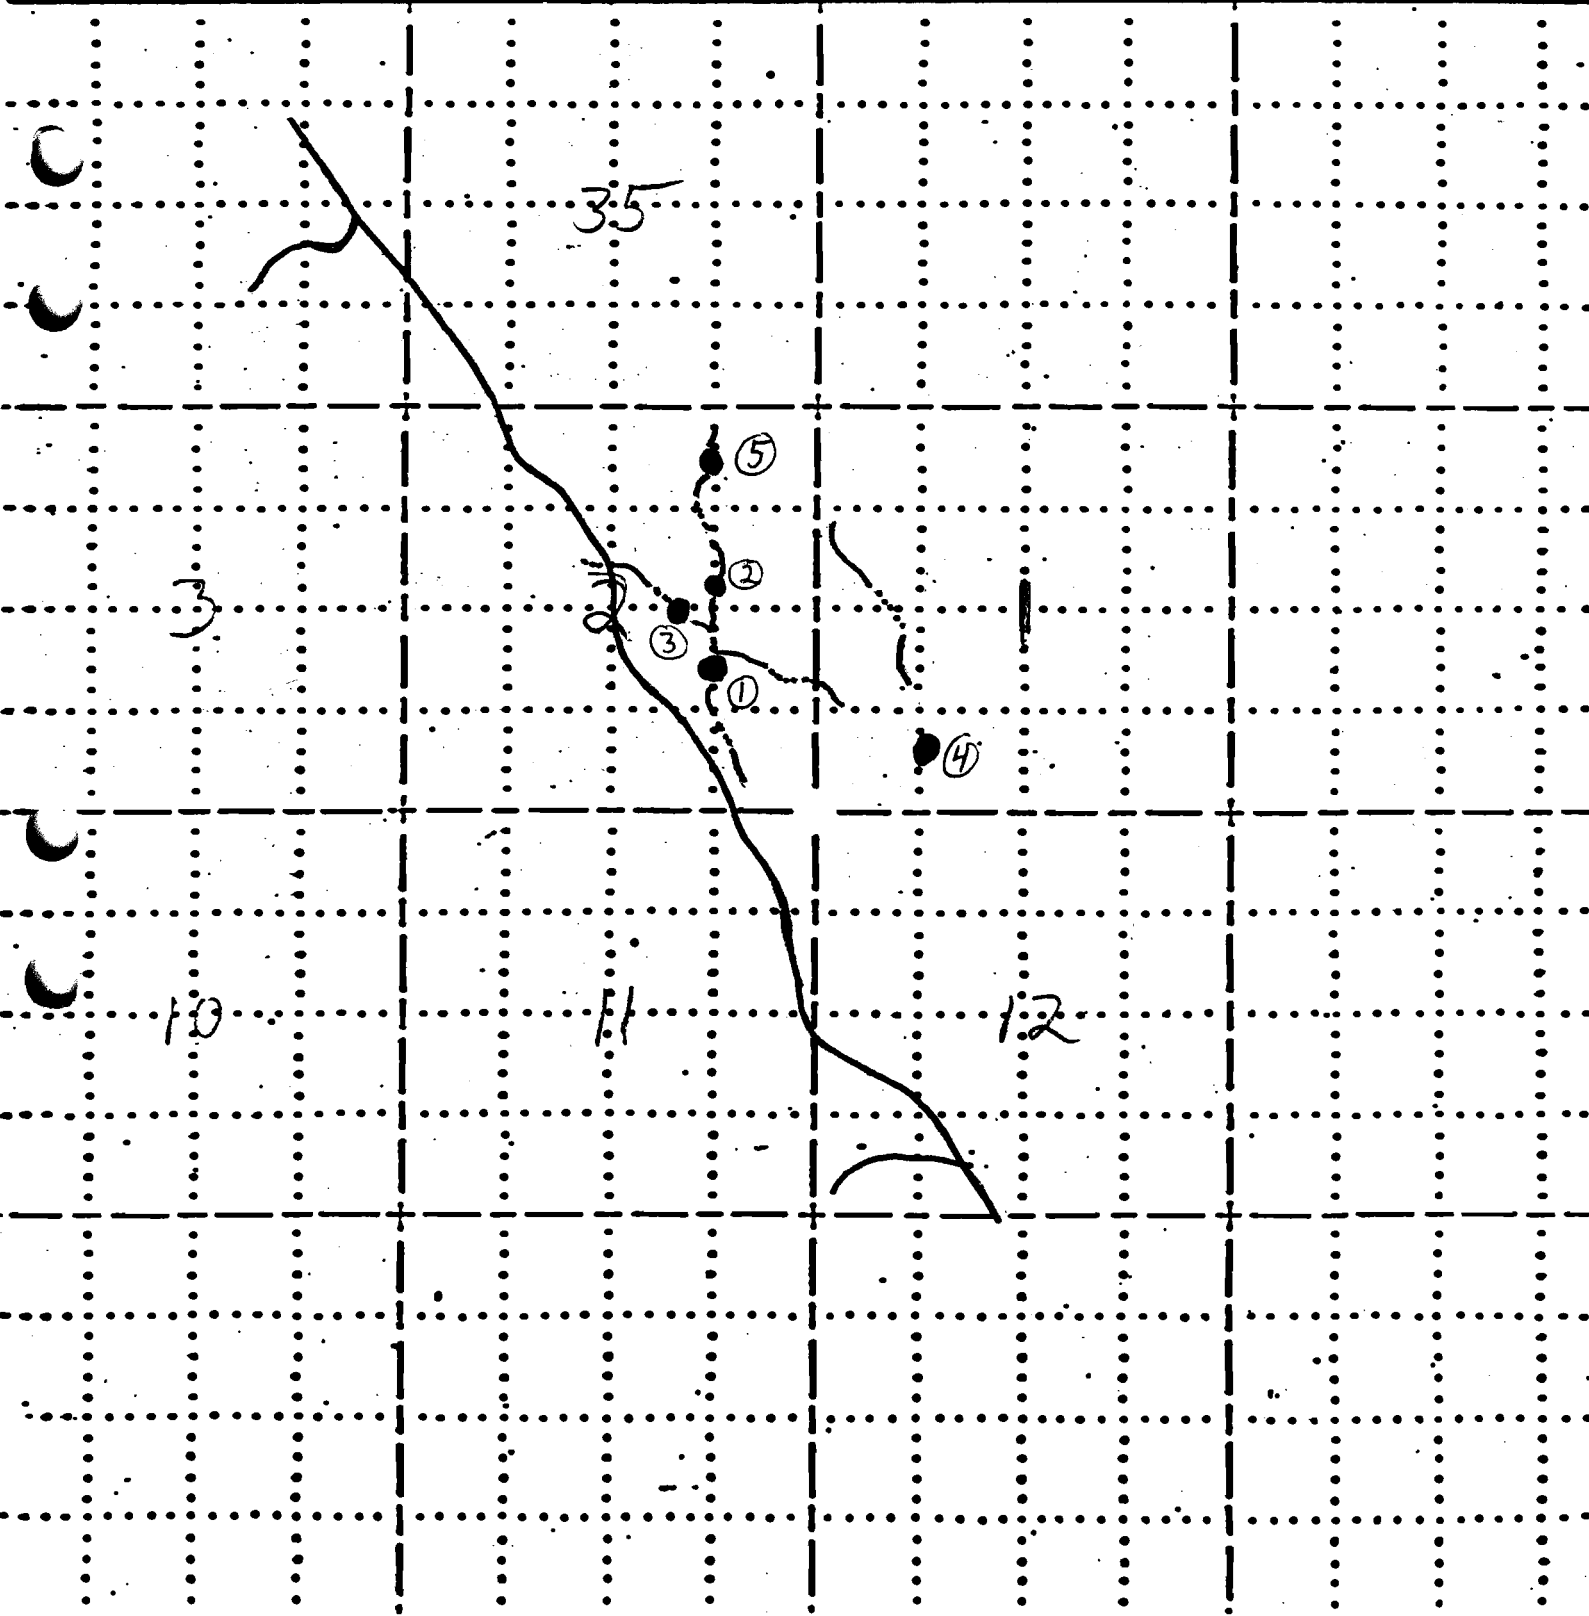


R-9102

RECEIVED

AUG 19 1981

WATER RESOURCES DEPT
SALEM, OREGON

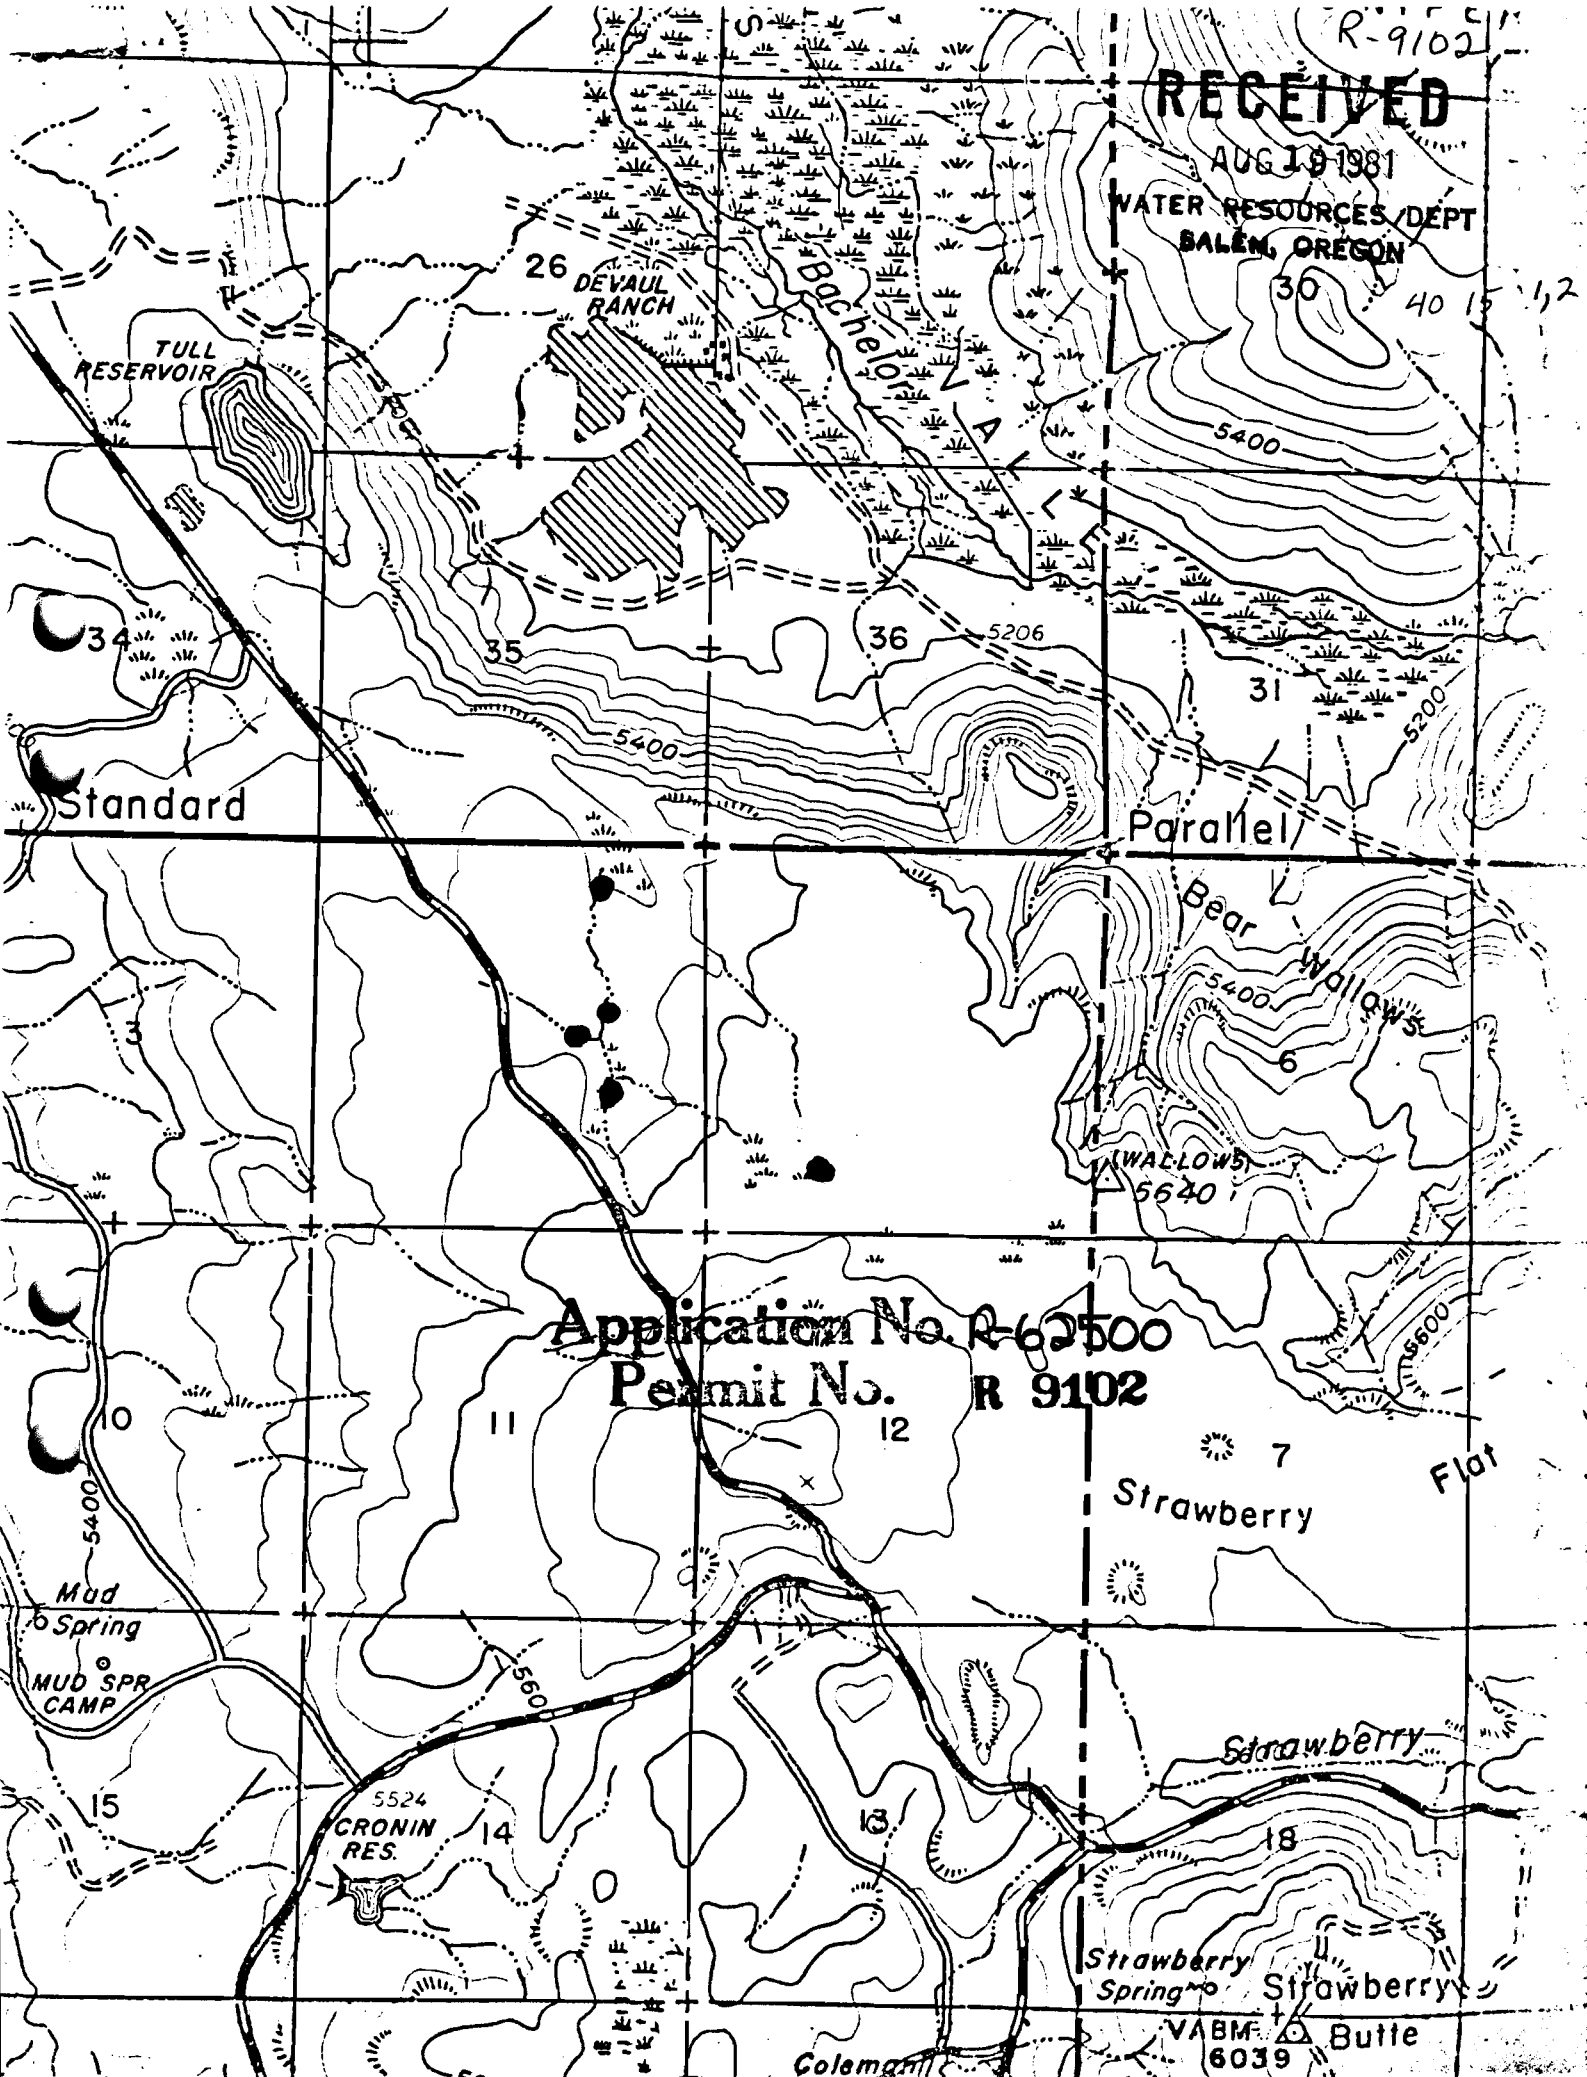

Application No. R-62500
Permit No. R 9102

VABM 6039 Butte