

RECEIVED

R 9107
59203

AUG 29 1981

FIELD MAP SHEET

WATER RESOURCES DEPT
SALEM, OREGON


T. 39S/27N R. 15E/16E Sec. Subdiv. N.F.

Mapped by Reviewed by Scale 7 inches = 1 Mile

- RESERVIOR
- DRAINAGE
- ROAD

Application No. R-62506
Permit No. R 9107

19

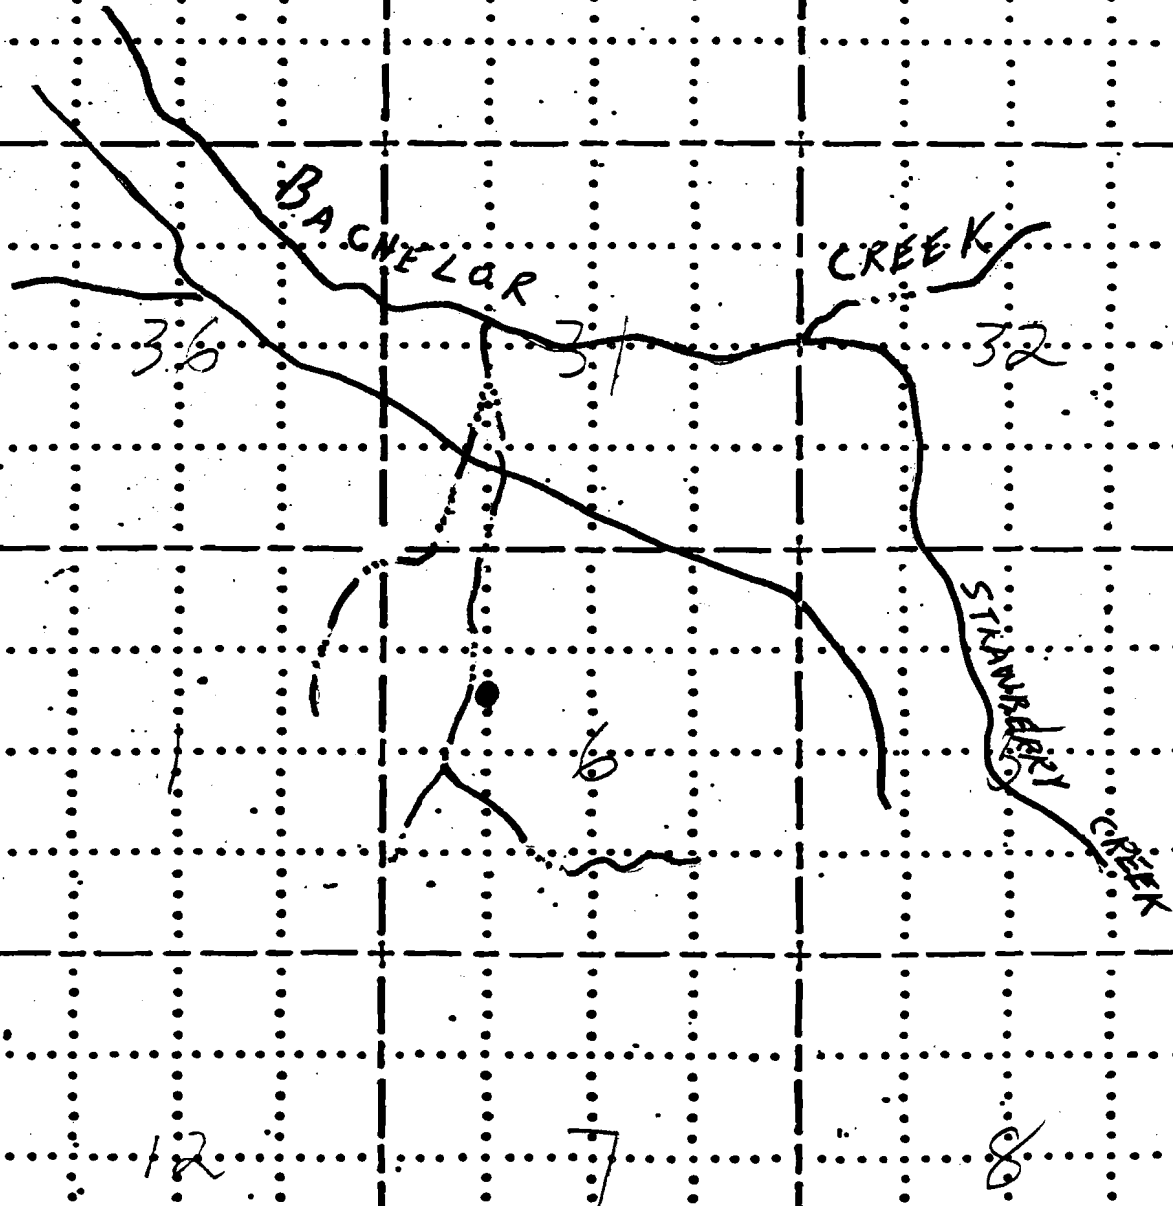


R-9107

40 16 6

RECEIVED

AUG 29 1981

WATER RESOURCES DEPT
SALEM, OREGON

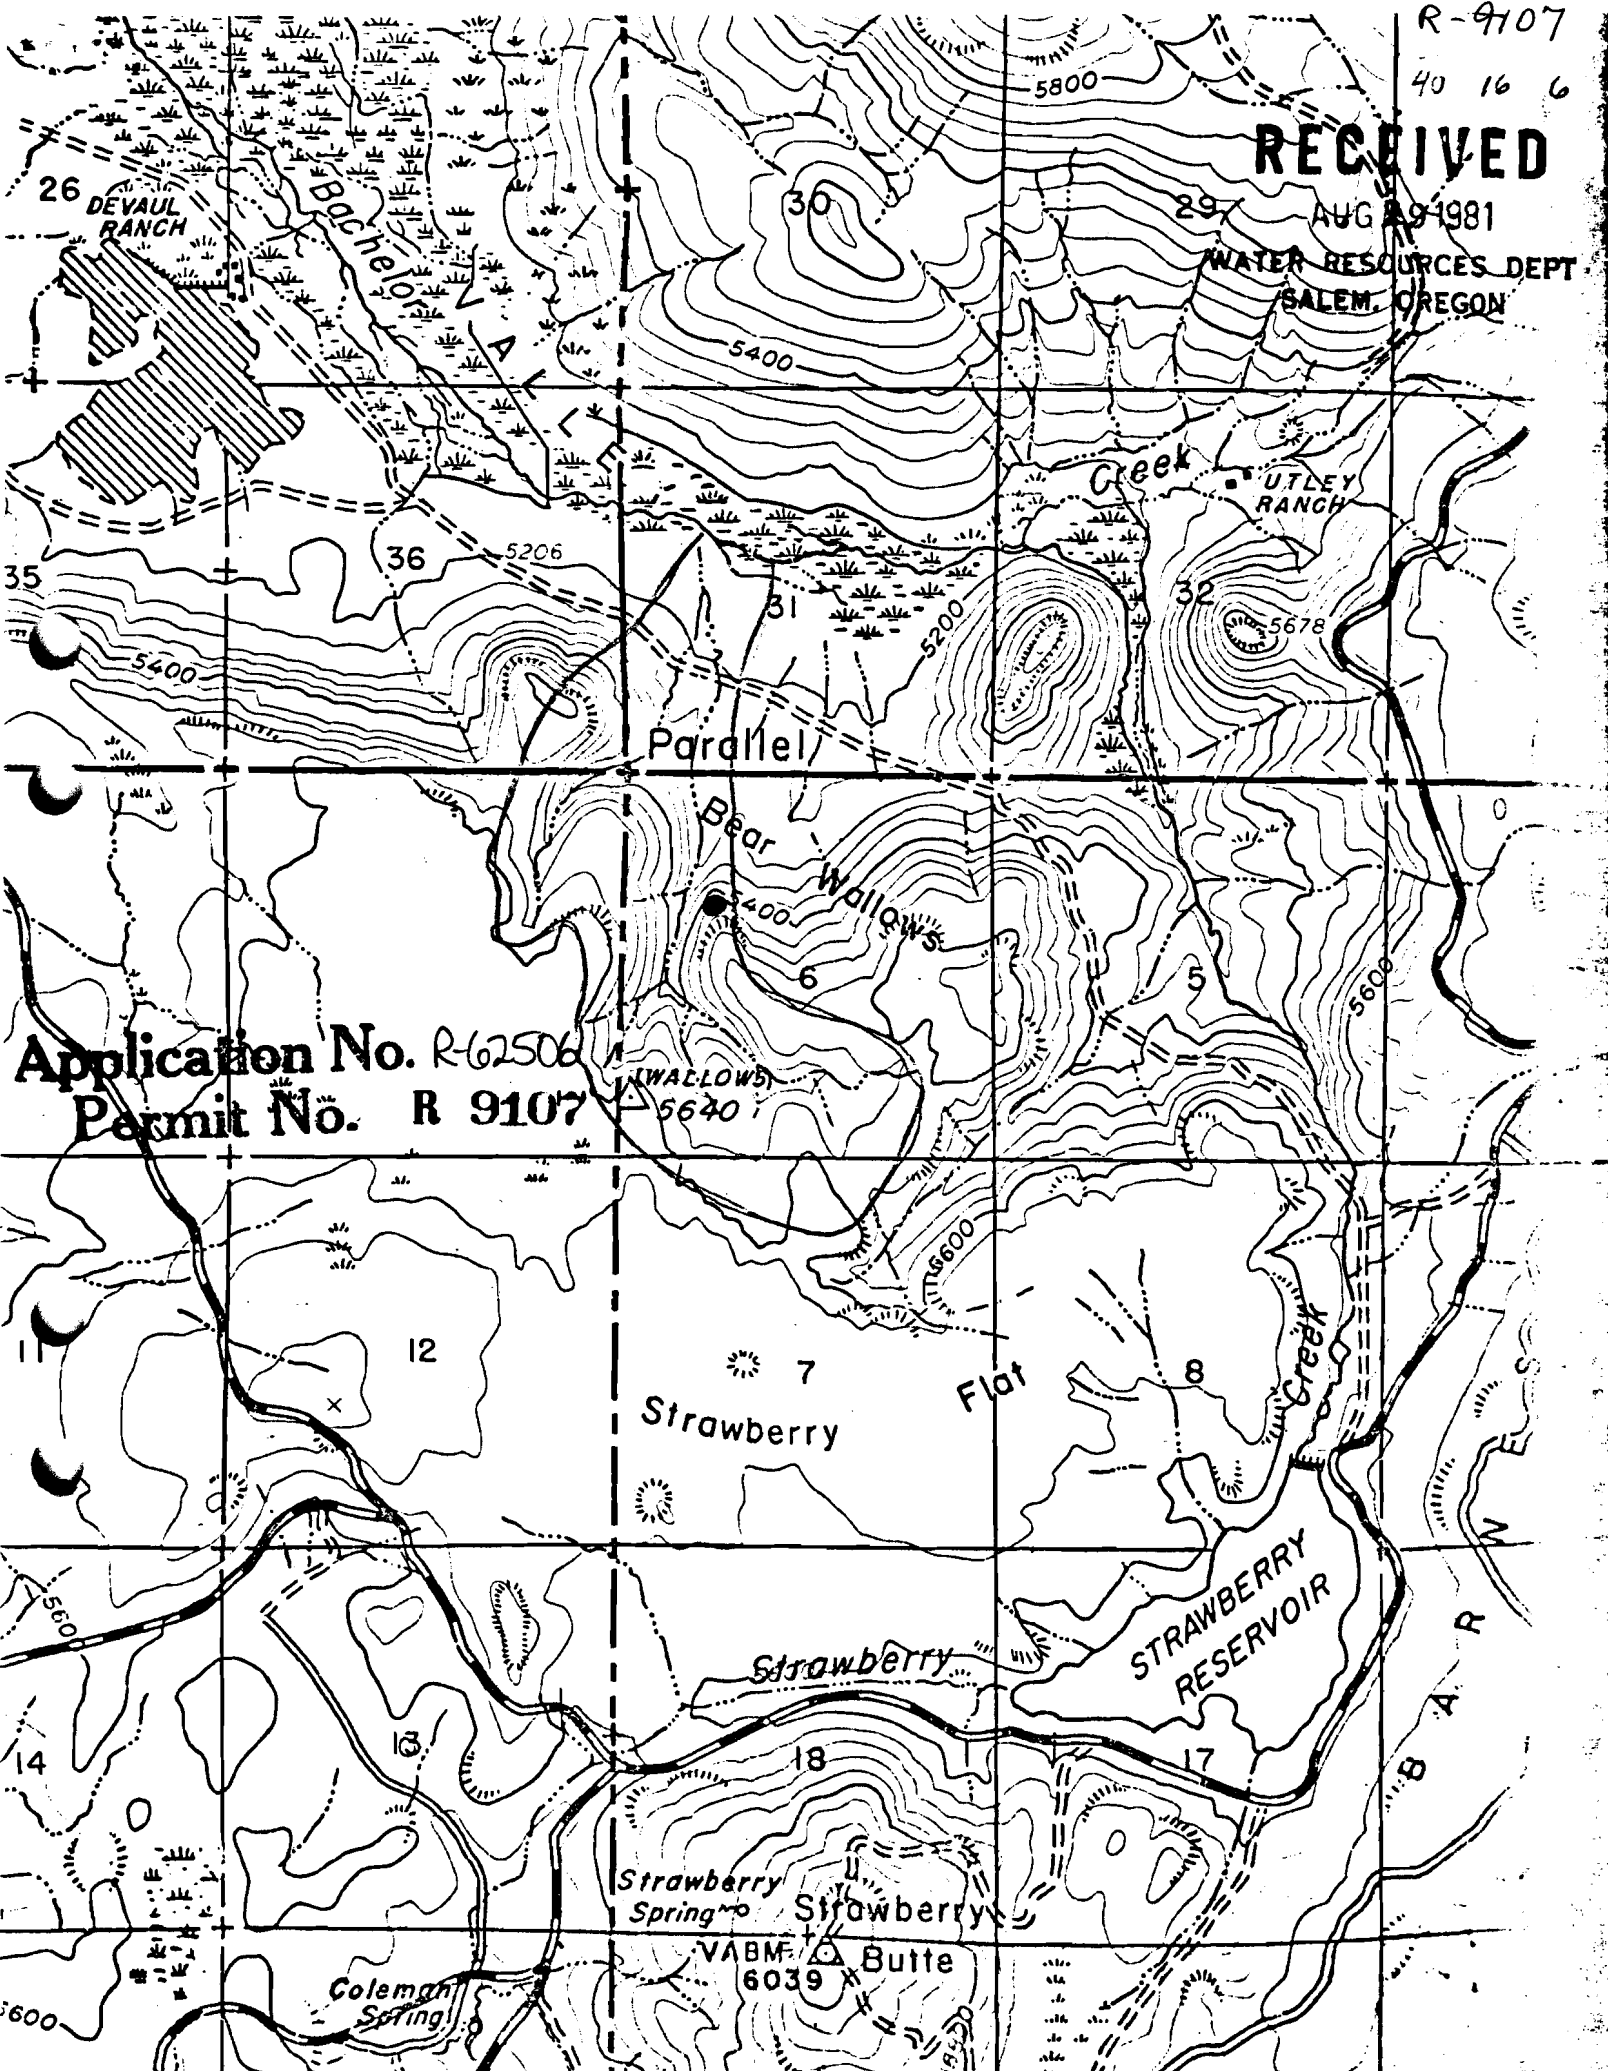

Application No. R-62506
 Permit No. R 9107

WALLOWS
 5640

STRAWBERRY
 RESERVOIR

Strawberry Spring
 VABM 6039
 Strawberry Butte