


RECEIVED R9108  
59204

AUG 19 1981

WATER RESOURCES DEPT  
SALEM, OREGON

40 17 10

Application No. R-62509  
Permit No. R 9108

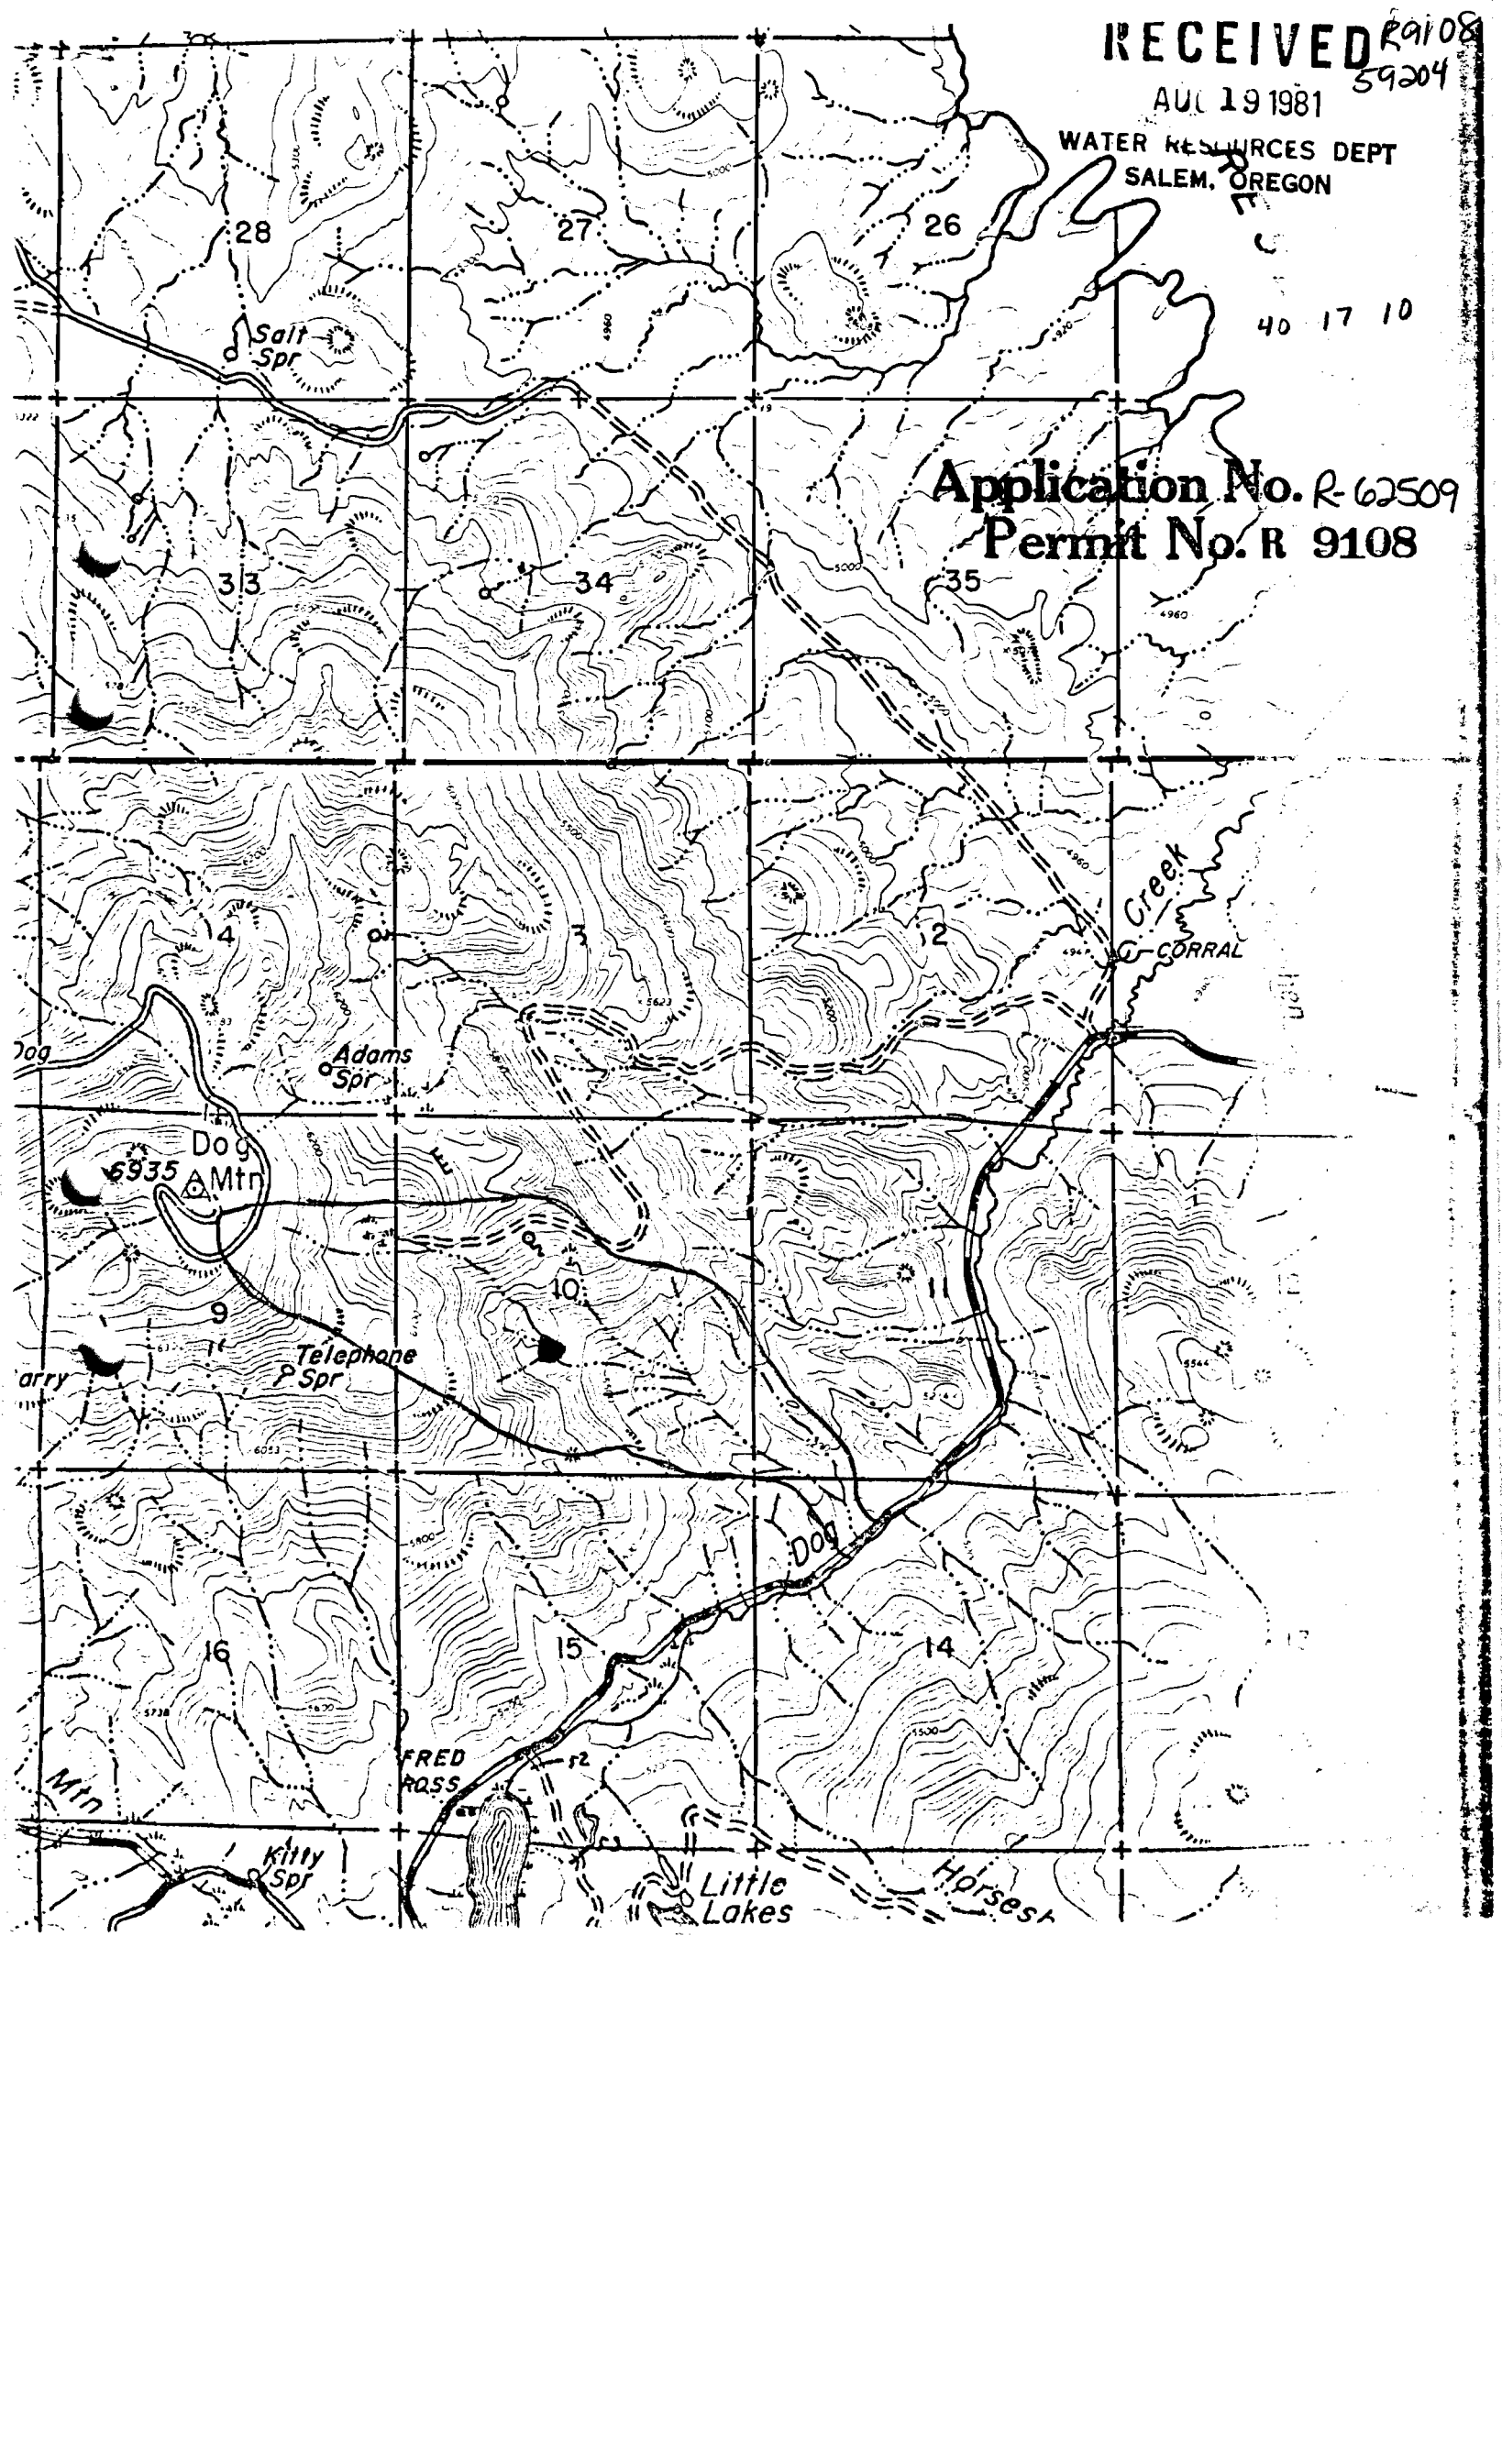

FIELD MAP SHEET

T. 40 S. R. 17 E. Sec. Subdiv. N.F.

Mapped by Reviewed by Scale 2 inches = 1 Mile

ROAD  
DRAINAGE  
RESERVOIR

Application No. R-62509  
Permit No. R 9108

