


R9111
RECEIVED
AUG 19 1981 59207
WATER RESOURCES DEPT
SALEM, OREGON

Application No. R-62512
Permit No. R 9111

41 18 8

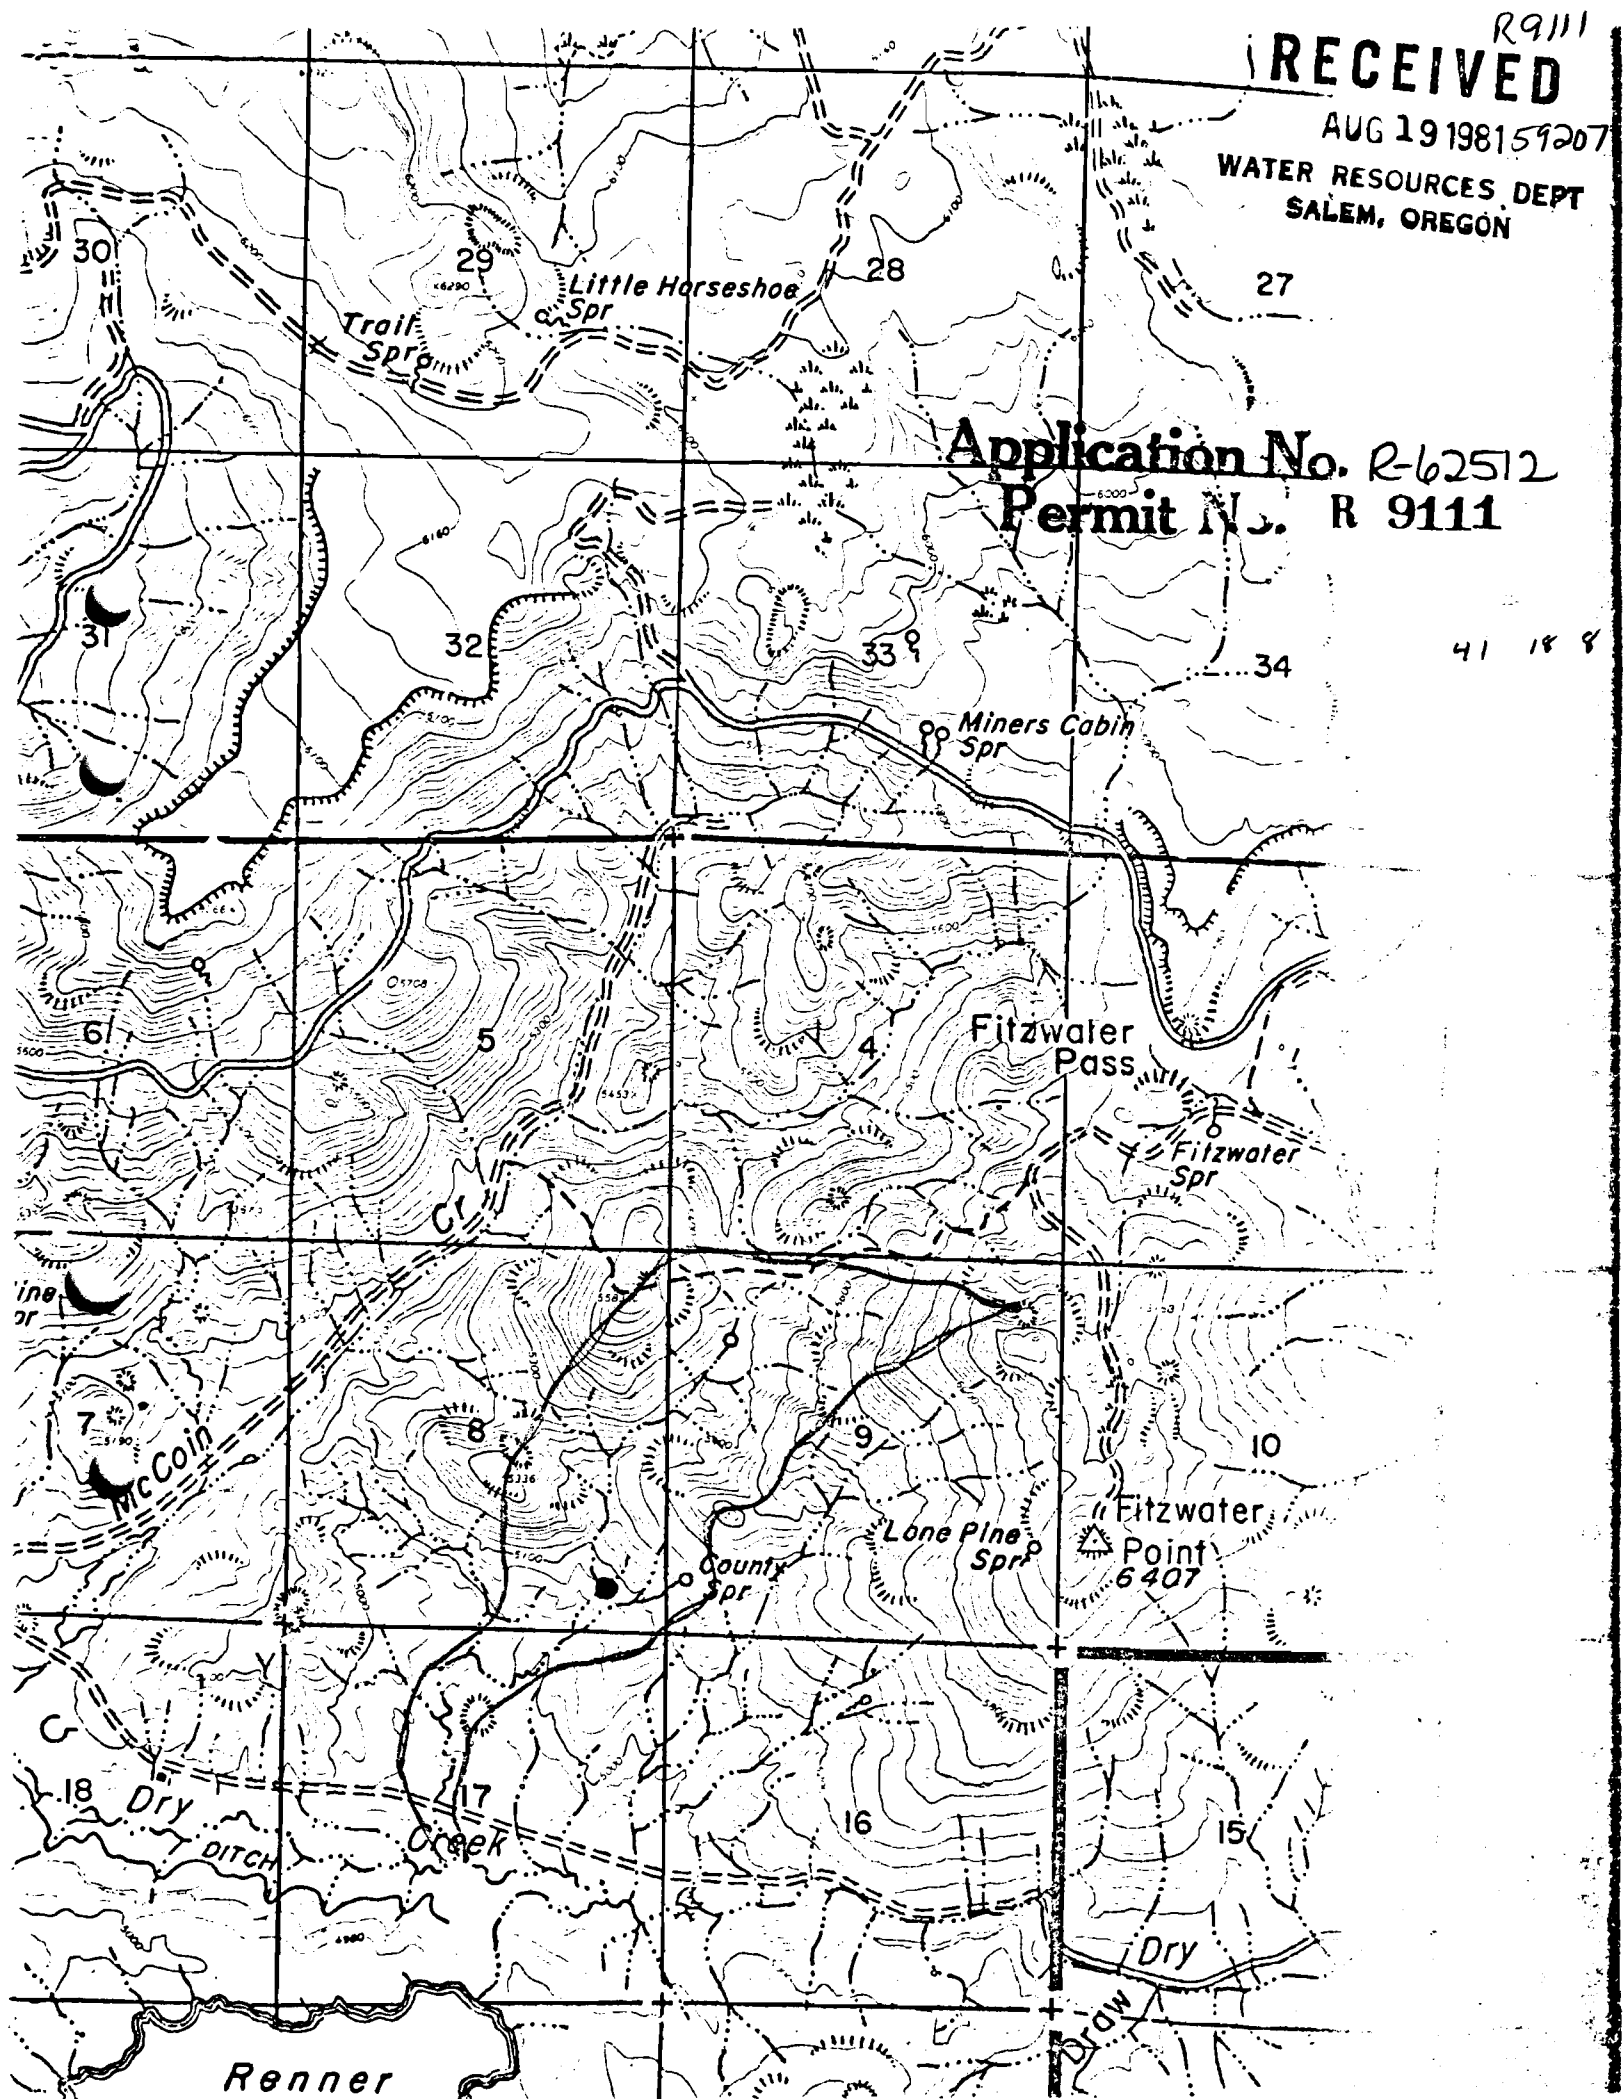

RECEIVED

AUG 19 1981

WATER RESOURCES DEPT
SALEM, OREGON

FIELD MAP SHEET

T. 41S R. 18E Sec. Subdiv. N.F.

Mapped by Reviewed by Scale inches = 1 Mile

- RESERVIOR
- DRAINAGE
- ROAD

Application No. R-62512

Permit No. R 9111

19

