

FIELD MAP SHEET WATER RESOURCES DEPT
SALEM, OREGON


T. ^{40S}41S R. 17E Sec. Subdiv. N.F.

Mapped by Reviewed by Scale 2 inches = 1 Mile

- RESERVOIR
- DRAINAGE
- ROAD

Application No. R-62514

Permit No. R 9113

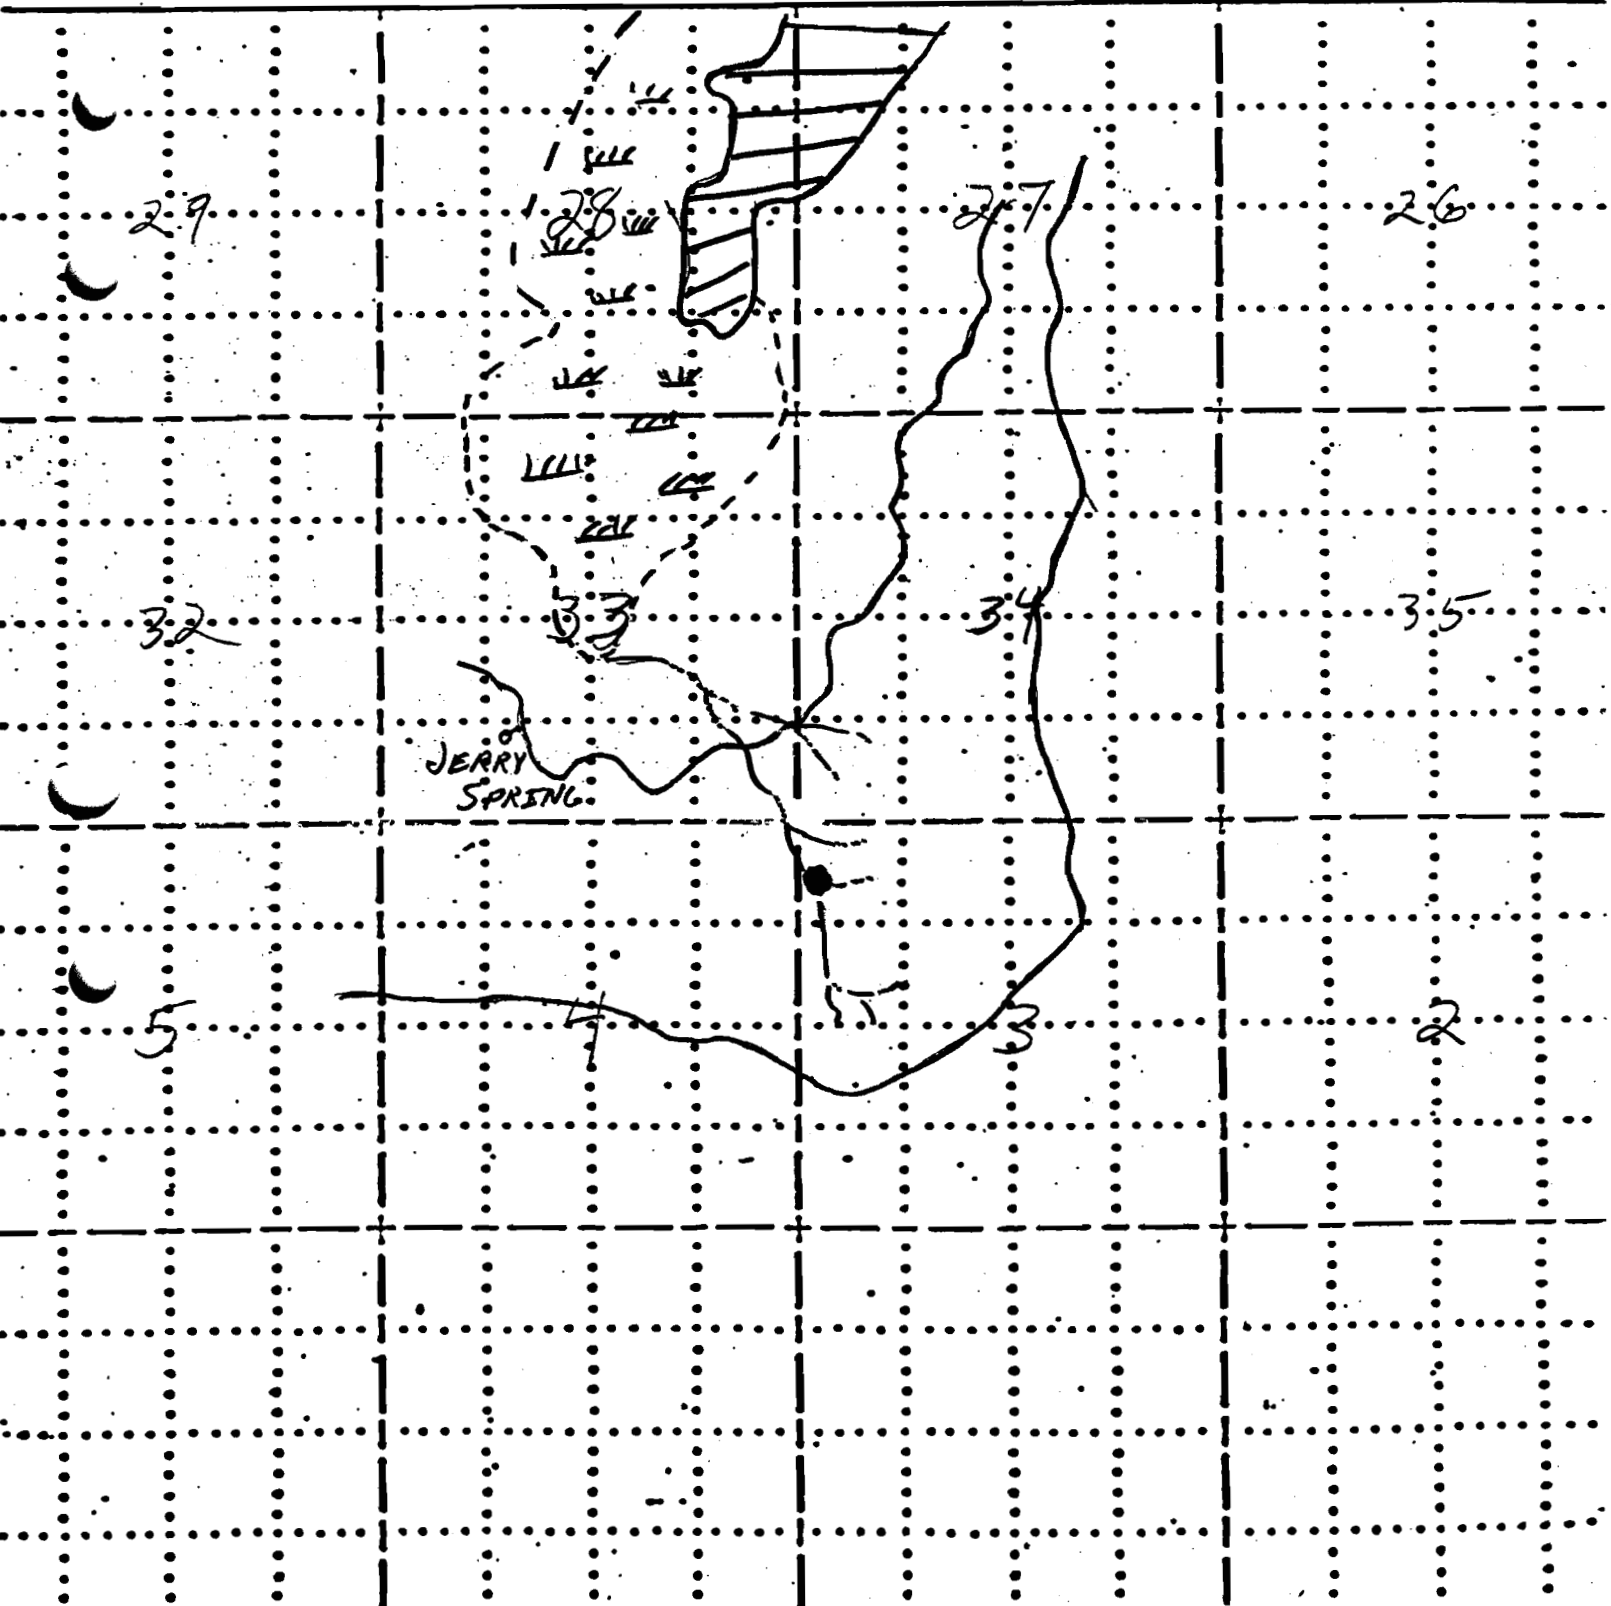

RECEIVED

AUG 19 1981

WATER RESOURCES DEPT
SALEM, OREGON

Application No. R-62514
Permit No. R 9113

