

RECEIVED

R9115  
59211

AUG 19 1981


FIELD MAP SHEET WATER RESOURCES DEPT  
SALEM, OREGON

T. 40S R. 18E Sec. .... Subdiv. .... N.F.

Mapped by ..... Reviewed by ..... Scale 2 inches = 1 Mile

- RESERVOIR
- DRAINAGE
- ROAD

Application No. R-62517  
Permit No. R 9115

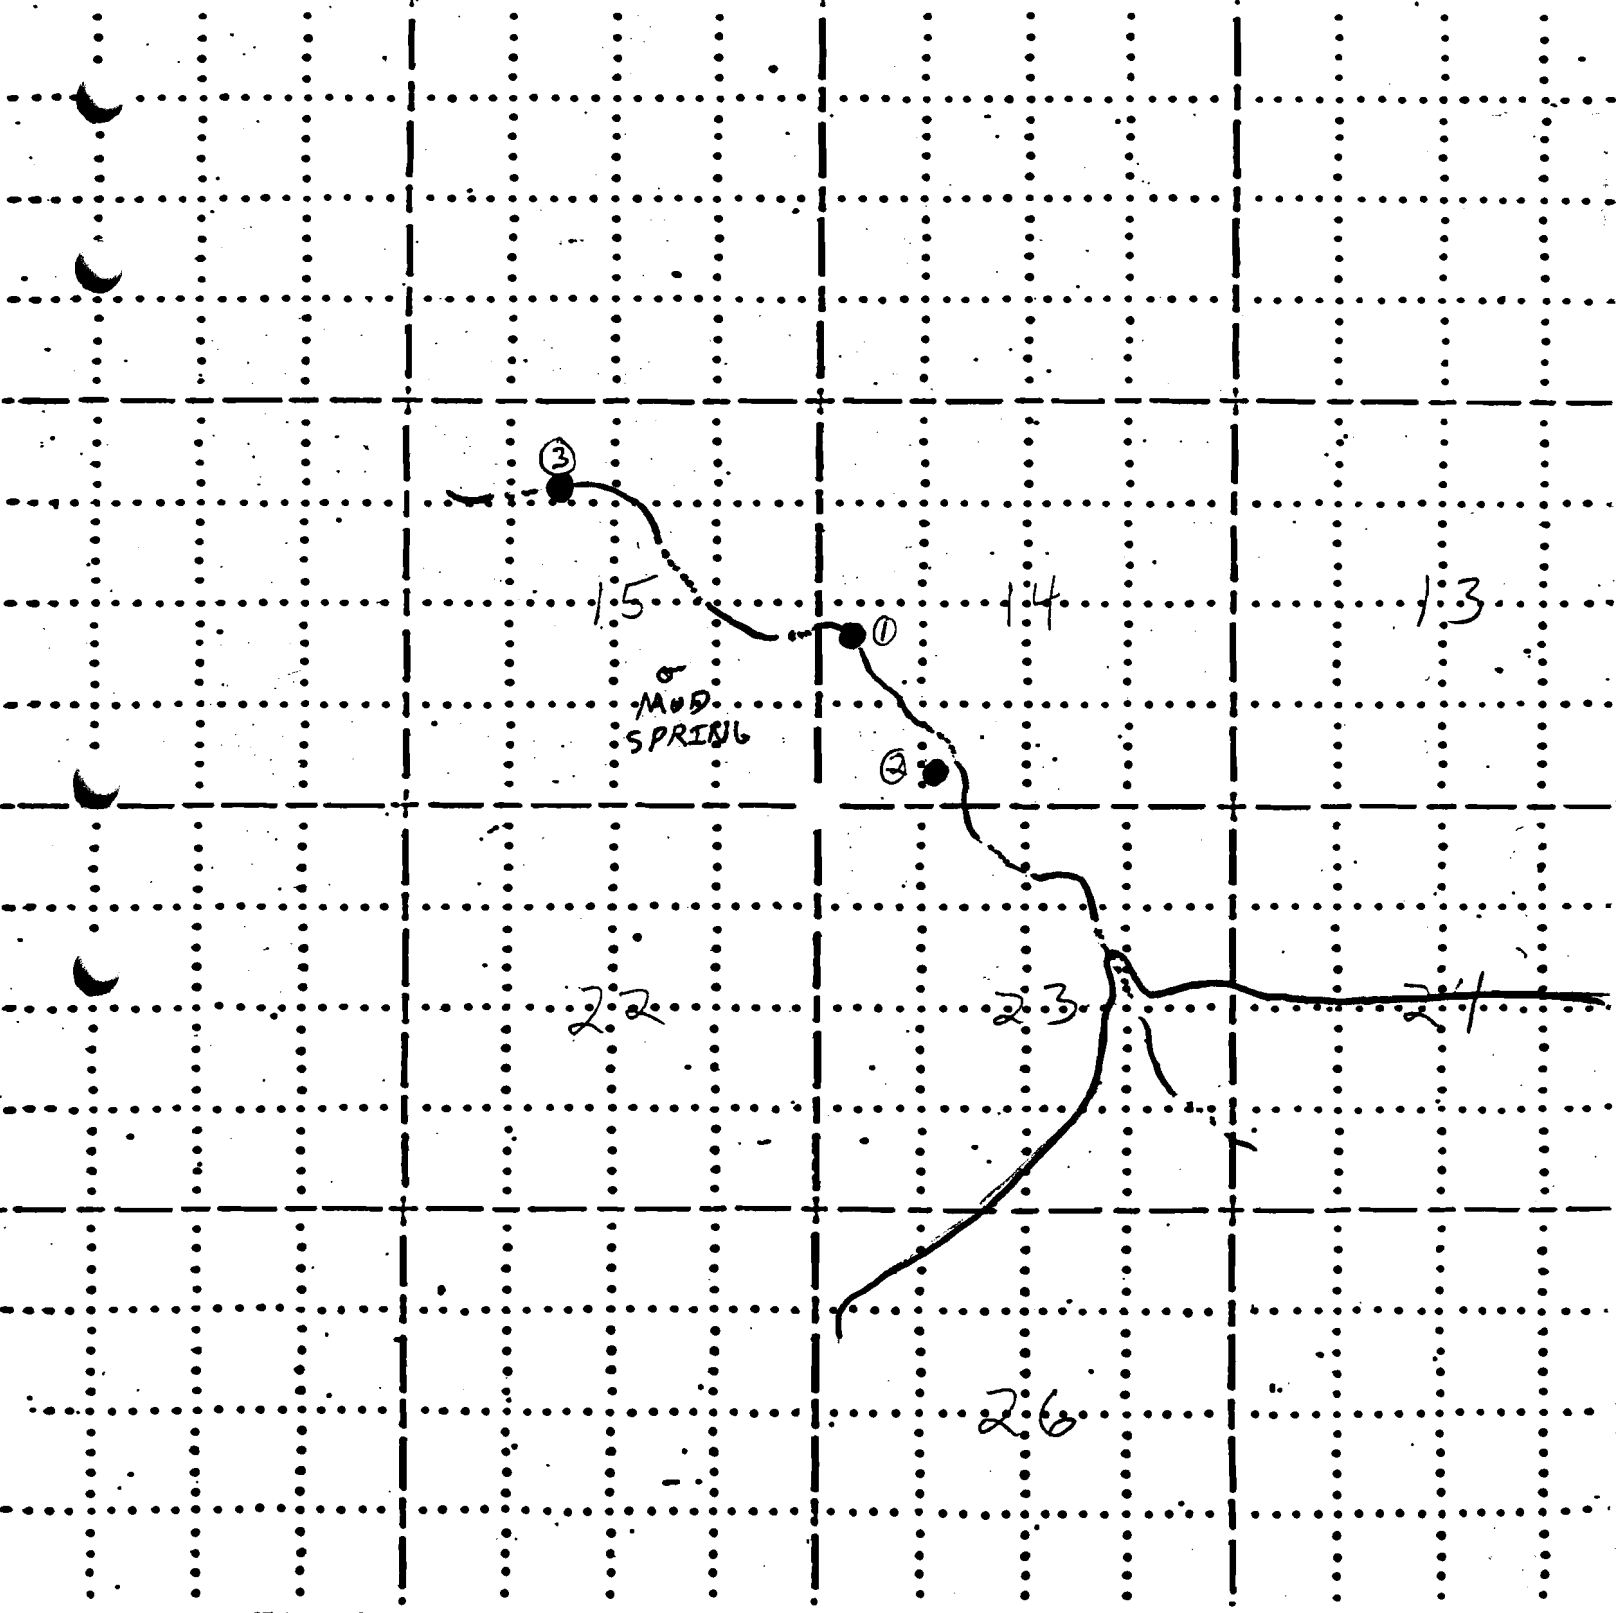

48 18 14, 15

Parallel

RECEIVED

AUG 19 1981

WATER RESOURCES DEPT  
SALEM, OREGON

Application No. R-62517  
Permit No. R 8115

BEHM RANCH

LAKEVIEW

USERS

SOUTH

FRIDAY RANCH

BECCRAFT RANCH

DAB'S WELL

Venator

