

AUG 19 1981

FIELD MAP SHEET WATER RESOURCES DEPT
SALEM, OREGON


T. 40S R. 17E/18E Sec. Subdiv. N.F.

Mapped by Reviewed by Scale 2 inches = 1 Mile

- RESERVOIR
- DRAINAGE
- DIRT ROAD

Application No. R-62518, 19

Permit No. R 9116

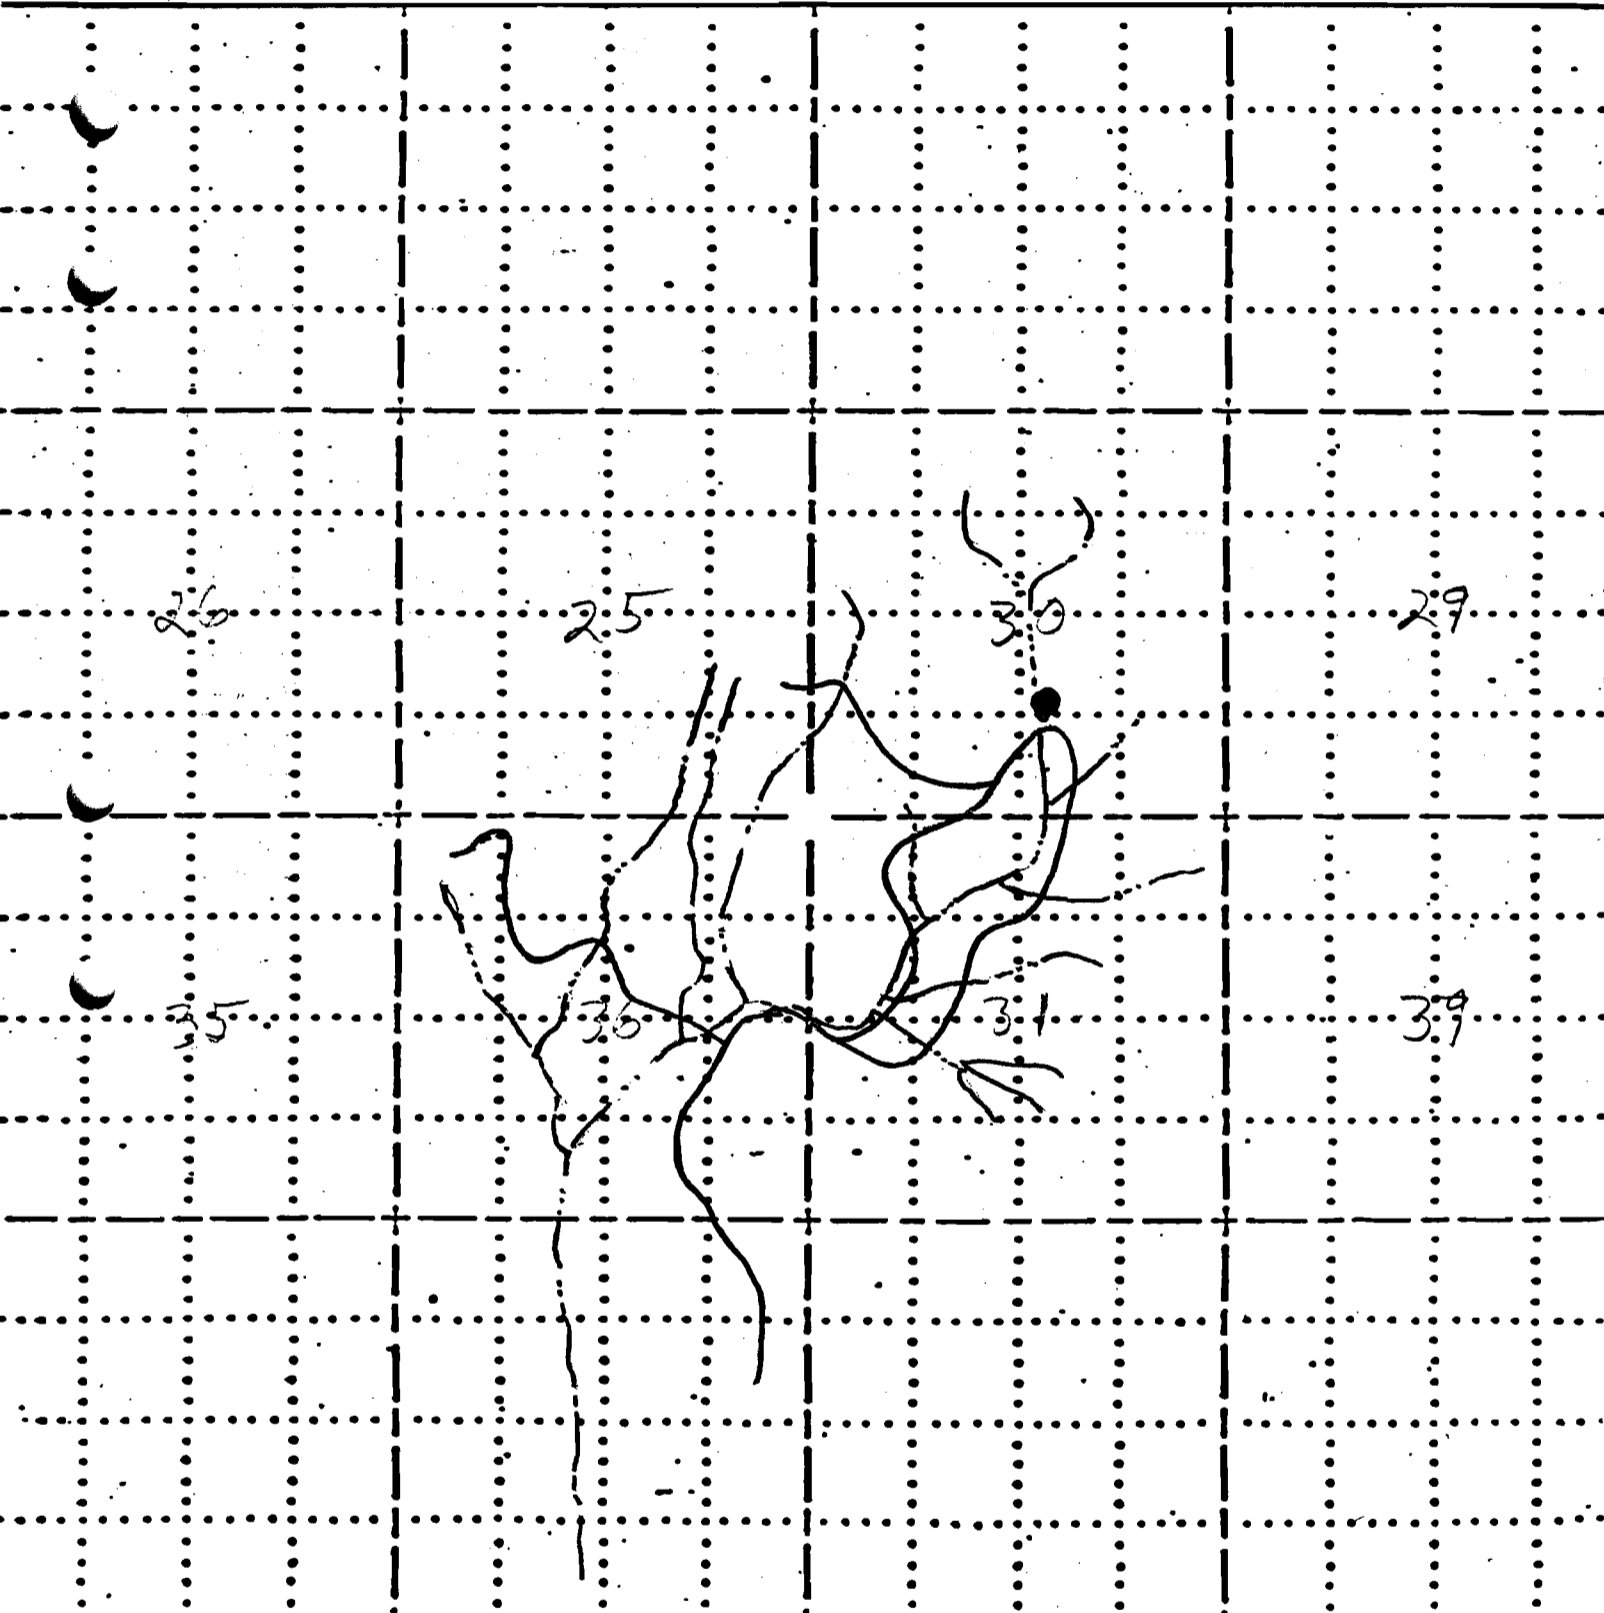

RECEIVED

AUG 19 1981

WATER RESOURCES DEPT
SALEM, OREGON

Bee
Spr
16
40 18 30

Application No. R-62518
Permit No. R 9116

