

FIELD MAP SHEET

AUG 19 1981


WATER RESOURCES DEPT
SALEM, OREGON N.F.

T. 41S R. 18E Sec. Subdiv.

Mapped by _____ Reviewed by _____ Scale 2 inches = 1 Mile

- RESERVIOR
- DRAINAGE
- ROAD

Application No. R-62519
Permit No. R 9117

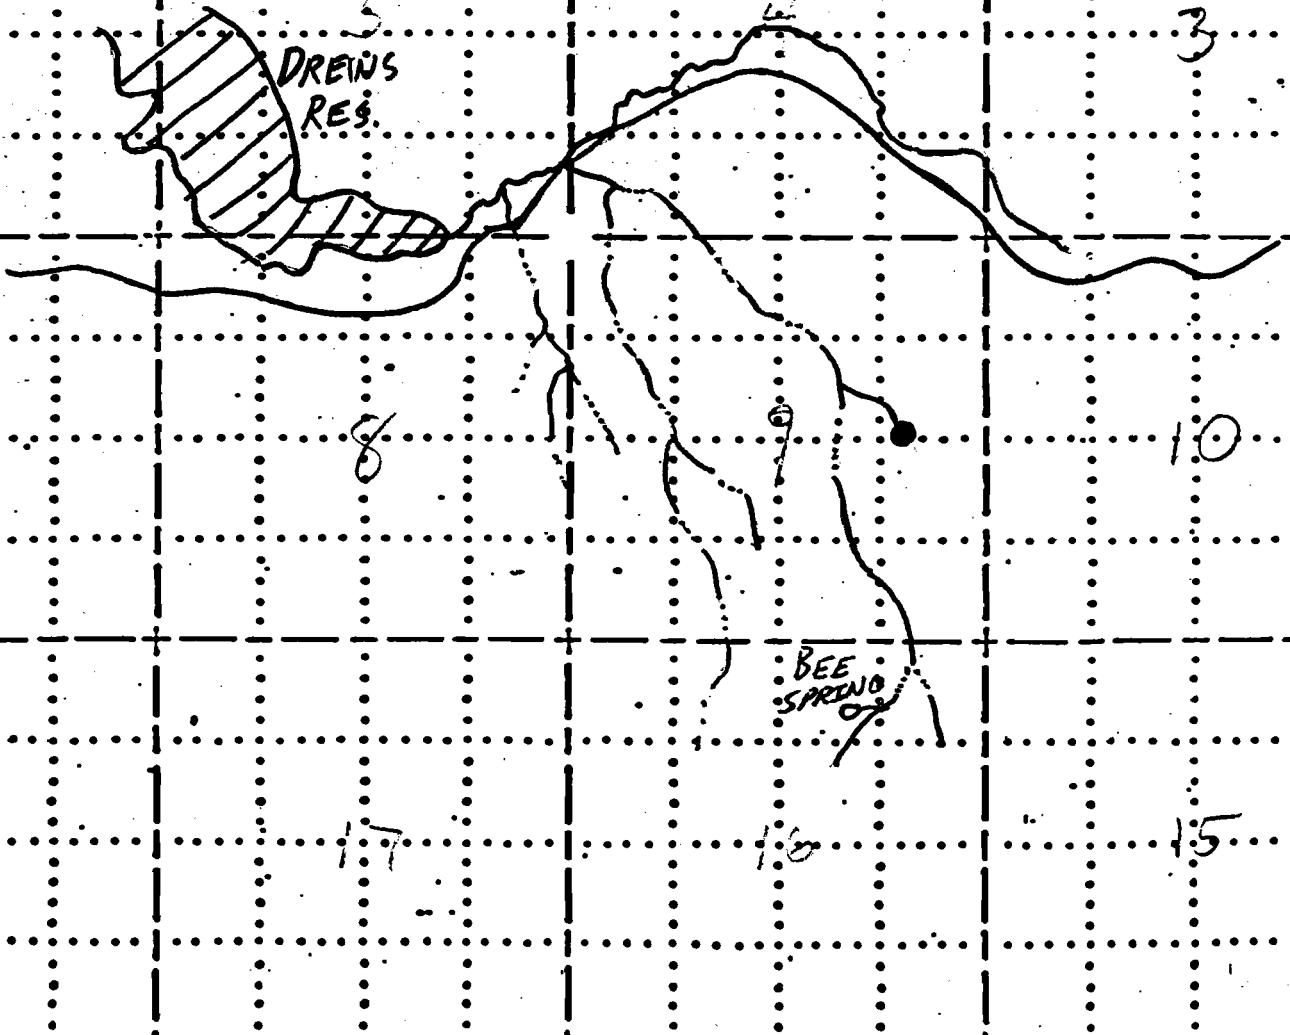

RECEIVED

AUG 19 1981

WATER RESOURCES DEPT
SALEM, OREGON

40 18 9

Application No. R-62519
Permit No. R 9117

