

RECEIVED 59217

AUG 19 1981

WATER RESOURCES DEPT
SALEM, OREGON


FIELD MAP SHEET

T. 38 S R. 16 E Sec. Subdiv. N.F.

Mapped by Reviewed by Scale 2 inches = 1 Mile

Application No. R-62532

Permit No. R 9130

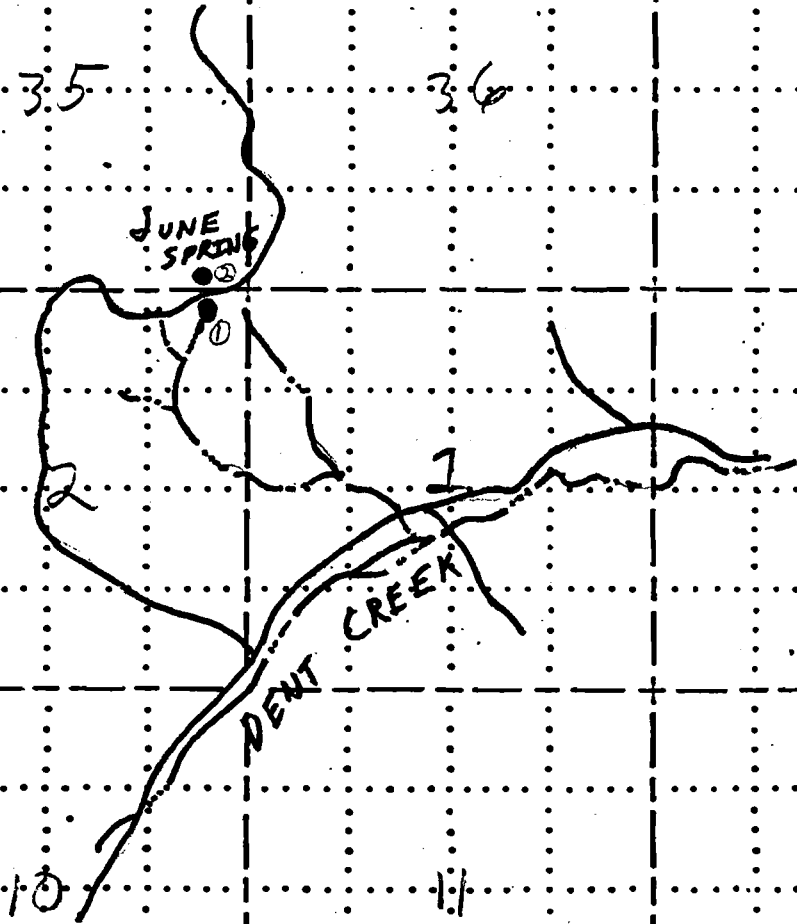

STRAWBERRY BUTTE QUADRANGLE
OREGON

Application No. R-62532

Permit No. R 9130

39 16 2
38 16 35


120° 45'
42° 15'

S.E.

RECEIVED

AUG 19 1981

WATER RESOURCES DEPT
SALEM, OREGON

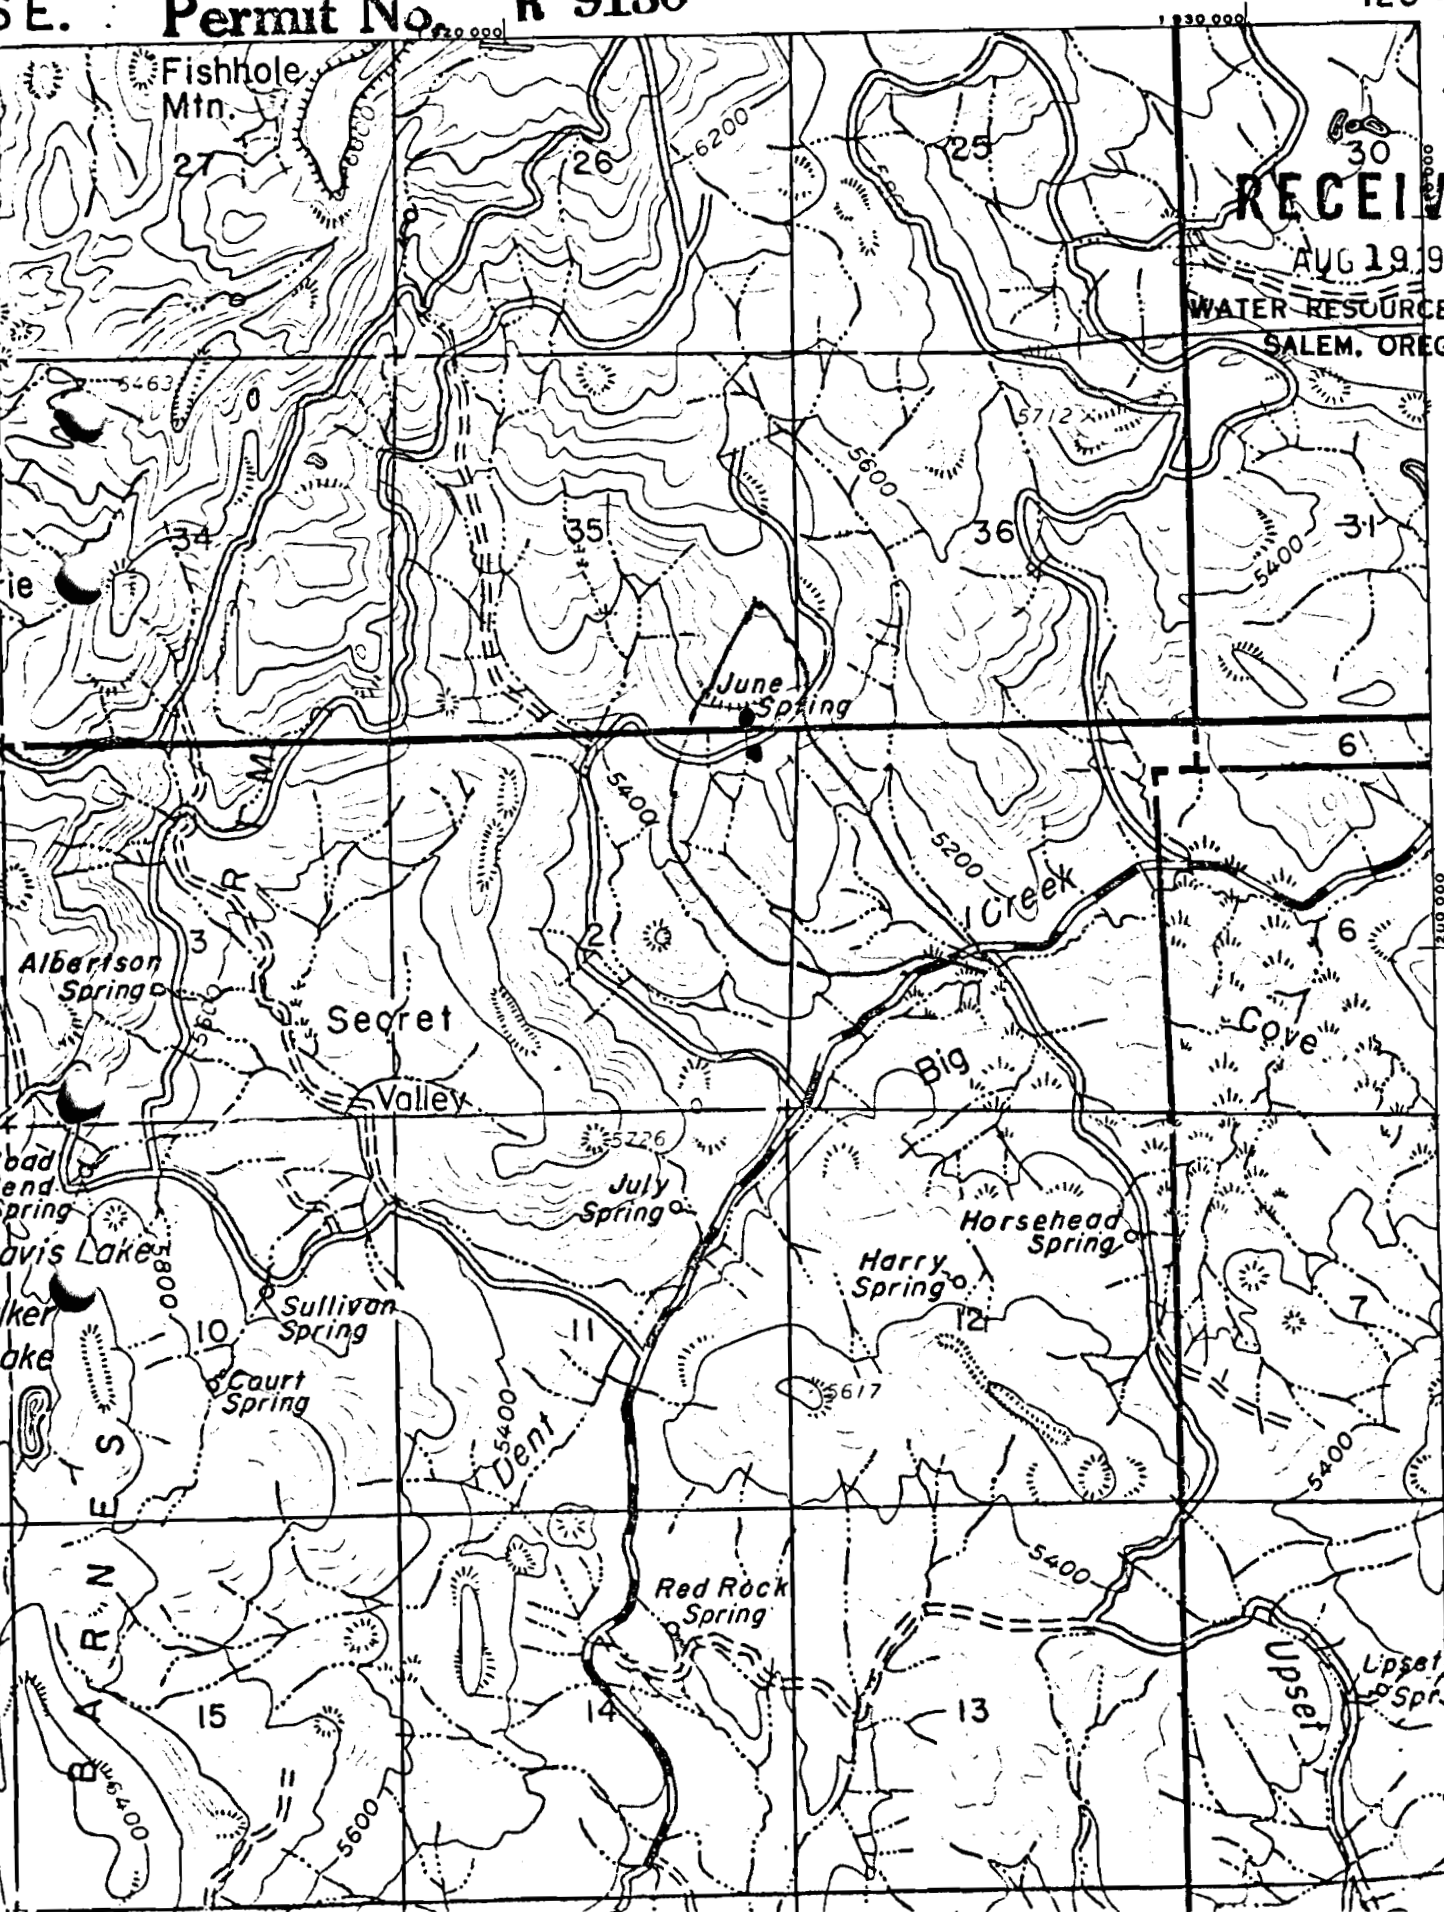

T.3

T.3

T.3