

AUG 19 1961

FIELD MAP SHEET

WATER RESOURCES DEPT
SALEM, OREGON

T. 39S R. 16E/17E Sec. Subdiv. N.F.


Mapped by Reviewed by Scale 2 inches = 1 Mile

- RESERVOIR
- DRAINAGE
- ROAD

Application No. R-62533

Permit No. R 9131

19

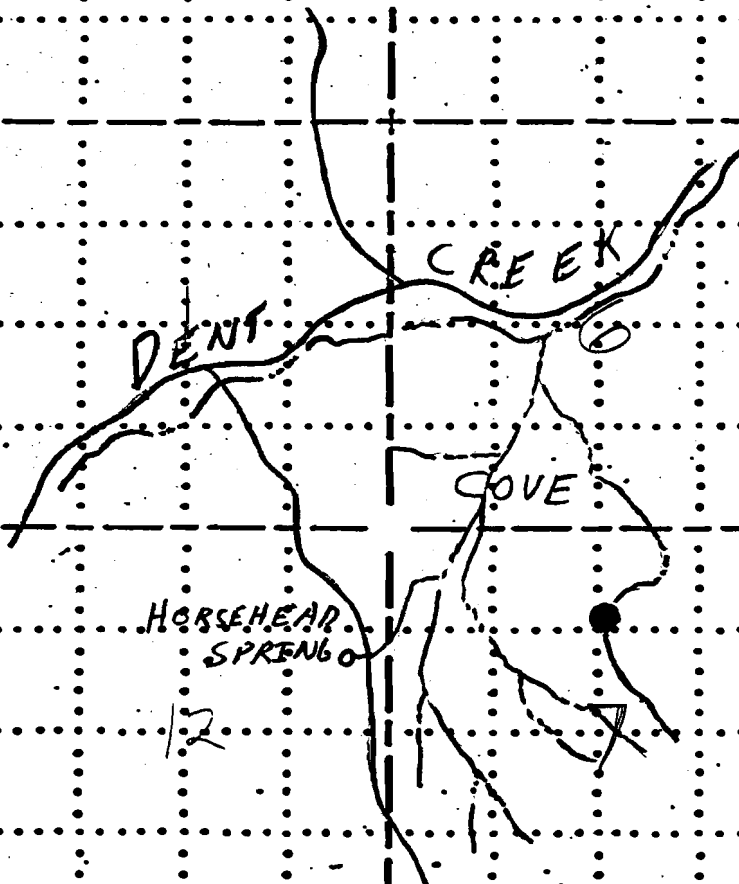

42 13
T.38 S.

Application No. R-62533
Permit No. R 9131

T.38 1/2 S.


39 17 7

RECEIVED

AUG 19-1981

WATER RESOURCES DEPT
SALEM, OREGON

T.39 S.

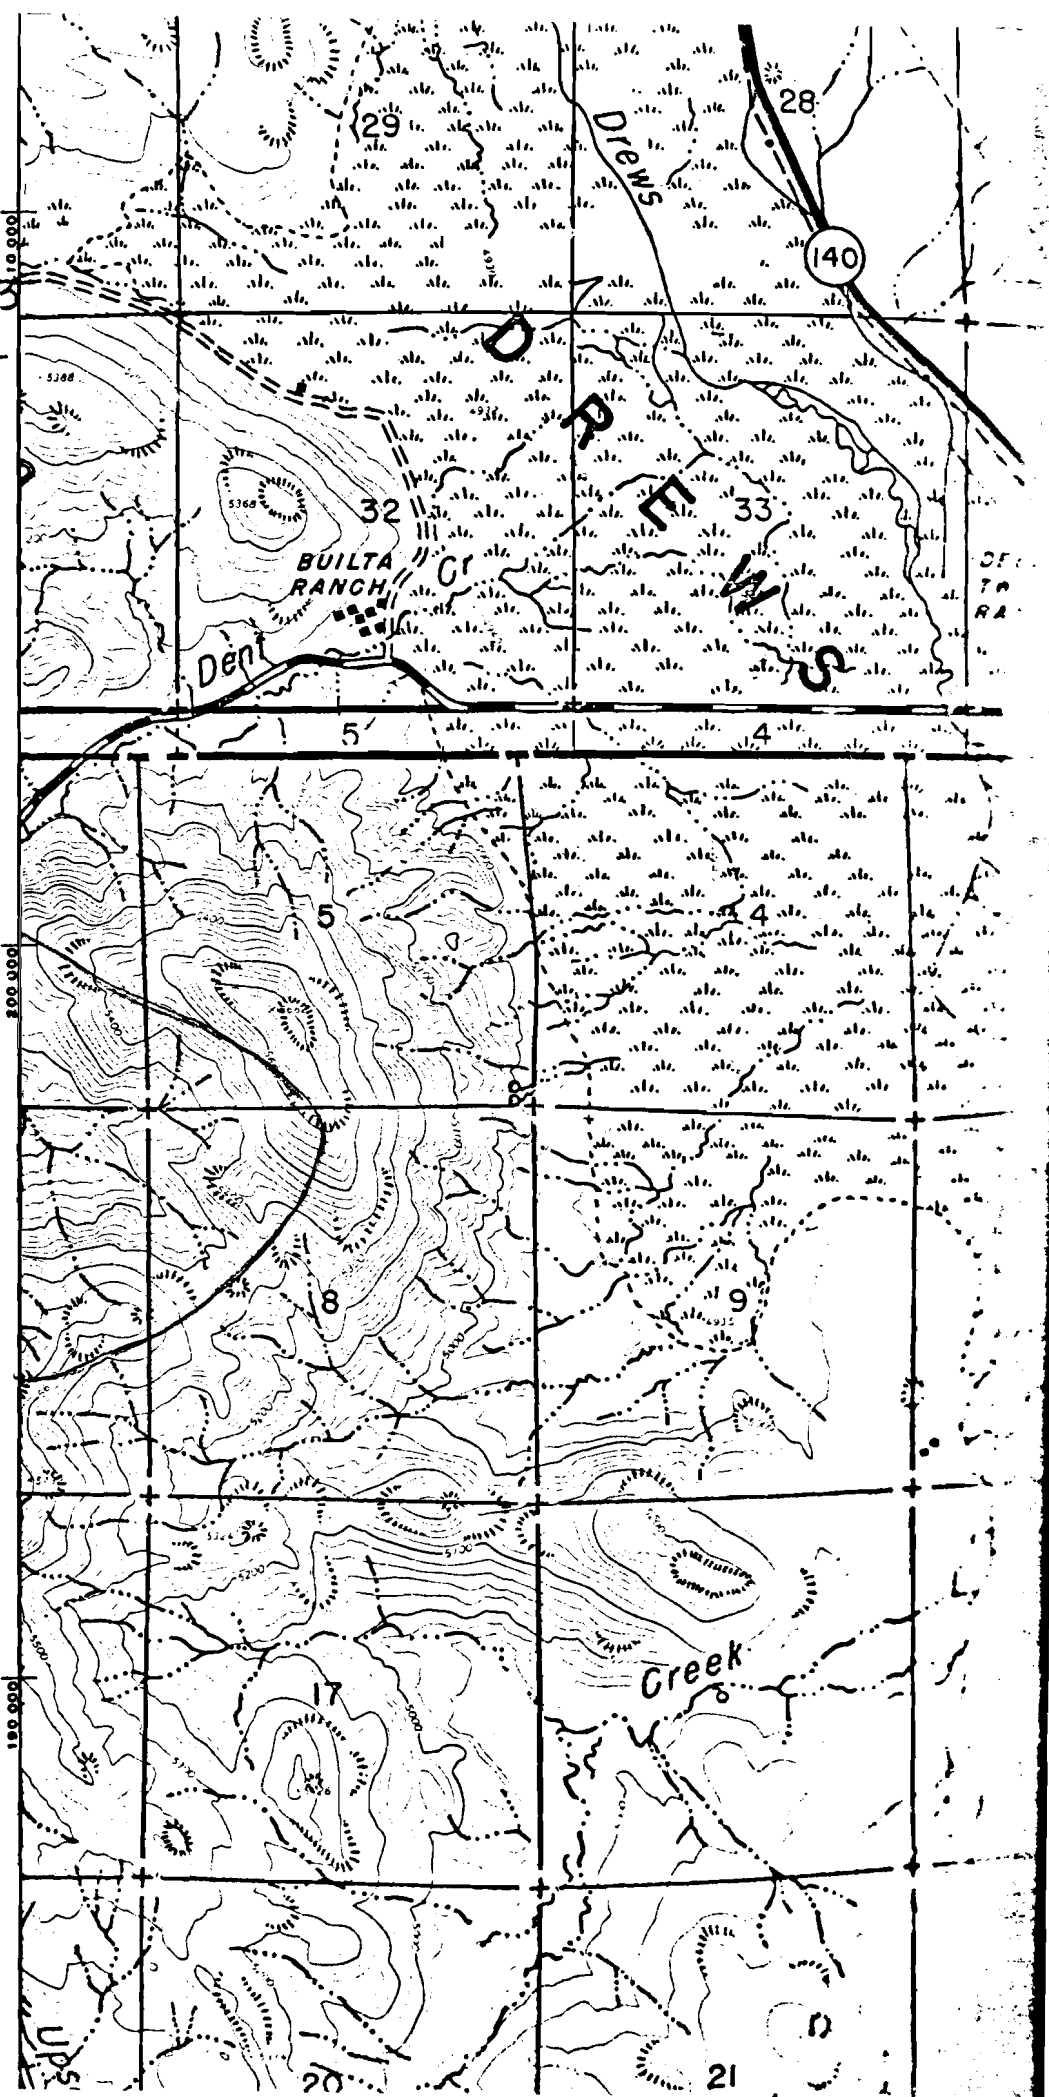

RECEIVED


AUG 19 1981

WATER RESOURCES DEPT
SALEM, OREGON

49 17 7

Application No. R-62533
Permit No. R 9131

T.38 1/2 S.

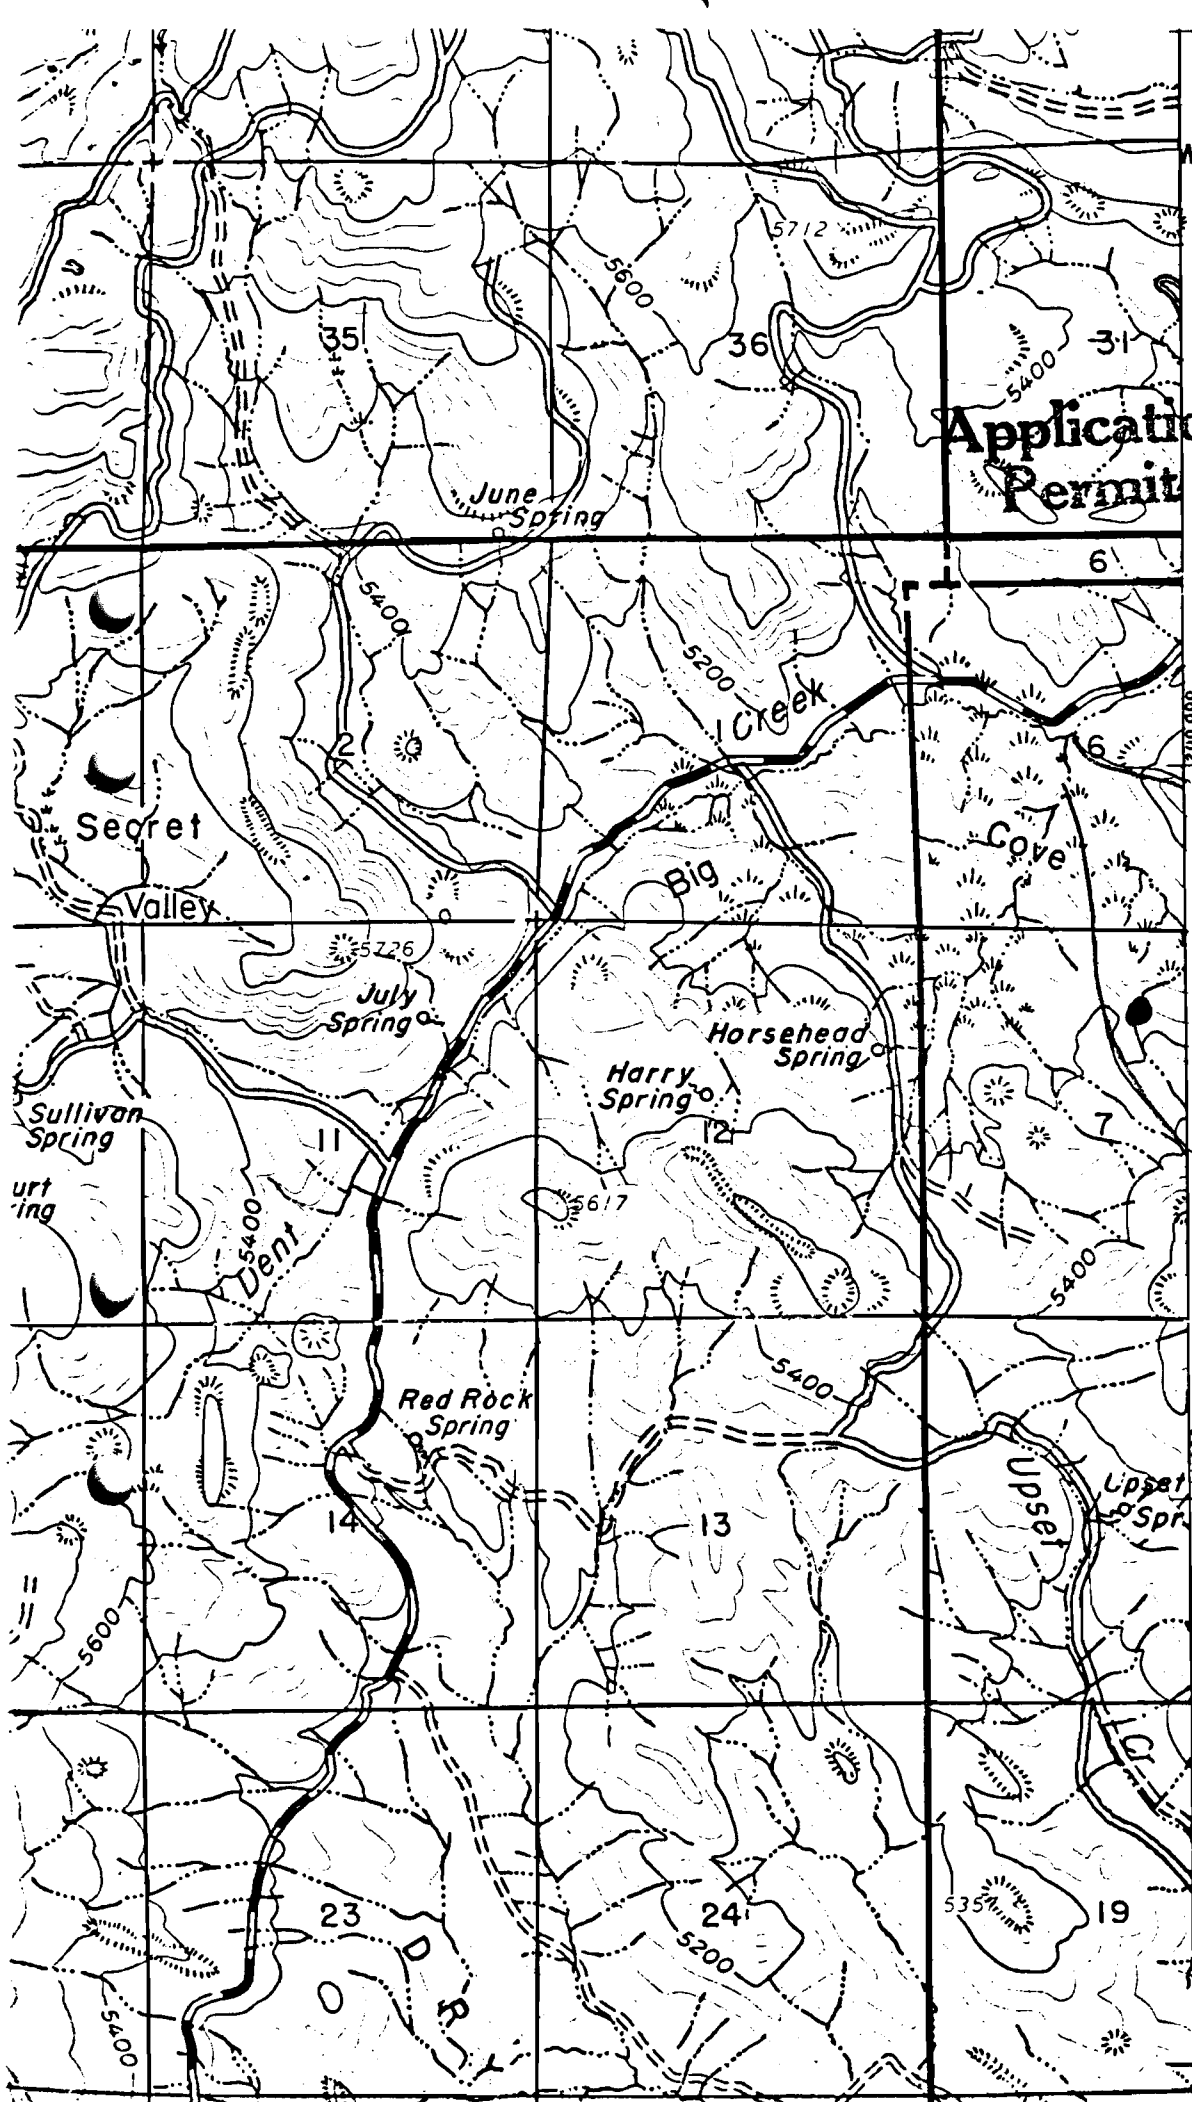

T.39 S.

10'